


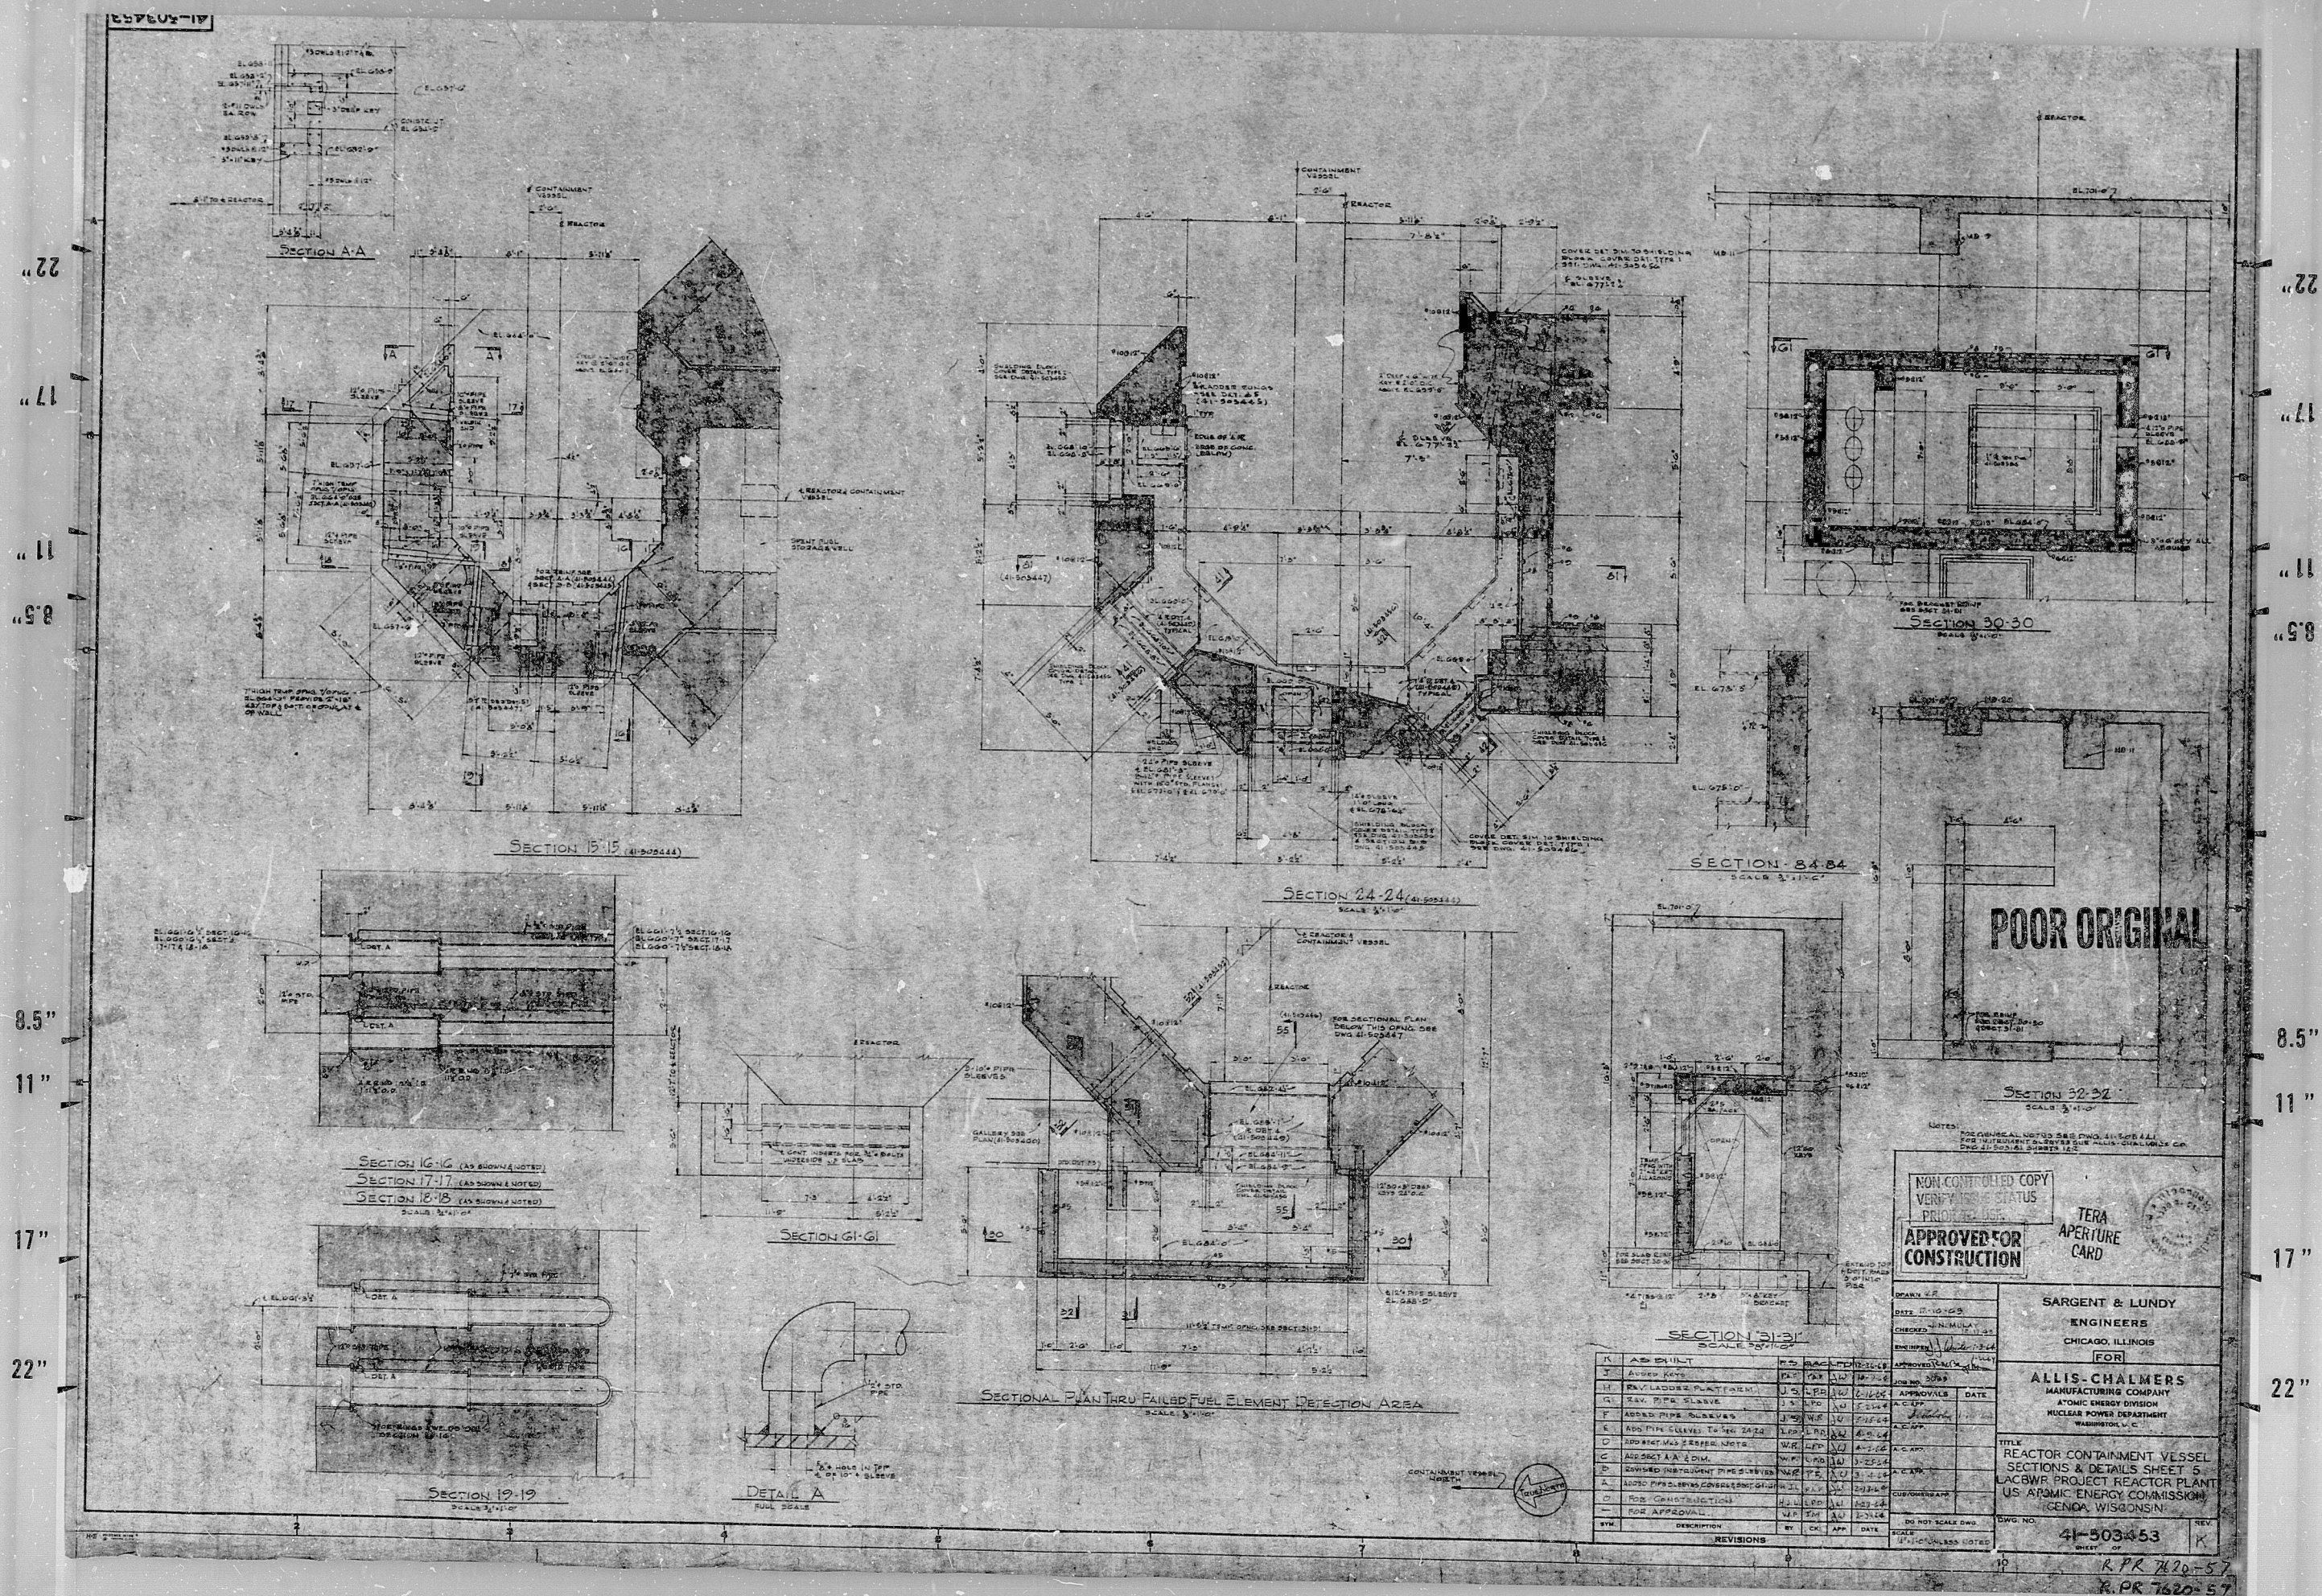

BIDS

8110020182

