

11

11

8.5

8.5

11

17

11


11

8.5

8.5

11

17

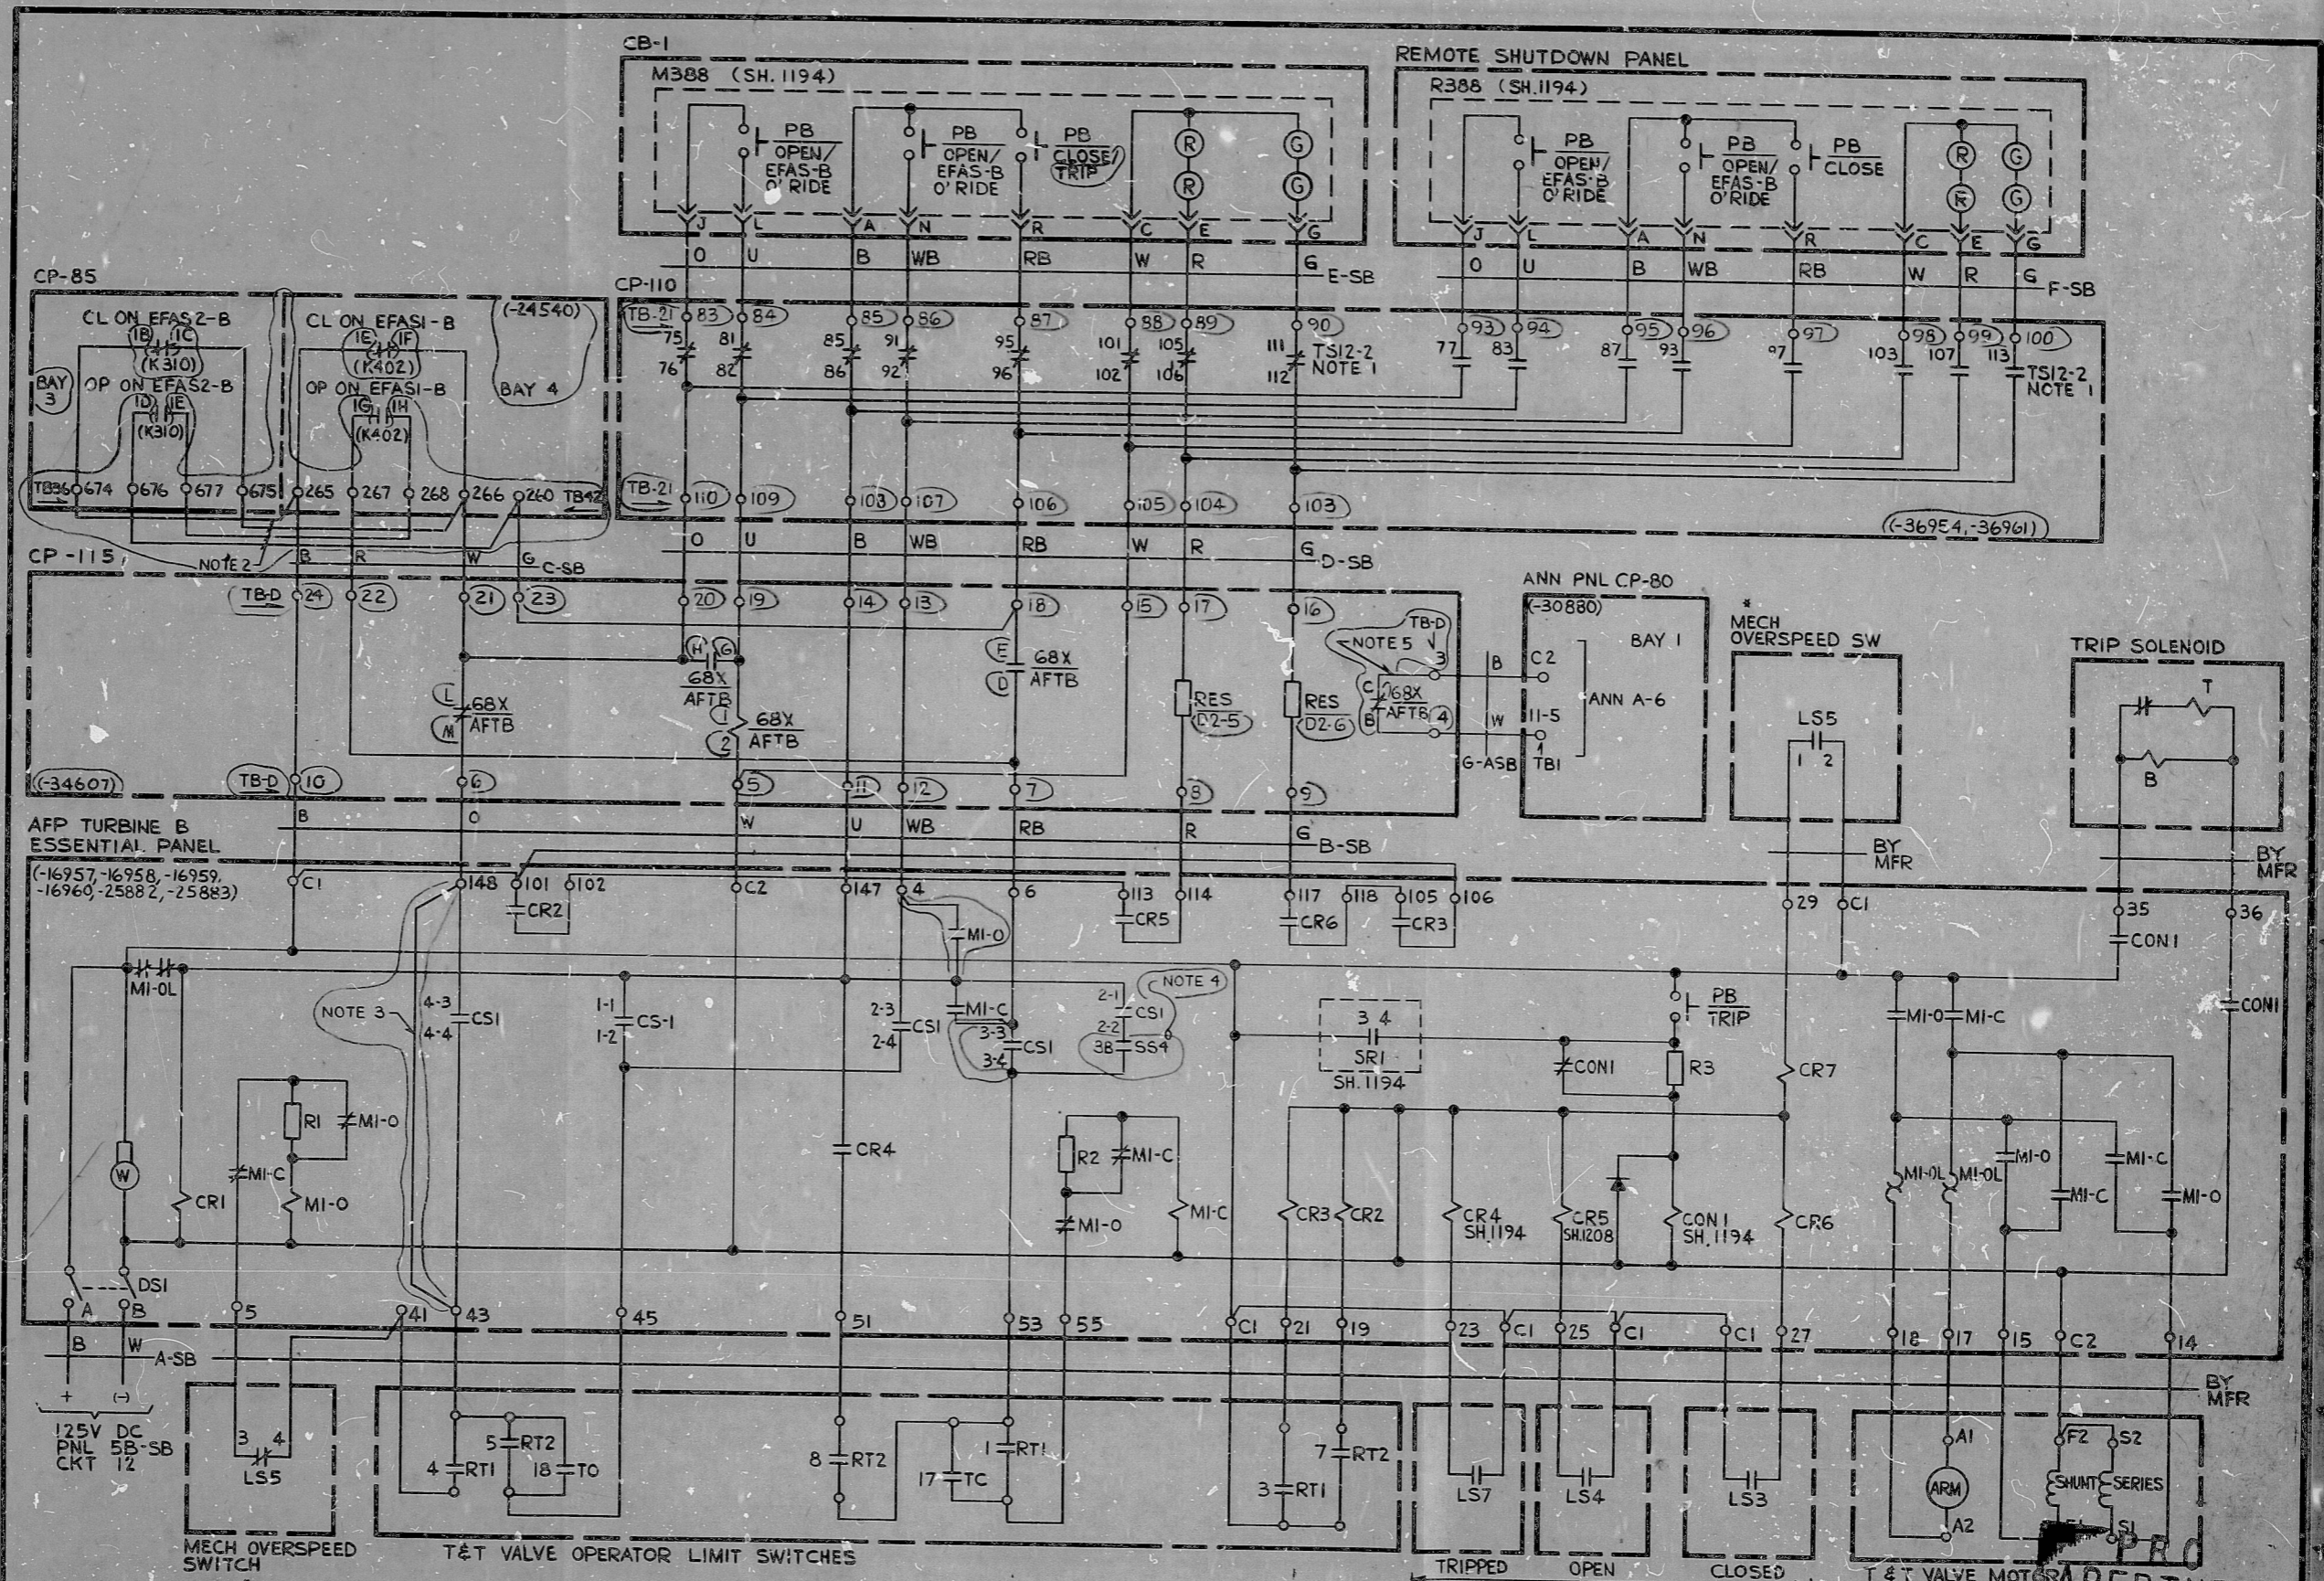

- NOTES**
- FOR TS TRANSFER SWITCH DEVELOPMENT SEE SH. 2112.
 - INTERBAY WIRING TO BE ROUTED IN METALLIC CONDUIT & SEALED WITH FIREPROOF MATERIAL BY FIELD.
 - FIELD TO ADD JUMPER.
 - FIELD TO WIRE CONTACT.
 - FIELD TO RECONNECT WIRE AS SHOWN.

LEGEND
 * — THIS SHEET

NUCLEAR SAFETY RELATED				WPPSS QUALITY CLASS I			
EBASCO SERVICES INCORPORATED				WASHINGTON PUBLIC POWER SUPPLY SYSTEM			
DIV. CONTROL DR. C. KIM CH. A. RAO				NUCLEAR PROJECTS NO. 3 & 5, CONTROL WIRING DIAGRAM, TURB DRIVEN AUX FDW PUMP B T & T VALVE			
DATE APRIL 22, 1980				WPPS-3240 D-6001 SHEET 1193			

RIDS

8303160130

