


DIESEL GEN B-SB
CNTRL PNL (CUB 1)

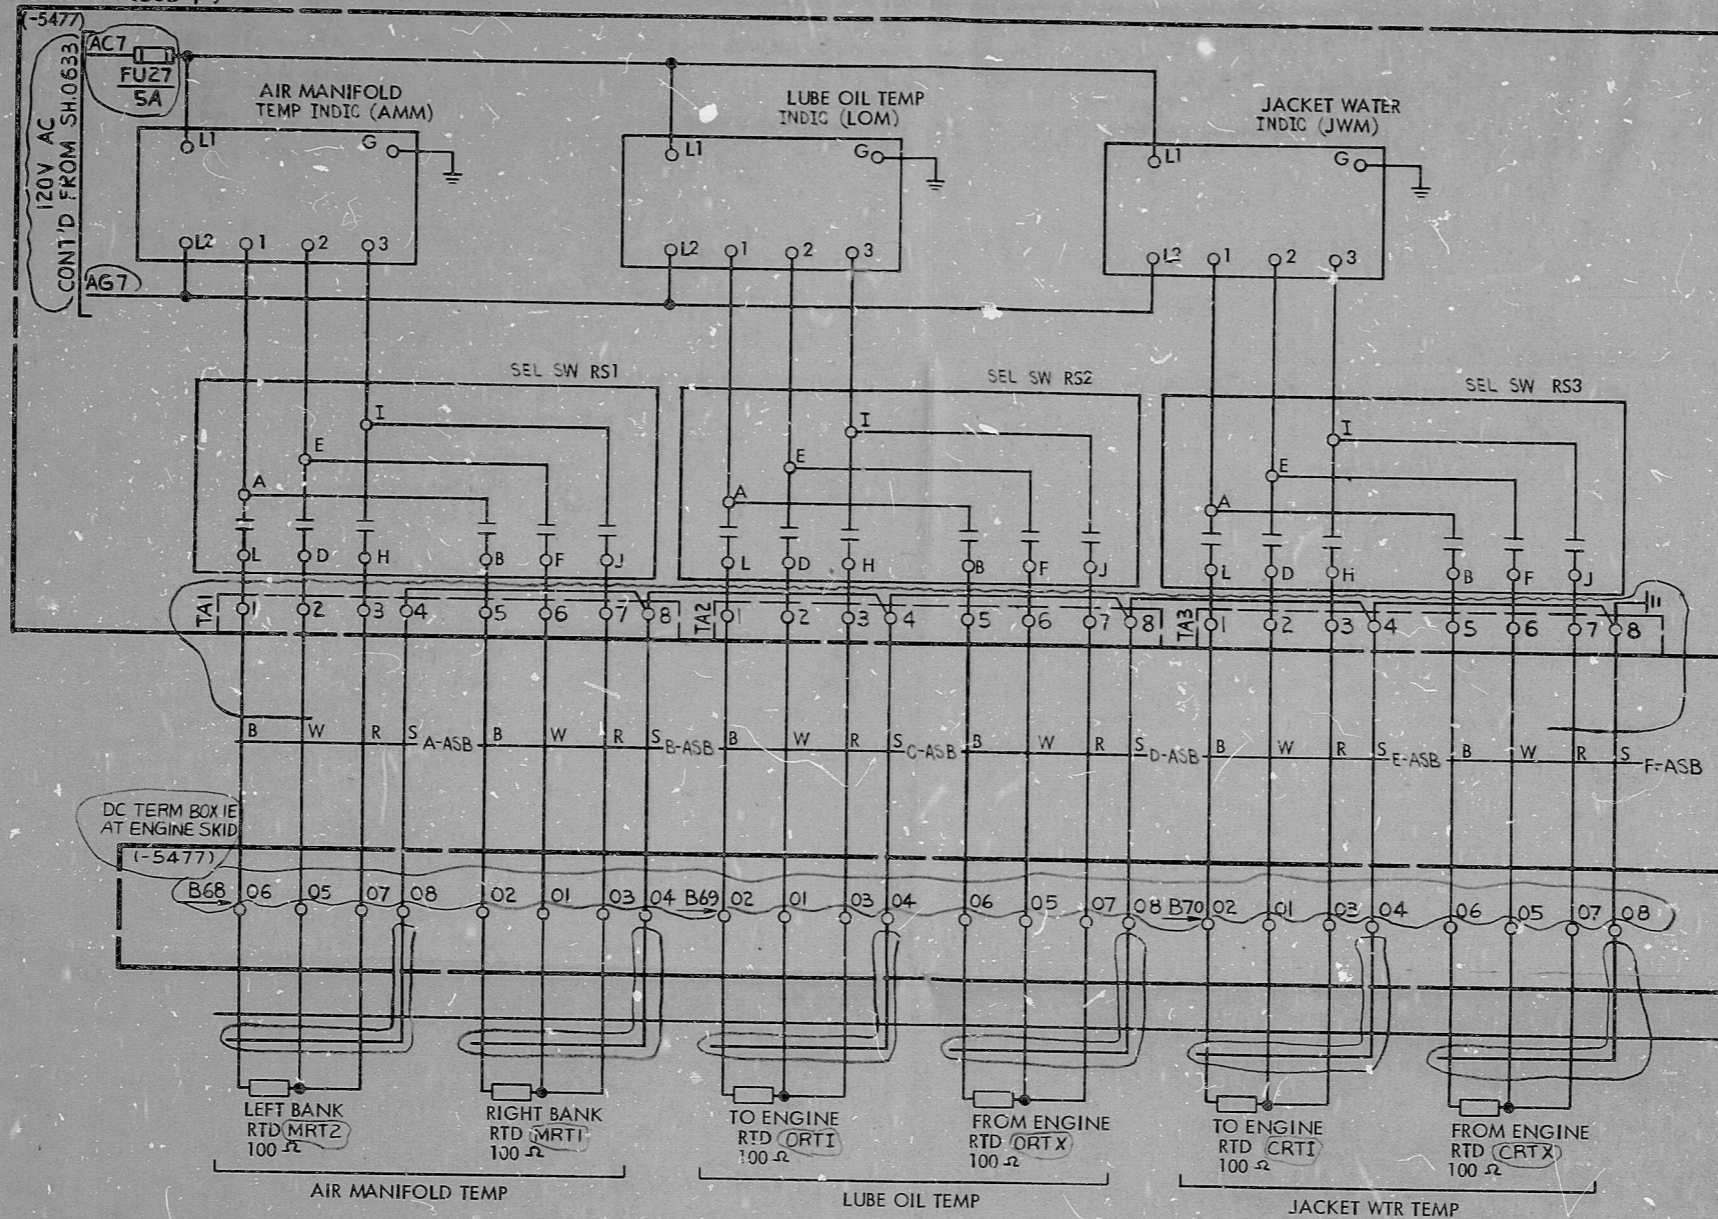

PRC
APERTURE
CARD

NUCLEAR SAFETY RELATED WPPSS QUALITY CLASS I

5									
4									
3									
2									
1	9-7-79	REV	AS	CD	WSP				
REV	DATE	BY	APPROVED	EBASCO SERVICES INCORPORATED		WASHINGTON PUBLIC POWER SUPPLY SYSTEM		WPPS-3240	
				DIV. CONTROL DR. RK		NUCLEAR PROJECTS NO. 3 & 5		D-6001	
				CH. V. ALKSNINIS		CONTROL WIRING DIAGRAM		SHEET 0634	
				DATE MAR. 21, 1978		EMERGENCY DIESEL ENGINE B-SB			
						TEMPERATURE			

K012 10 1253 11-74 48933

RIDS

8303160/82

