


INDIVIDUAL CYLINDER EXHAUST TEMPERATURE

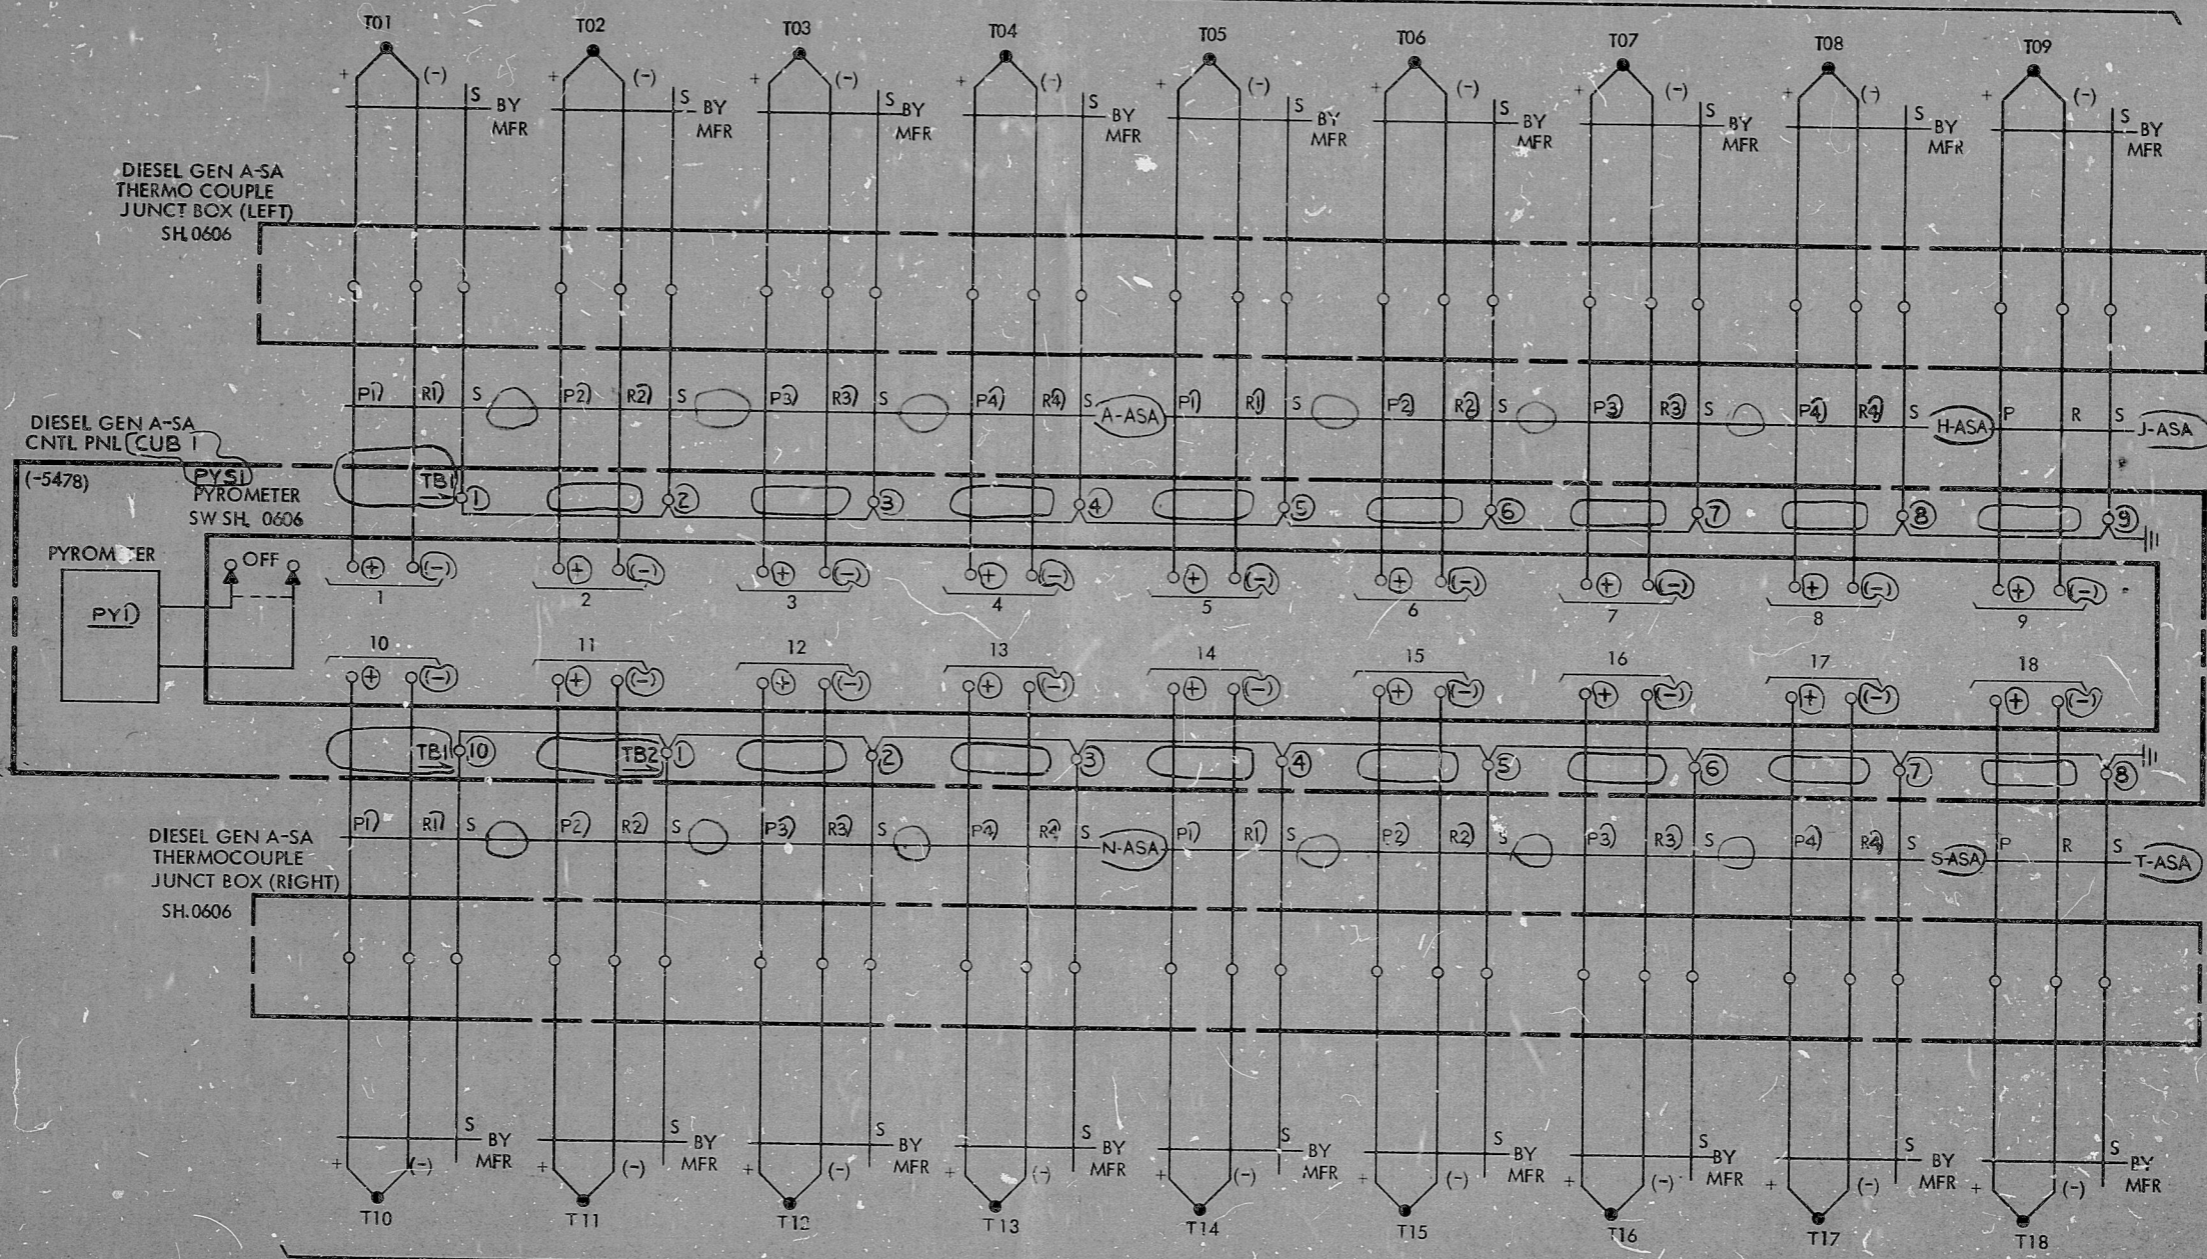

INDIVIDUAL CYLINDER EXHAUST TEMPERATURE

PRC
APERTURE
CARD

NUCLEAR SAFETY RELATED WPPSS QUALITY CLASS I

| | | | | | | | | |
|-----|--------|-----|----------|------------------------------|----|---------------------------------------|--|------------|
| 5 | | | | | | | | |
| 4 | | | | | | | | |
| 3 | | | | | | | | |
| 2 | | | | | | | | |
| 1 | 9-7-79 | MEM | AR | NA | CD | 231 | | |
| REV | DATE | BY | APPROVED | EBASCO SERVICES INCORPORATED | | WASHINGTON PUBLIC POWER SUPPLY SYSTEM | | WPPS-3240 |
| | | | | DIV. CONTROL DR. HSM | | NUCLEAR PROJECTS NO. 3 & 5 | | D-6001 |
| | | | | CH. VALKSNINIS | | EMER DIESEL GENERATOR A-SA | | SHEET 0603 |
| | | | | DATE AUG 15, 1978 | | THERMOCOUPLES SH.1 | | |

RIDS

8303160245

