


DIESEL GEN A-SA
CNTRL PNL (CUB 1)

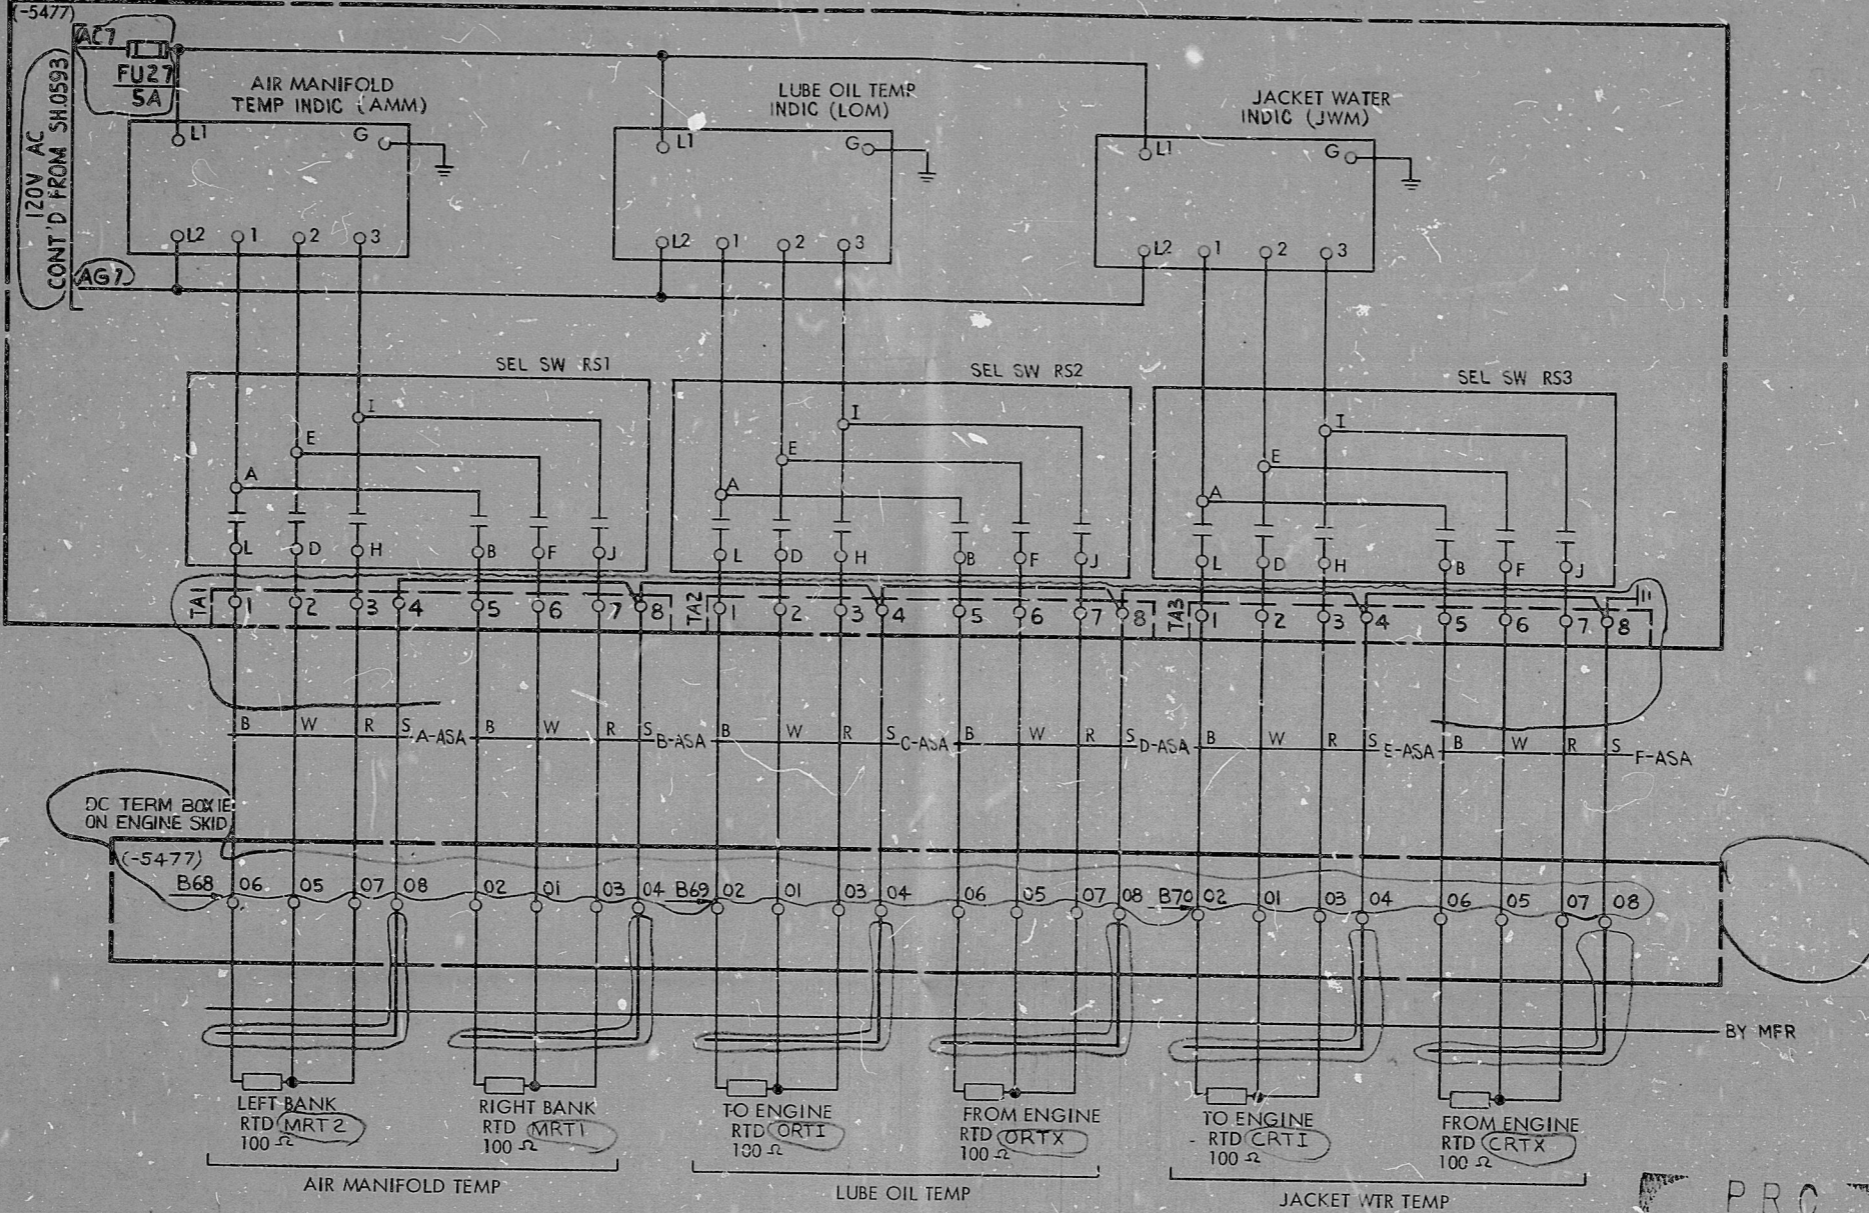

PRO APERTURE CARD

NUCLEAR SAFETY RELATED WPPSS QUALITY CLASS I

5							
4							
3							
2							
1	9-7-79	HSM	V.A.	CD	123		
REV	DATE	BY	APPROVED	EBASCO SERVICES INCORPORATED DIV. CONTROL DR. RK CH. V. ALKSNINIS DATE MAR 21, 1978		WASHINGTON PUBLIC POWER SUPPLY SYSTEM NUCLEAR PROJECTS NO. 3 & 5 CONTROL WIRING DIAGRAM EMERGENCY DIESEL ENGINE A-SA TEMPERATURE	
						APPROVED <i>[Signature]</i>	WPPS-3240 D-6001 SHEET 0594

MADE TO 1252 11-74 40933

RIDS

8303160259

