
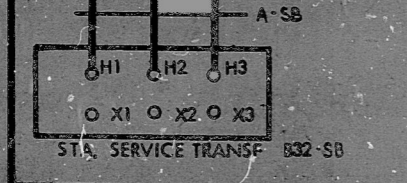
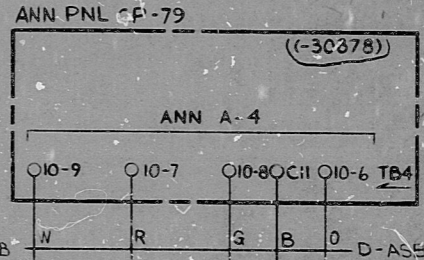


CS-1

CONTACT	POSITION FRONT VIEW			CWD
	OPEN	NORM	CLOSE	
1	X			*
2		X		
3			X	*
4		X		

SPRING RETURN TO NORMAL  
\* THIS SHEET

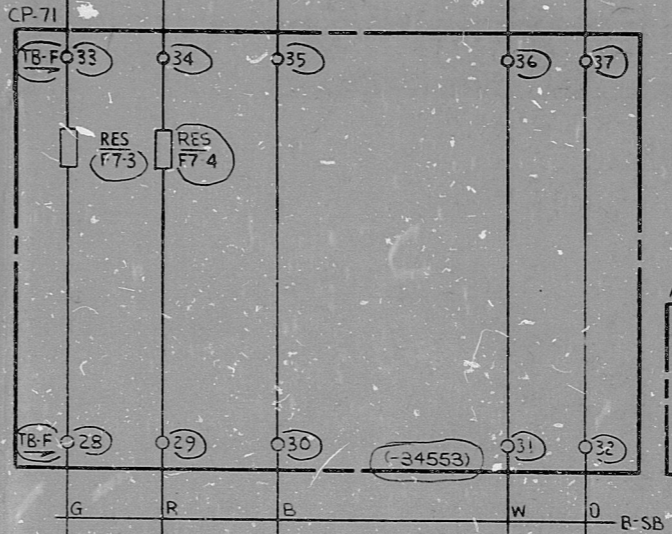

**PRC APERTURE CARD**  
(-20431, -20433, -28680)

NOTE  
FOR DEVELOPMENT OF SWITCHES  
'CS-2', 'CST + TS' SEE SH 0399

REV.	DATE	BY	APPROVED
5			
4			
3	5-12-82	V.A.	
2	7-16-81	RJP	
1	12-22-79	V.A.	

**EBASCO SERVICES INCORPORATED**  
DIV. CONTROL DR. KKM  
CH. M. SHEVADE  
DATE APR. 23, 1976

**NUCLEAR SAFETY RELATED**    **WPPSS QUALITY CLASS I**  
APPROVED  
*[Signature]*  
LOW LINE

WASHINGTON PUBLIC POWER  
SUPPLY SYSTEM  
NUCLEAR PROJECTS NO. 3 & 5  
CONTROL WIRING DIAGRAM  
POWER CENTER 3315B FEEDER BREAKER

WPPSS-3240  
D-6001  
SHEET 0430

RIDS

8303160493

