
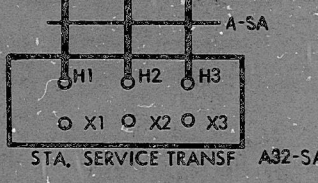
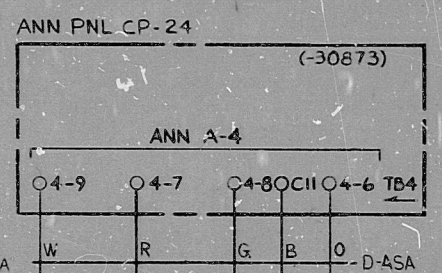


CONTACT	POSITION FRONT VIEW			CWD
	OPEN	NORM	CLOSE	
1	X			*
2		X		
3			X	*
4		X		

SPRING RETURN TO NORMAL \* THIS SHEET


NOTE

1. FOR DEVELOPMENT OF SWITCHES 'CS-2', 'CST' & 'TS' SEE SH. 0399.

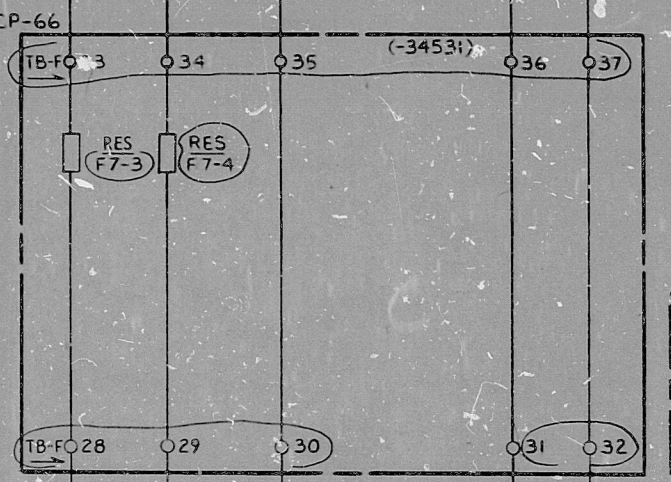

4.16KV SWGR A3-SA CUB.13

(-20431, -20433, -28677)

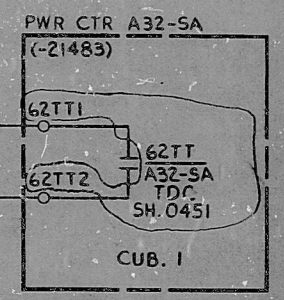

NUCLEAR SAFETY RELATED WPPSS QUALITY CLASS I

3 10-7-81 RJP V.A. [Signature] 4 4-28-81 RJP V.A. [Signature] 5 6-12-80 RJP V.A. [Signature]			<b>EBASCO SERVICES INCORPORATED</b> DIV. CONTROL DR. W.K.M. CH. M. SHEVADE DATE APR. 23, 1976		APPROVED [Signature] WPPSS		WASHINGTON PUBLIC POWER SUPPLY SYSTEM NUCLEAR PROJECTS NO. 3 & 5 CONTROL WIRING DIAGRAM POWER CENTER A32-SA FEEDER BREAKER		WPPS-3240 D-6001 SHEET 0400	
--	--	--	--	--	----------------------------------	--	---	--	-----------------------------------	--



**RIDS**

8303160523

