



| CS-2, CST | | POSITION FRONT VIEW | | | CWD |
|-----------|---------|---------------------|------|-------|-----|
| CONTACT | | OPEN | NORM | CLOSE | |
| DECK 1 | A11-B11 | X | | | * |
| | A12-B12 | | X | | |
| | A1-B1 | | | X | * |
| | A5-B5 | X | | | |
| | A6-B6 | | X | | |
| DECK 2 | A7-B7 | | | X | |
| | C11-D11 | X | | | |
| | C12-D12 | | X | | |
| | C1-D1 | | | X | |
| | C5-D5 | X | | | |
| C6-D6 | | X | | | |
| C7-D7 | | | X | | |

SPRING RETURN TO NORMAL
 * — THIS SHEET
 CST HAS ONE DECK ONLY.

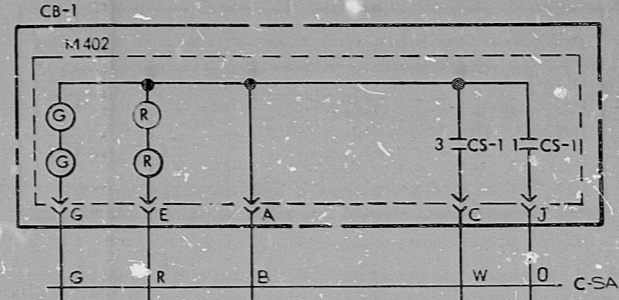


| CS-1 | | POSITION FRONT VIEW | | | CWD |
|---------|---|---------------------|------|-------|-----|
| CONTACT | | OPEN | NORM | CLOSE | |
| CONTACT | 1 | X | | | * |
| | 2 | | X | | |
| | 3 | | | X | * |
| | 4 | | X | | |


SPRING RETURN TO NORMAL

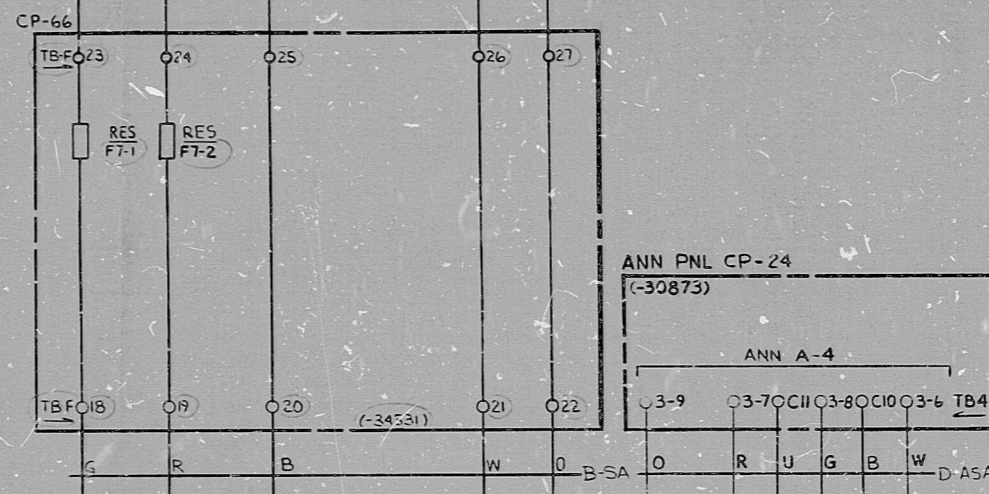

| TS | | POSITION FRONT VIEW | | | CWD |
|---------|---------|---------------------|-----|---|-----|
| CONTACT | | LOCAL | REM | | |
| CONTACT | A11-E11 | | X | * | |
| | A12-E12 | X | | * | |
| | A1-E1 | | X | * | |
| | A5-B5 | | X | * | |
| | A6-B6 | X | | * | |
| | A7-B7 | | X | * | |
| | C11-D11 | | X | * | |
| | C12-D12 | X | | * | |
| | C1-D1 | | X | * | |
| | C5-D5 | | X | * | |
| | C6-D6 | X | | * | |
| | C7-D7 | | X | * | |
| | E11-F11 | X | | * | |
| | E12-F12 | | X | * | |
| | E5-F5 | X | | * | |
| E6-F6 | | X | * | | |
| E7-F7 | X | | * | | |
| G11-H11 | X | | * | | |
| G12-H12 | | X | * | | |
| G1-H1 | X | | * | | |
| G5-H5 | X | | * | | |
| G6-H6 | | X | * | | |
| G7-H7 | X | | * | | |

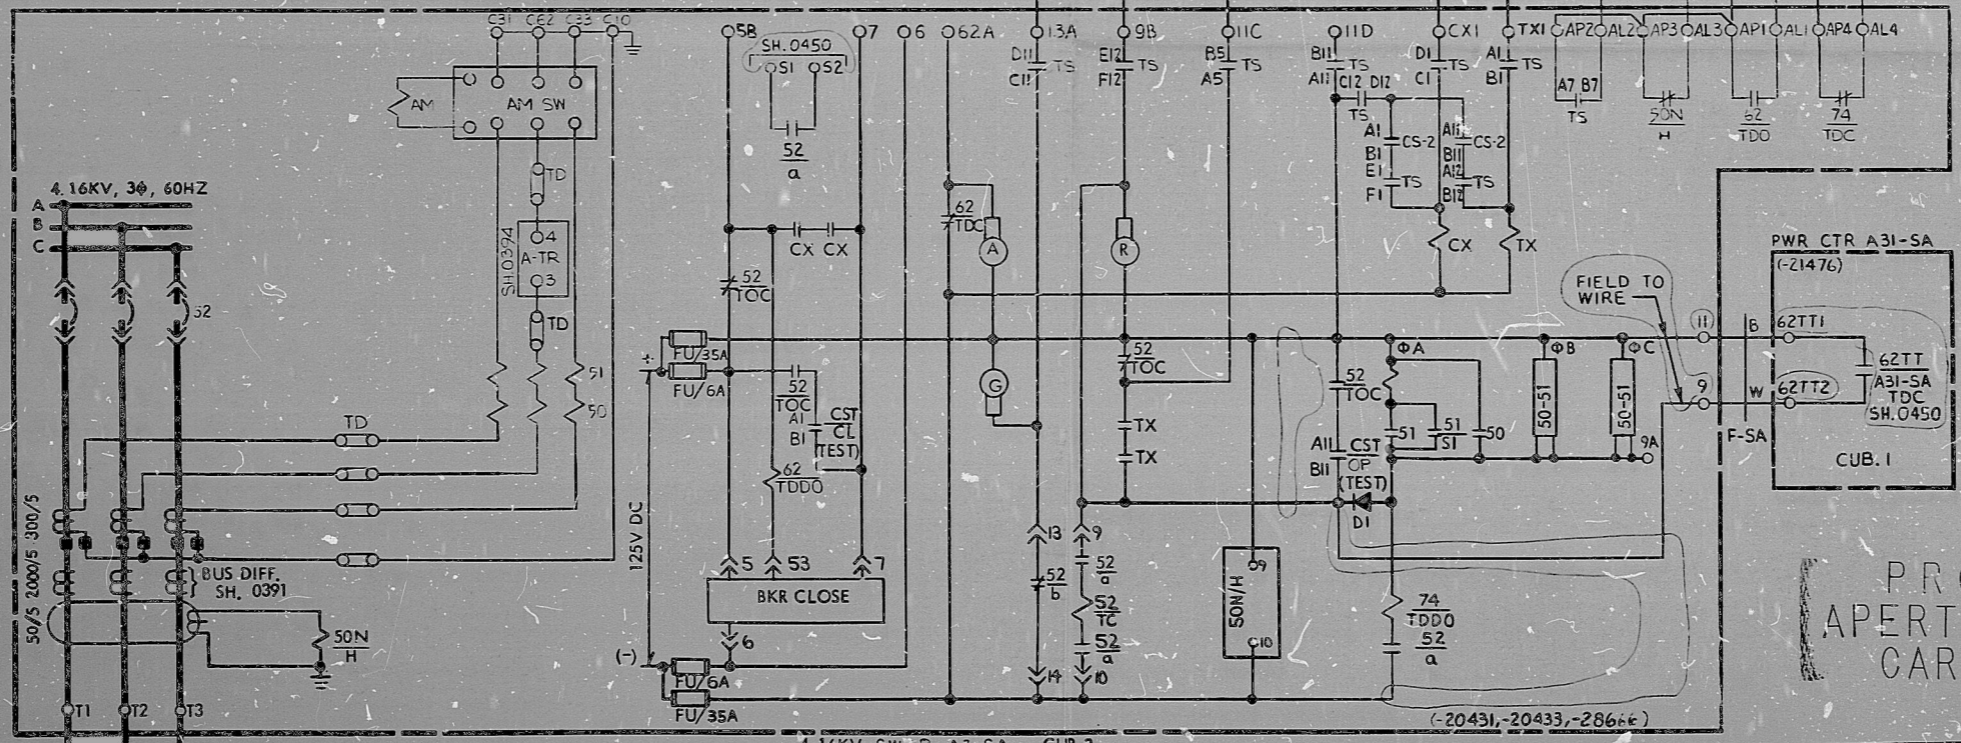

PRO MAINTAINED CONTACTS
 APERTURE CARD

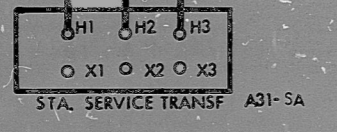

| | | | |
|------------------------------|---------|----------|----------|
| EDASCO SERVICES INCORPORATED | | | |
| REV | DATE | BY | APPROVED |
| 3 | 10-7-81 | RVP | VN |
| 4 | 4-23-81 | RVP | VN |
| 5 | 6-12-80 | RVP | VN |
| DATE APR. 23, 1976 | | APPROVED | |

WASHINGTON PUBLIC POWER SUPPLY SYSTEM
 NUCLEAR PROJECTS NO. 3 & 5
 CONTROL WIRING DIAGRAM
 POWER CENTER A31-SAFEEDER BREAKER

WPPS-3240
 D-6001
 SHEET 0399

6.1
 6.5
 6.5
 6.5
 11
 17

RIDS

8303/60525

