



This drawing and the data it contains are the property of BECHTEL. They are hereby loaned and on the borrower's express agreement that they will not be reproduced, copied, altered, exhibited, or used except in the limited way and under the conditions specified by the lender to the borrower.

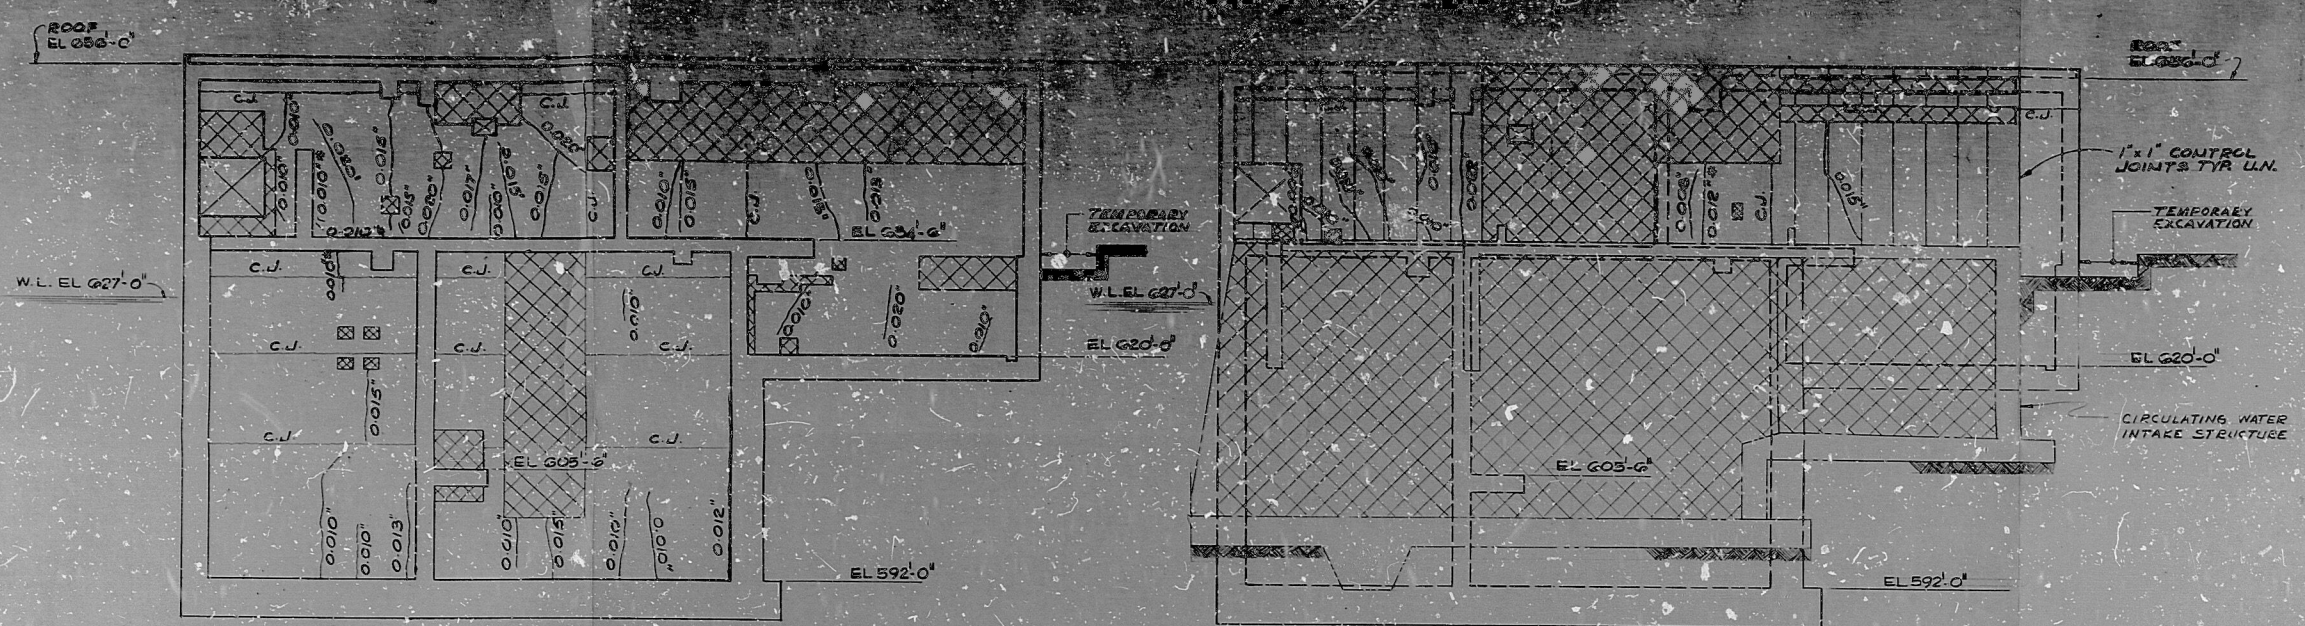


EAST FACE

WEST FACE

WEST WALL LOOKING WEST

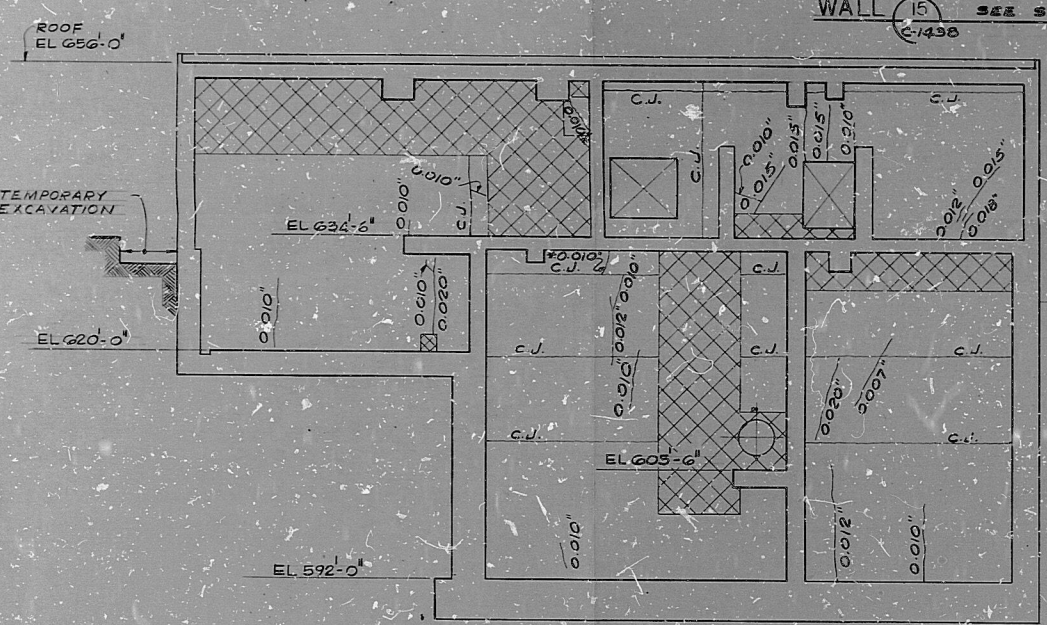

WEST FACE

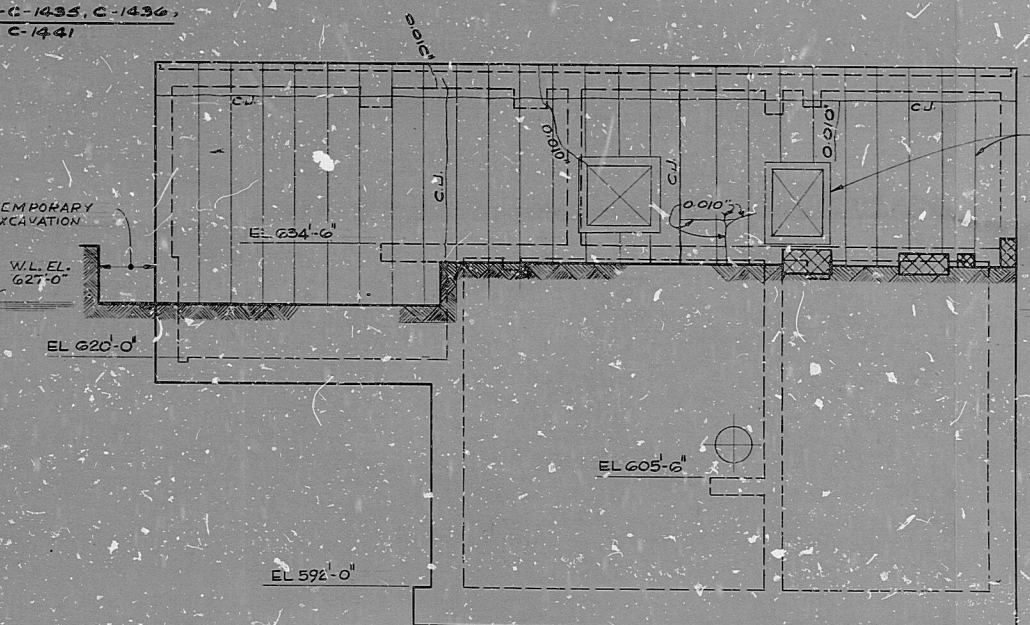

EAST FACE

EAST WALL LOOKING EAST

- NOTES
1. FOR NOTES AND LEGEND SEE SK-C-1435.
 2. FOR REFERENCE DRAWINGS SEE SK-C-1436.

FOR INFORMATION ONLY

BECHTEL ANN ARBOR, MICH.			
MIDLAND PLANT UNITS 1 & 2 CONSUMERS POWER COMPANY			
SERVICE WATER PUMP STRUCTURE CRACK SURVEY EXTERIOR WALLS EAST & WEST			
JOB NO. 7220	DRAWING NO. SK-C-1438	REV. A	SCALE 1/8" = 1'-0"
8403300203			

TI
APERTURE
CARD

PDR RIDS

8403300203

