


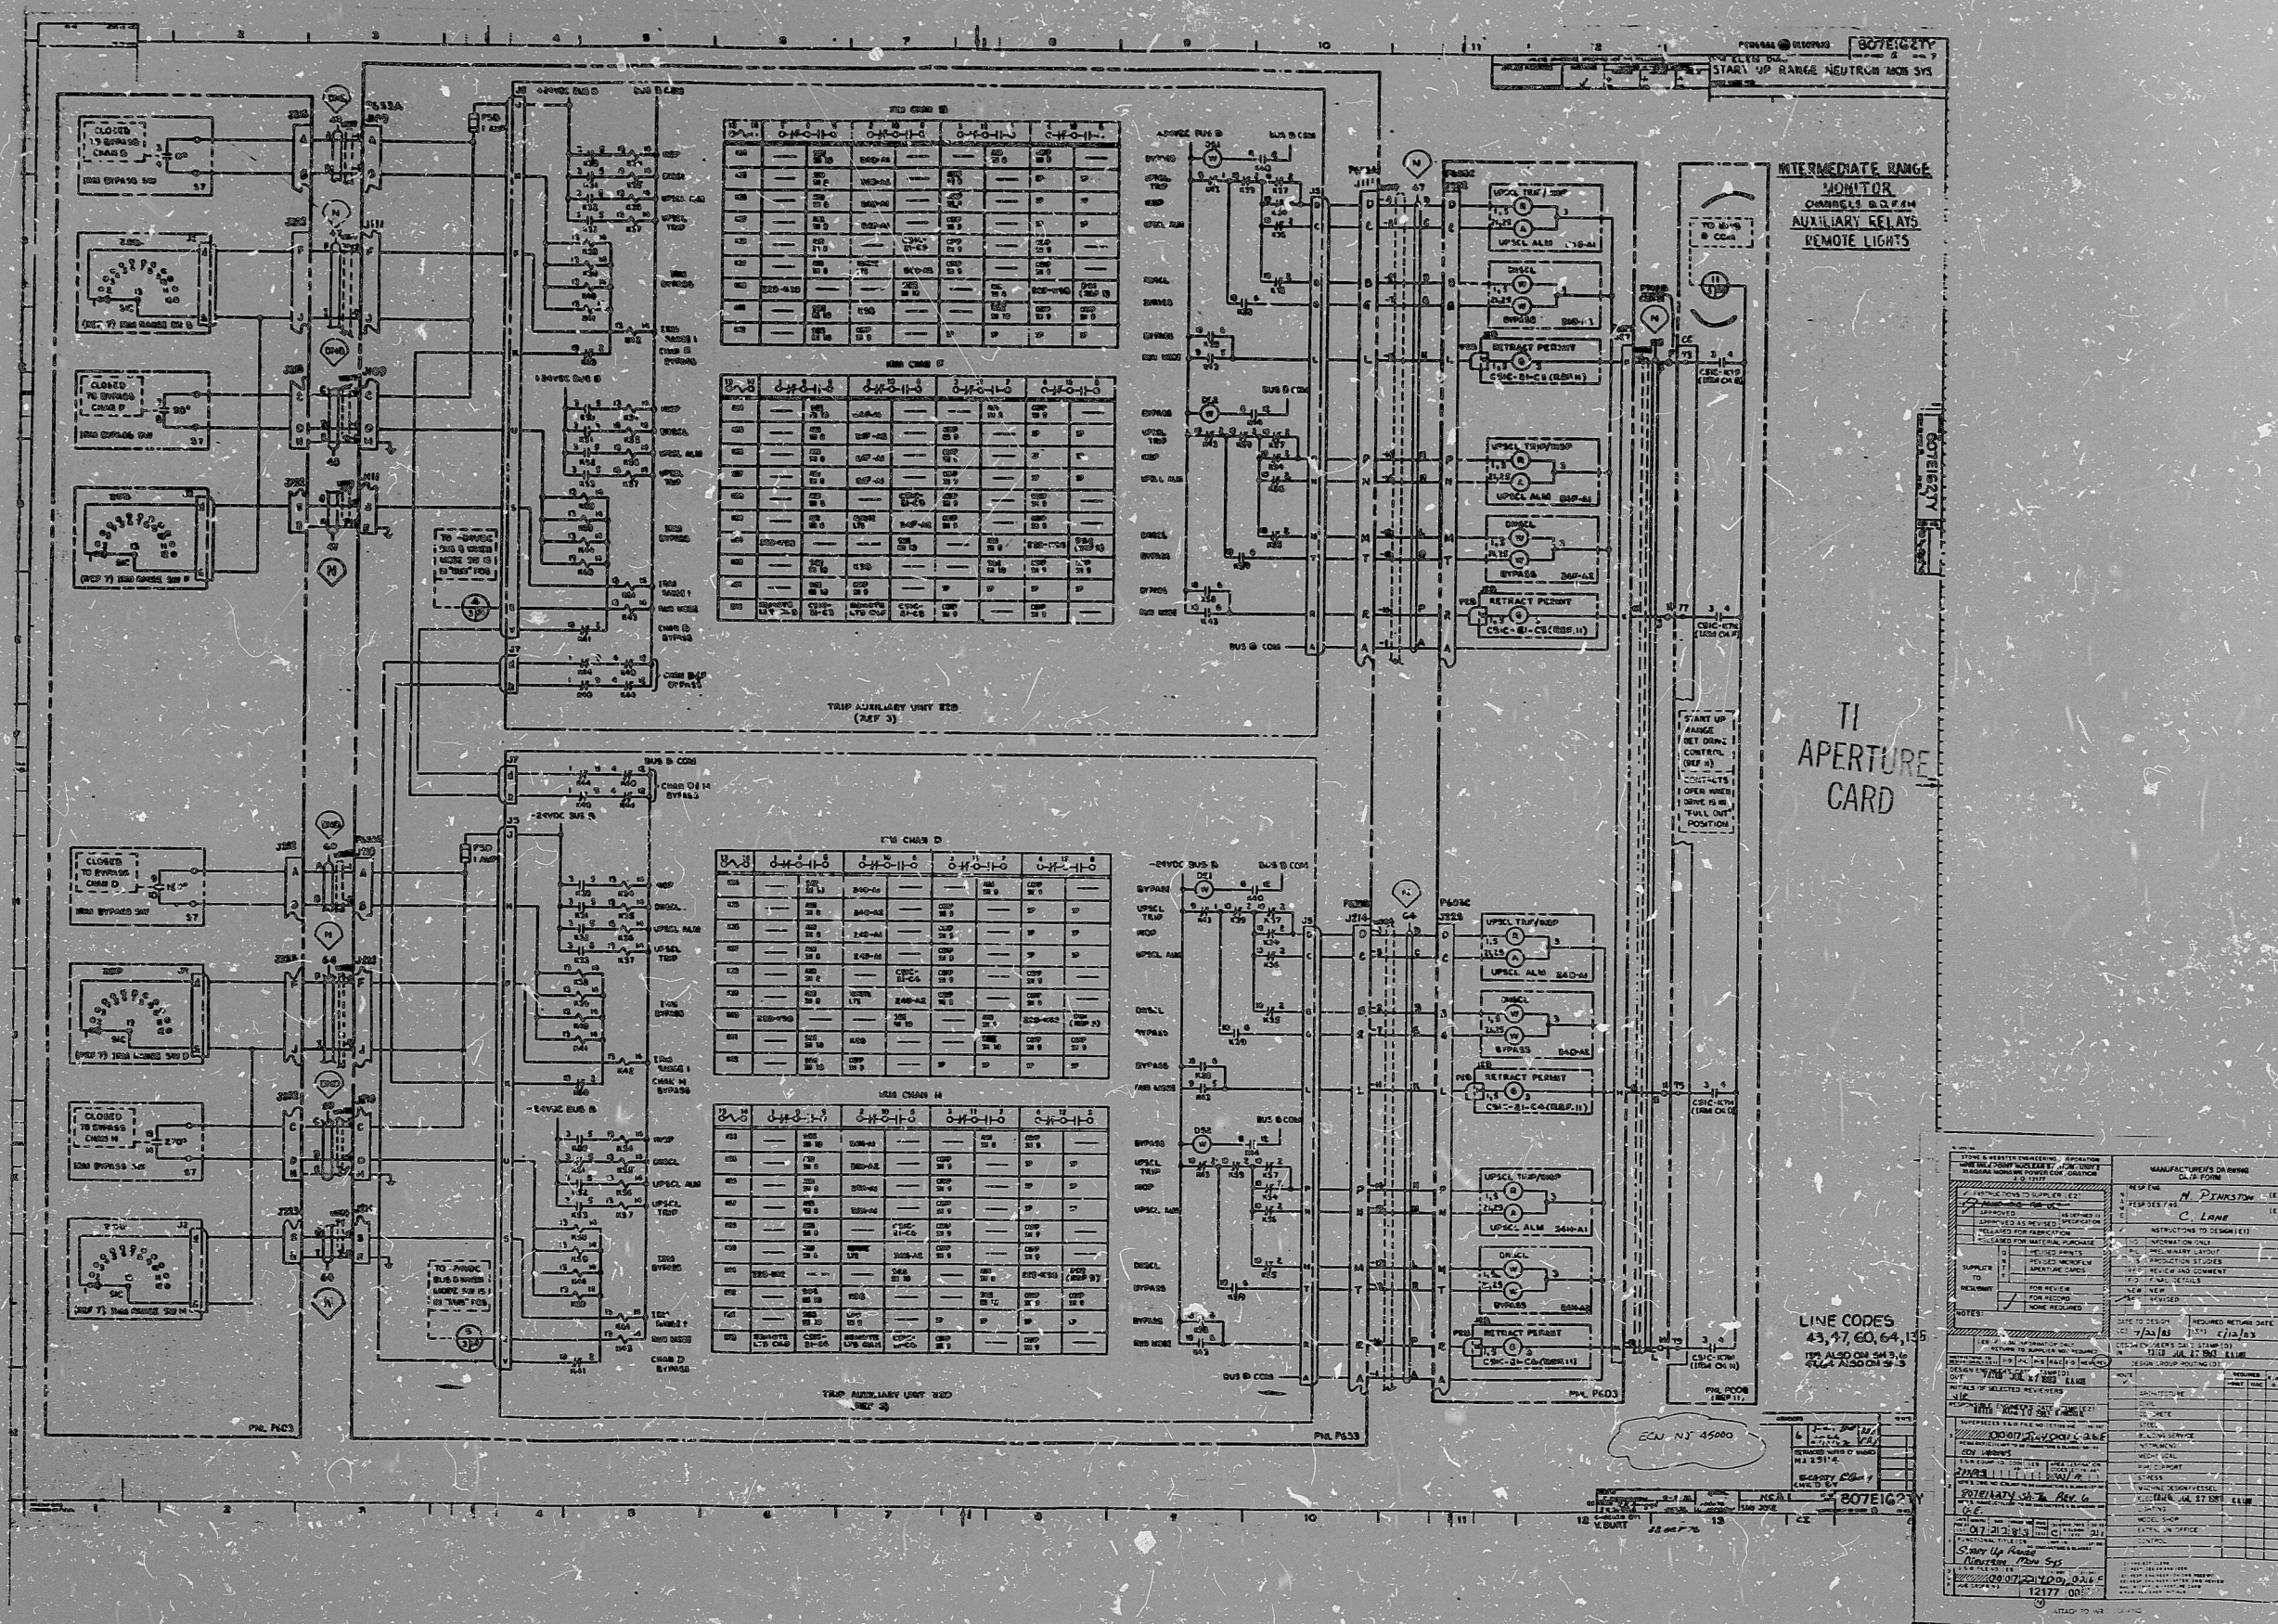



8404100291

PDR RIDS

