
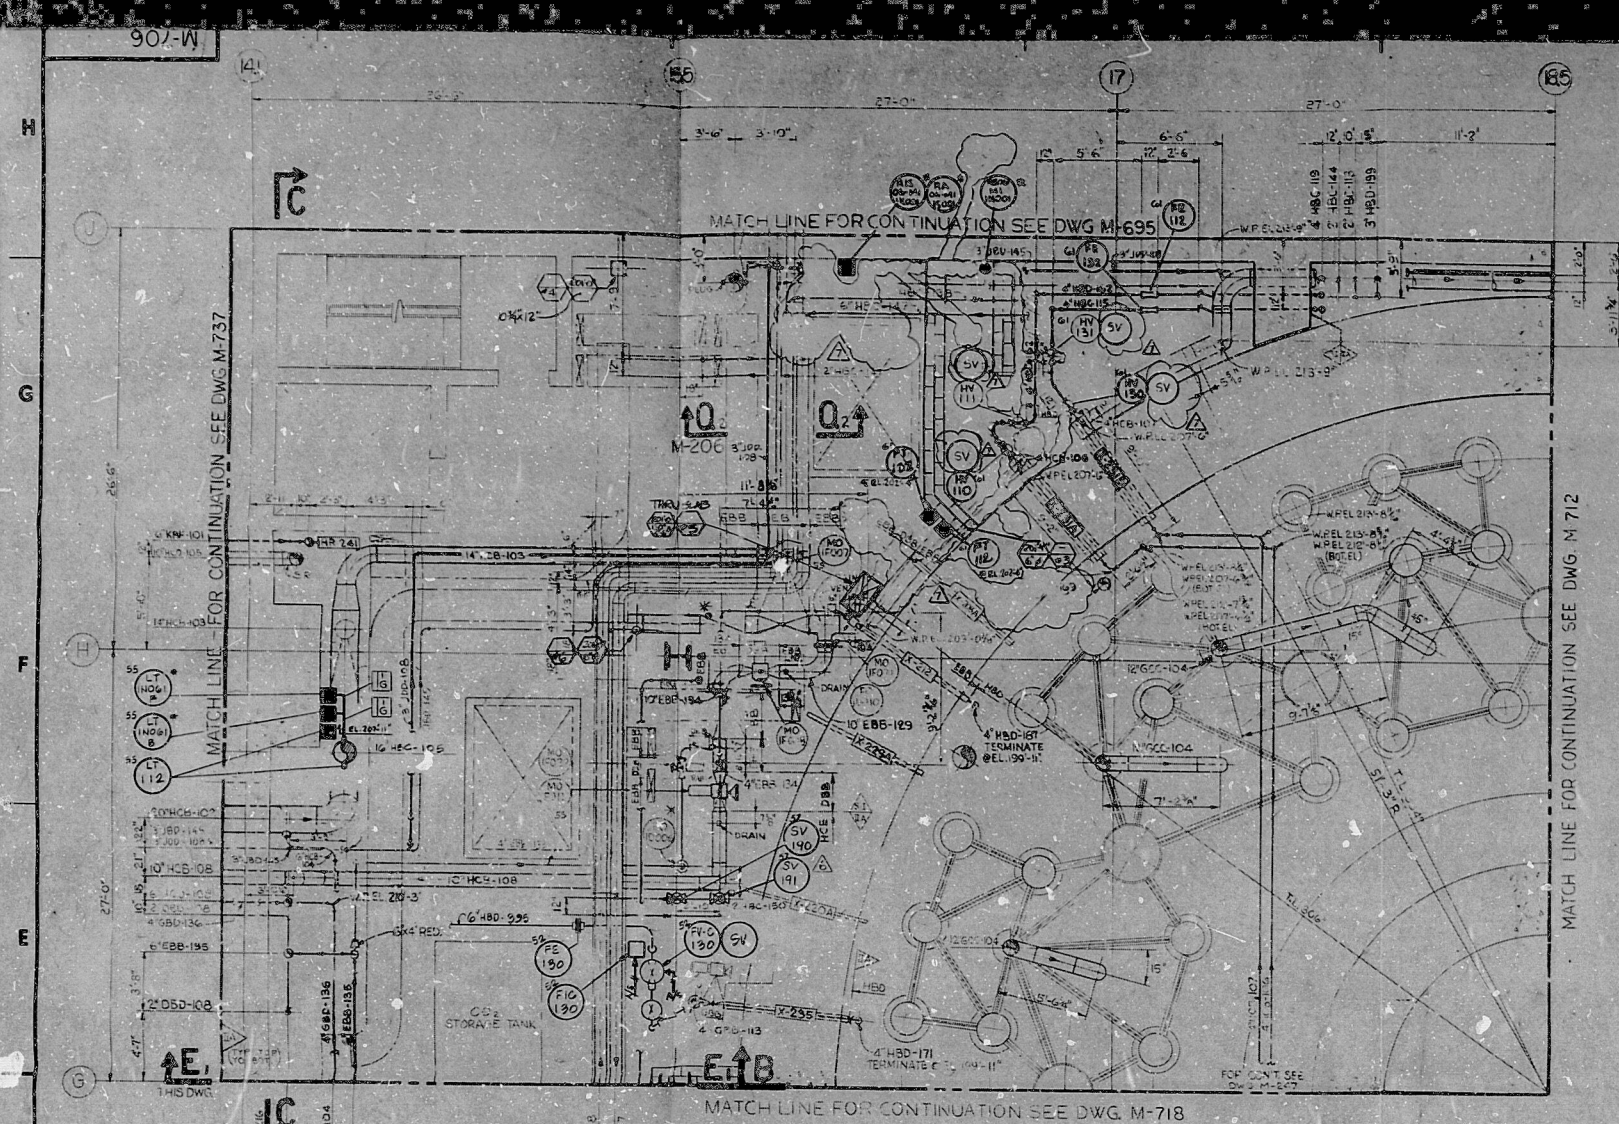
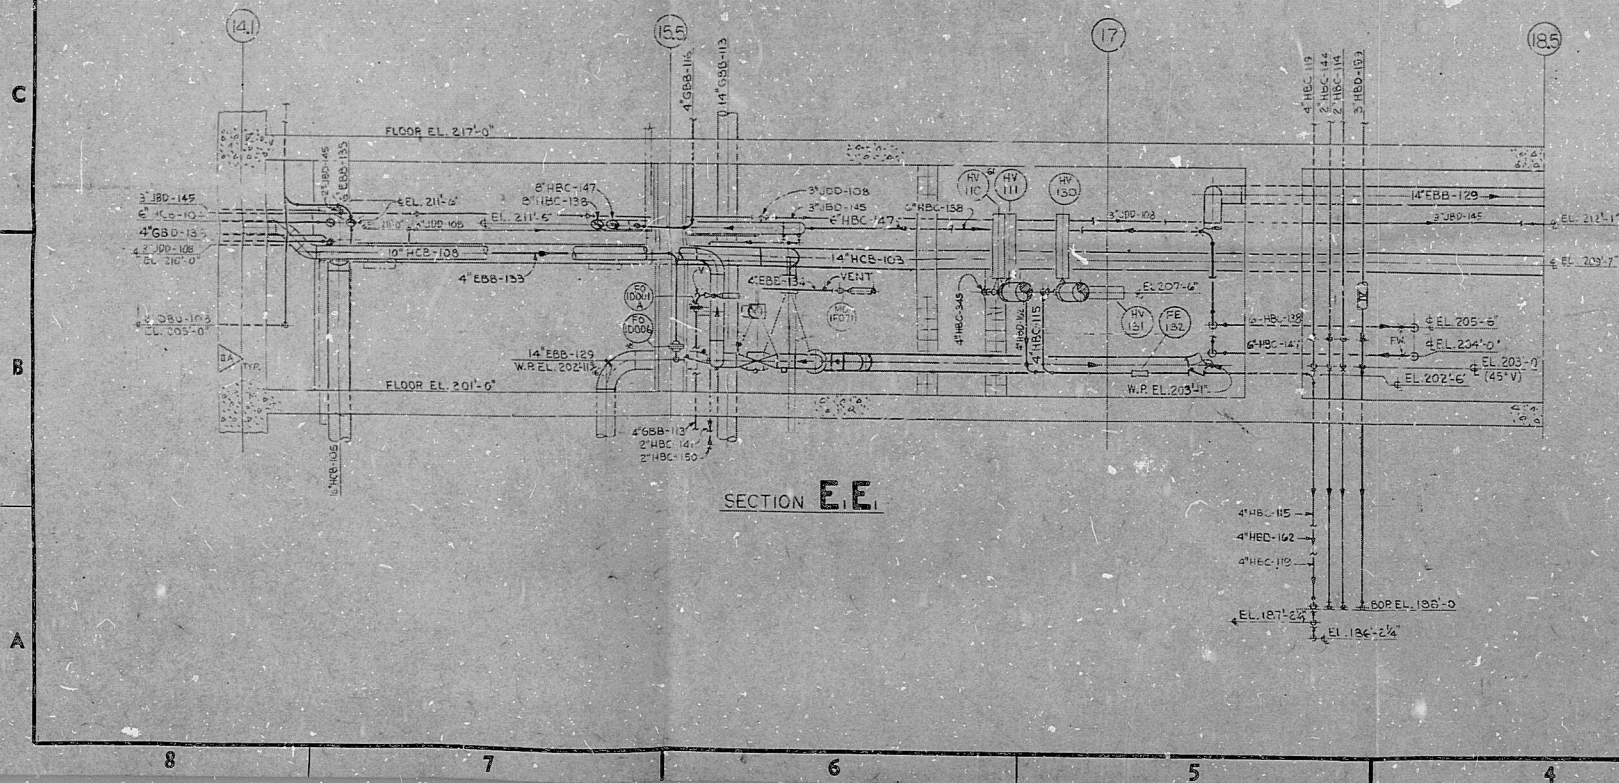


NOTE:
1. FOR LEGEND AND GENERAL NOTES SEE DWG. NO. M-705.

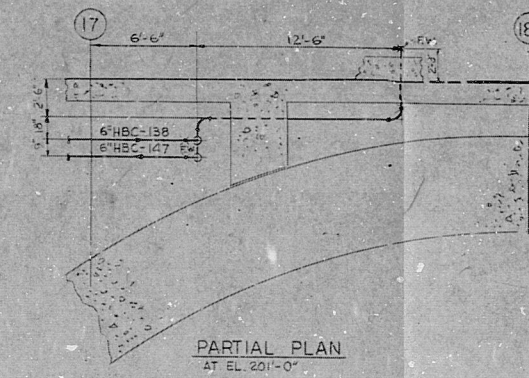

PENET. NO.	INSTR. NO.	NO. OF TUBES
#3	FOR FUTURE USE BY FIELD INSTR. GROUP	
#4		
#5		
#6		

DWG. NO.	DESCRIPTION
M-696	INSTRUMENT LOCATION TURBINE BLDG. UNIT 1 PLAN AT EL. 200'-0" AREA 7
M-712	INSTRUMENT LOCATION REACTOR BLDG. UNIT 1 PLAN AT EL. 201'-0" AREA 12
M-718	INSTRUMENT LOCATION REACTOR BLDG. UNIT 1 PLAN AT EL. 201'-0" AREA 15
M-737	INSTRUMENT LOCATION WASTEWATER BUILDING PLAN AT EL. 191'-0" AREA 20

NO.	DATE	DESCRIPTION	BY	CHKD.	APPD.
1	10/1/71	ISSUED FOR CONSTRUCTION	...	...	...
2	10/1/71	RELOCATED INSTRUMENTS & ADDED PENETRATIONS AT NOTE 1	...	...	...

REVIEWED FOR ALARA
REV. 5 INT. DATE 10/1/71

BACKGROUND OF THIS DRAWING
REPRODUCED FROM PLANT DESIGN
DRAWING NO. M-207 REV. 25

BACKGROUND LEGIBILITY
NOT REQUIRED

TERA
APERTURE
CARD

DECTEL SAN FRANCISCO LIMERICK GENERATING STATION UNITS 1 & 2 PHILADELPHIA ELECTRIC COMPANY		
INSTRUMENT LOCATION REACTOR BLDG. UNIT No. 1 PLAN AT EL. 201'-0" AREA 11		
JOB NO. 8031	DRAWING NO. M-706	REV. 7

RIDS

8110080412

