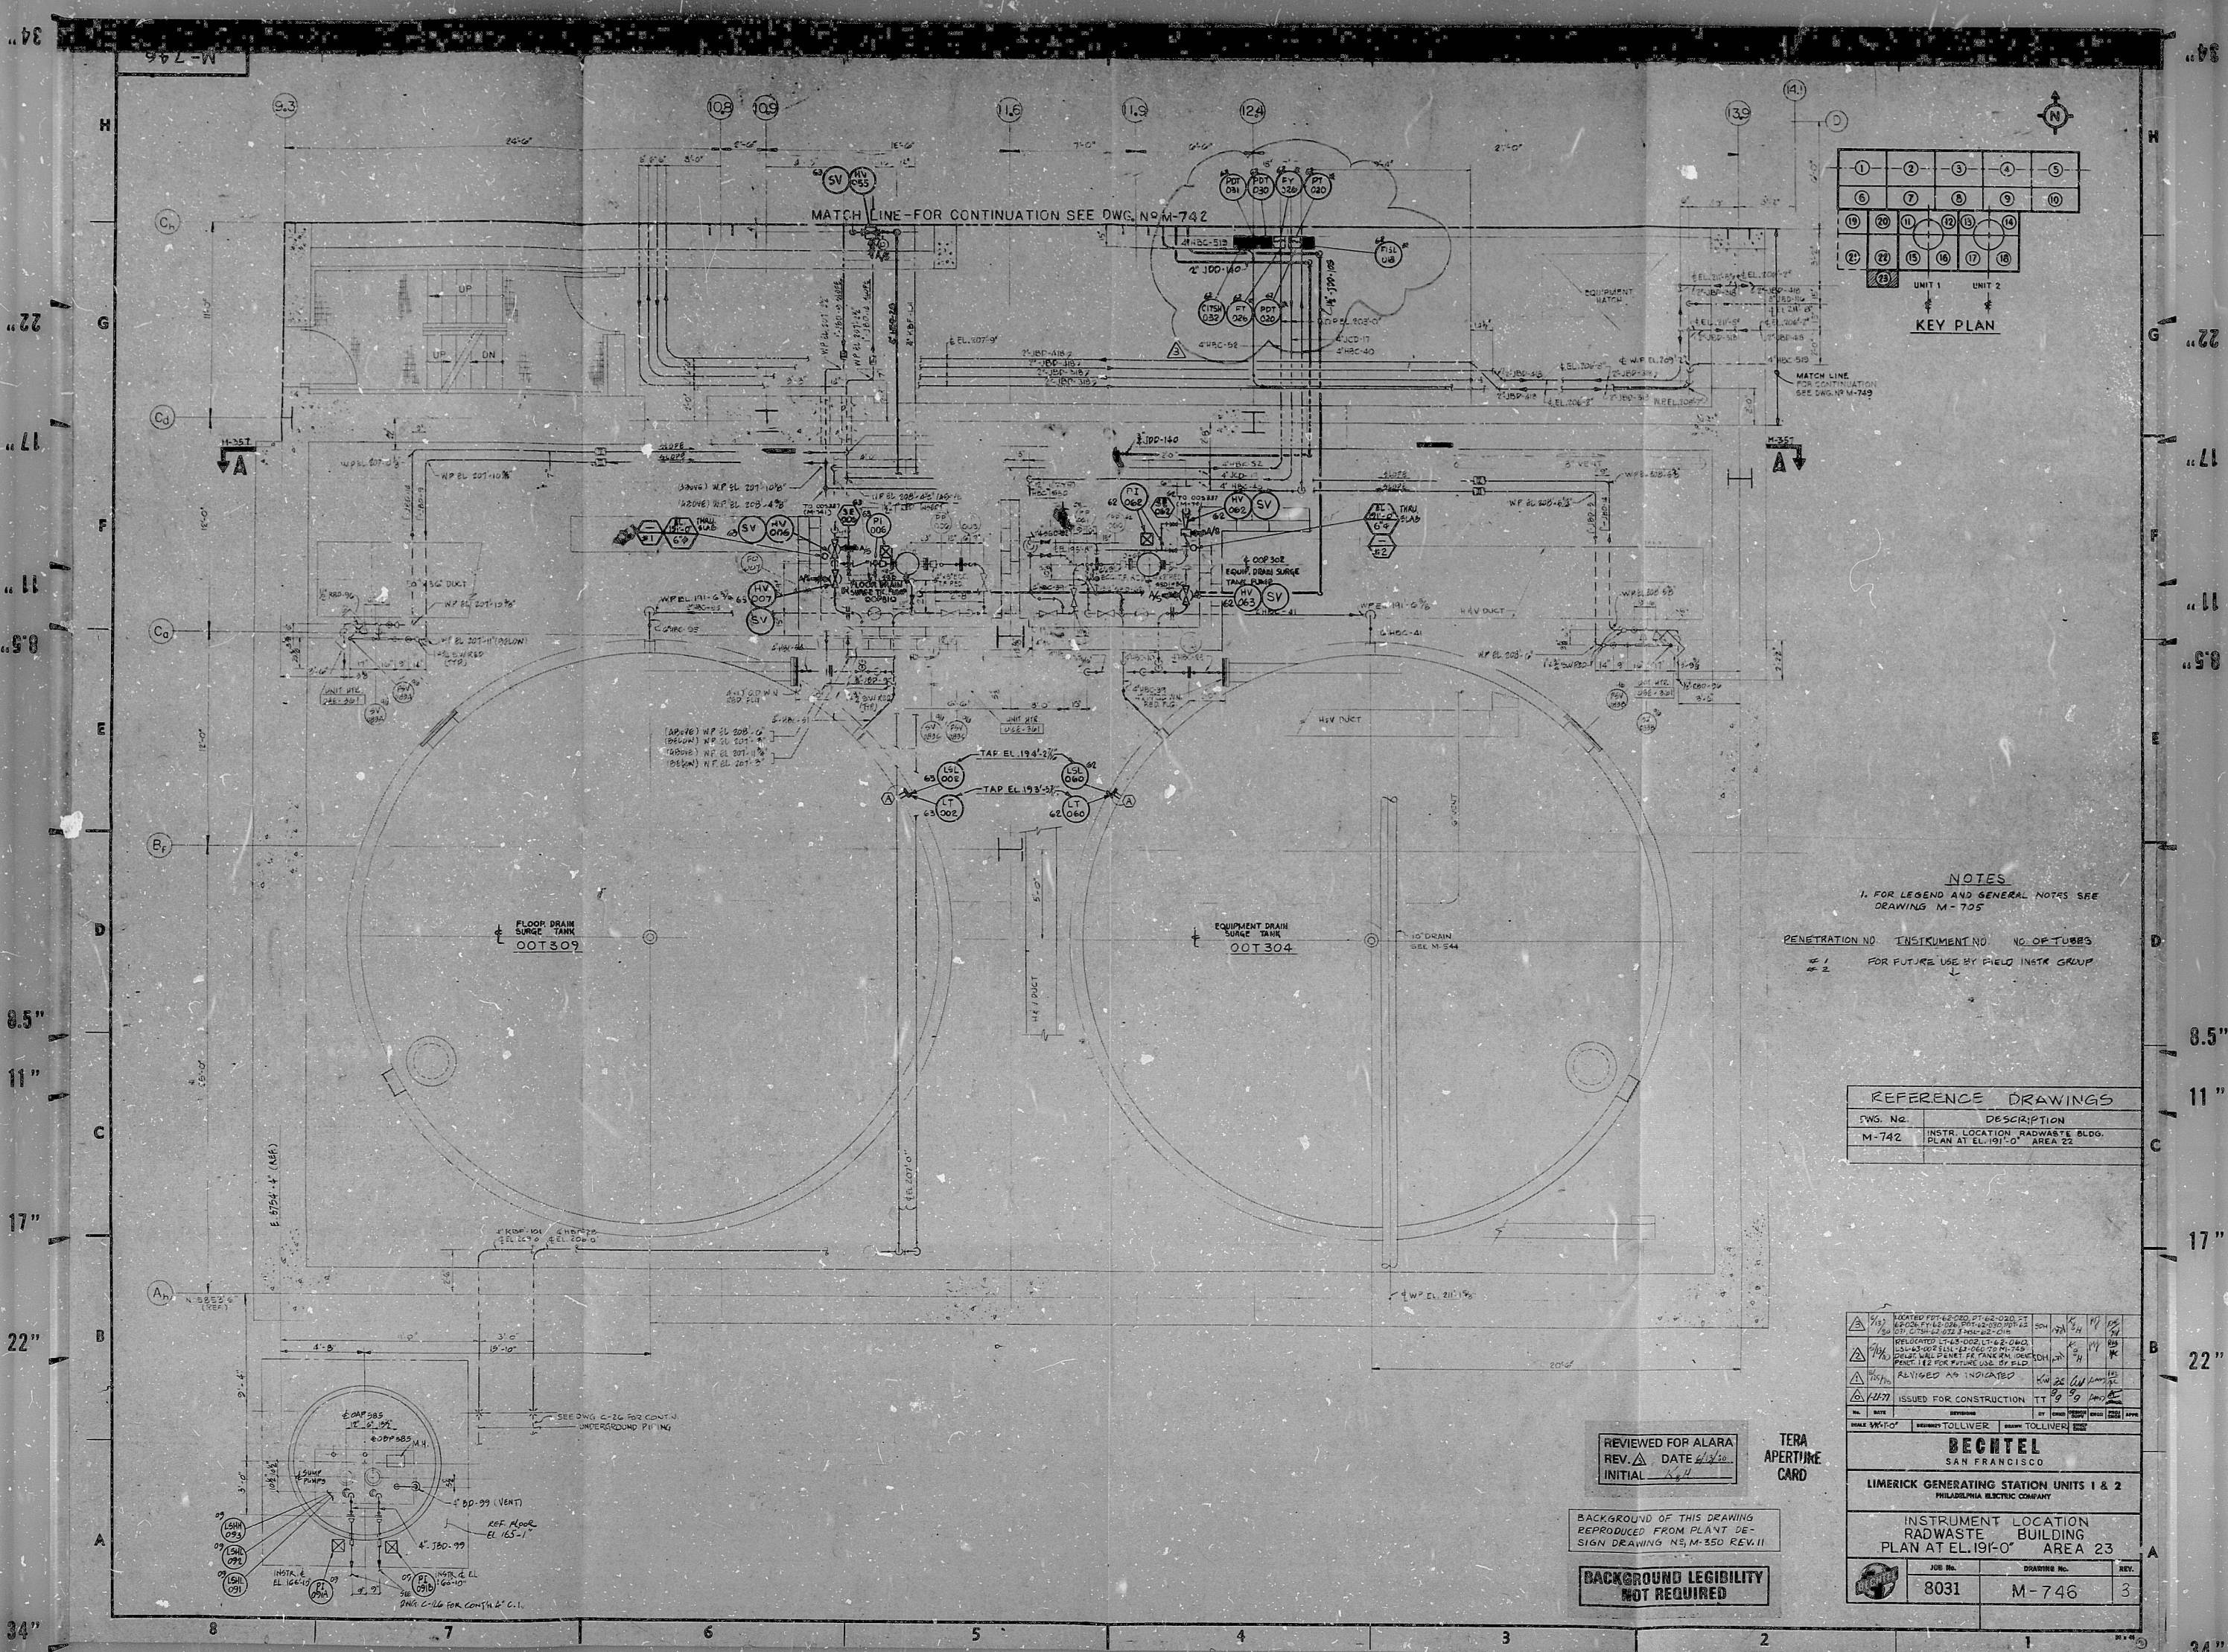


NOTES
1. FOR LEGEND AND GENERAL NOTES SEE DRAWING M-705
PENETRATION NO. INSTRUMENT NO. NO. OF TUBES
1 FOR FUTURE USE BY FIELD INSTR. GROUP
2

REFERENCE DRAWINGS	
DWG. NO.	DESCRIPTION

REVIEWED FOR ALARA
REV. DATE 6/14/80
INITIAL *ALH*

TERA
APERTURE
CARD

BACKGROUND OF THIS DRAWING
REPRODUCED FROM PLANT DE-
SIGN DRAWING NSM-350 REV. 11

BACKGROUND LEGIBILITY
NOT REQUIRED

REVISIONS	
NO.	DESCRIPTION
1	ISSUED FOR CONSTRUCTION
2	REVISED AS INDICATED

DECHTEL	
SAN FRANCISCO	
LIMERICK GENERATING STATION UNITS 1 & 2	
PHILADELPHIA ELECTRIC COMPANY	
INSTRUMENT LOCATION	
RADWASTE BUILDING	
PLAN AT EL. 191'-0" AREA 23	
JOB NO.	DRAWING NO.
8031	M-746
REV.	REV.
3	3

RIDS

810080527

