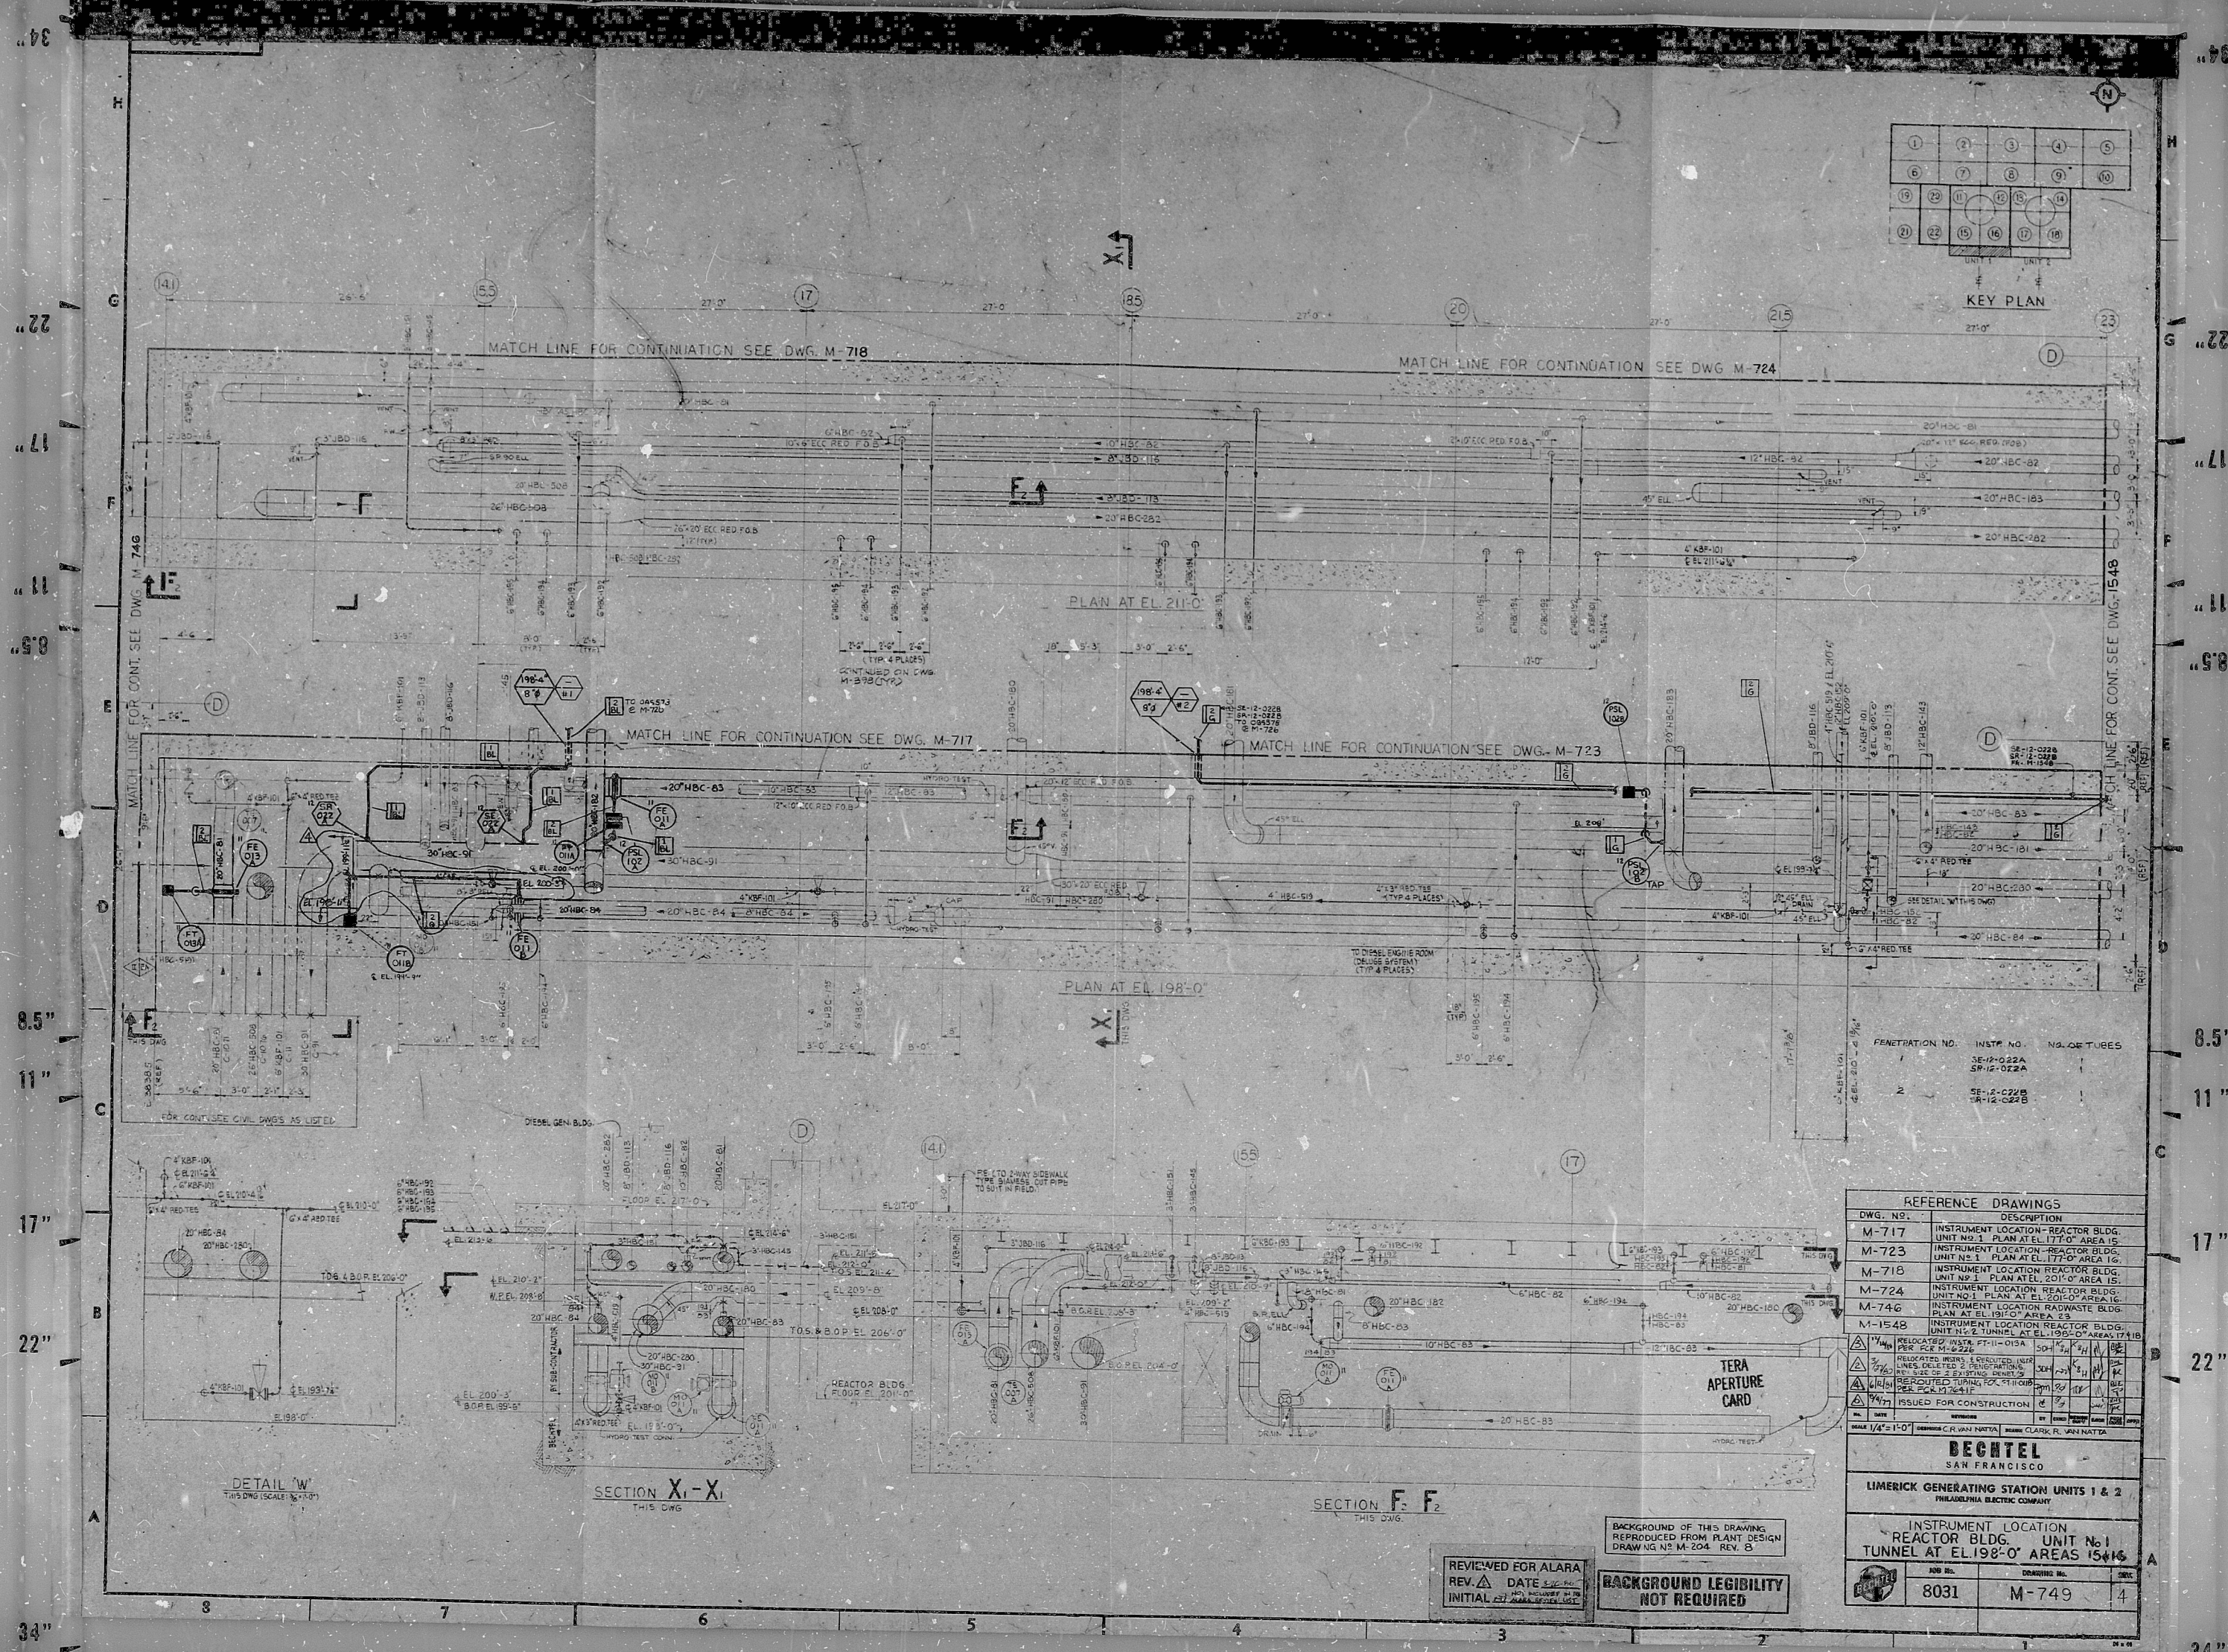


REFERENCE DRAWINGS	
DWG. NO.	DESCRIPTION
M-717	INSTRUMENT LOCATION- REACTOR BLDG. UNIT NO. 1 PLAN AT EL. 177'-0" AREA 15
M-723	INSTRUMENT LOCATION- REACTOR BLDG. UNIT NO. 1 PLAN AT EL. 177'-0" AREA 16
M-718	INSTRUMENT LOCATION- REACTOR BLDG. UNIT NO. 1 PLAN AT EL. 201'-0" AREA 15
M-724	INSTRUMENT LOCATION- REACTOR BLDG. UNIT NO. 1 PLAN AT EL. 201'-0" AREA 16
M-1548	INSTRUMENT LOCATION- REACTOR BLDG. UNIT NO. 2 TUNNEL AT EL. 198'-0" AREA 17/18

REACTOR BLDG. UNIT NO. 1	
TUNNEL AT EL. 198'-0" AREAS 15+16	
ADD. NO.	DESCRIPTION
8031	M-749

REVIEWED FOR ALARA
REV. DATE
INITIAL

BACKGROUND LEGIBILITY
NOT REQUIRED

BACKGROUND OF THIS DRAWING
REPRODUCED FROM PLANT DESIGN
DRAWING NO. M-204 REV. 8

DETAIL 'W'
THIS DWG. (SCALE 1/4"=1'-0")

SECTION X-X
THIS DWG.

SECTION F-F
THIS DWG.

TERA
APERTURE
CARD

RIDS

8/10080539

