
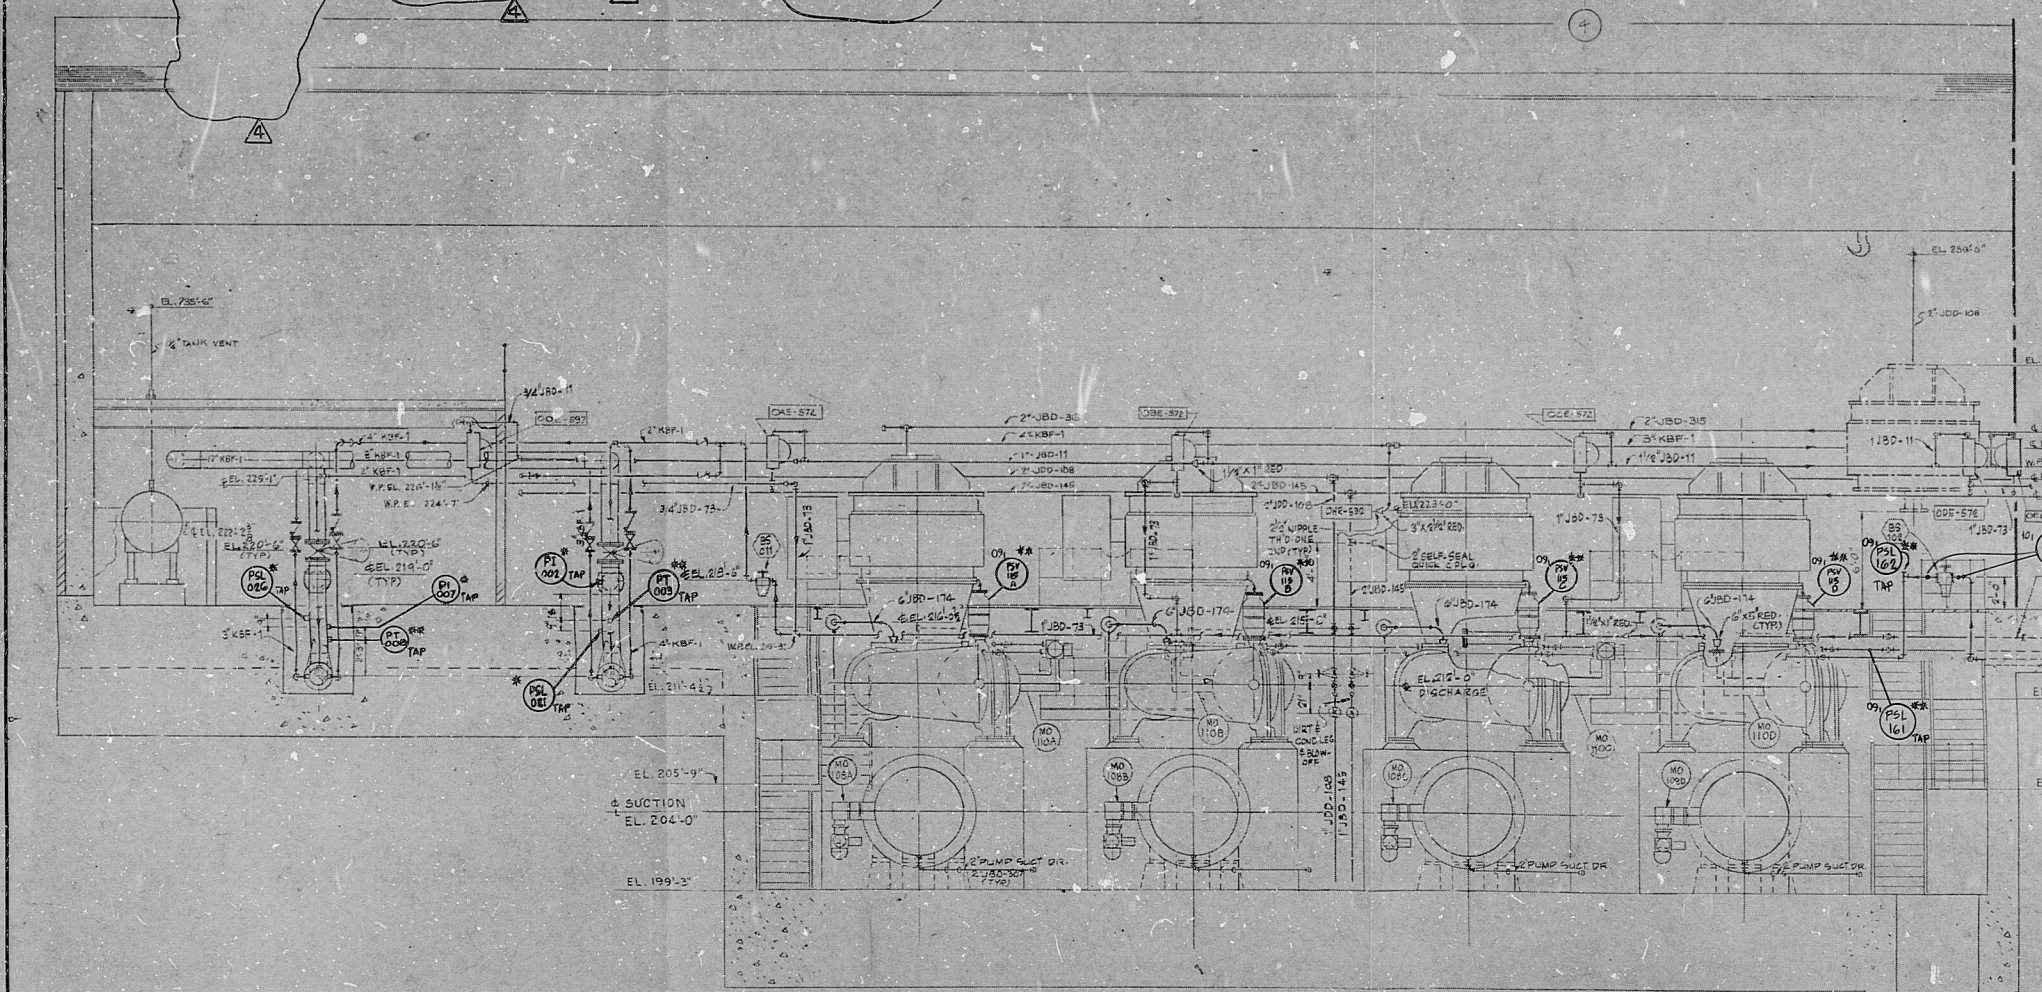
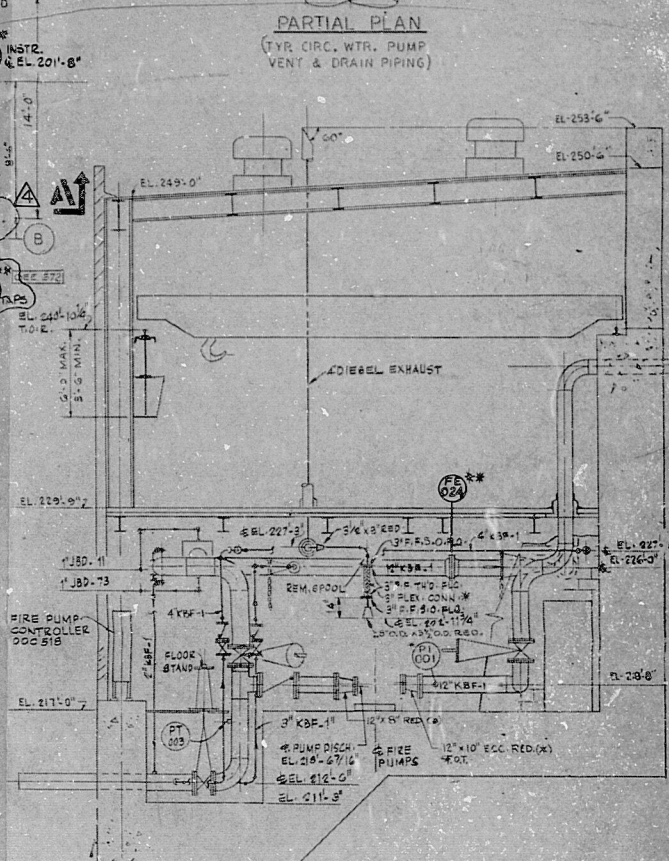
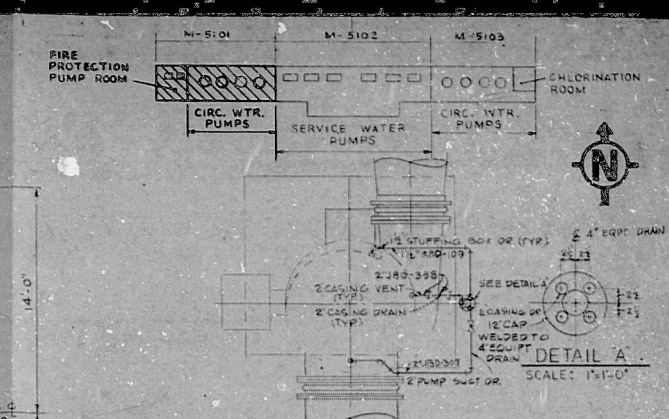


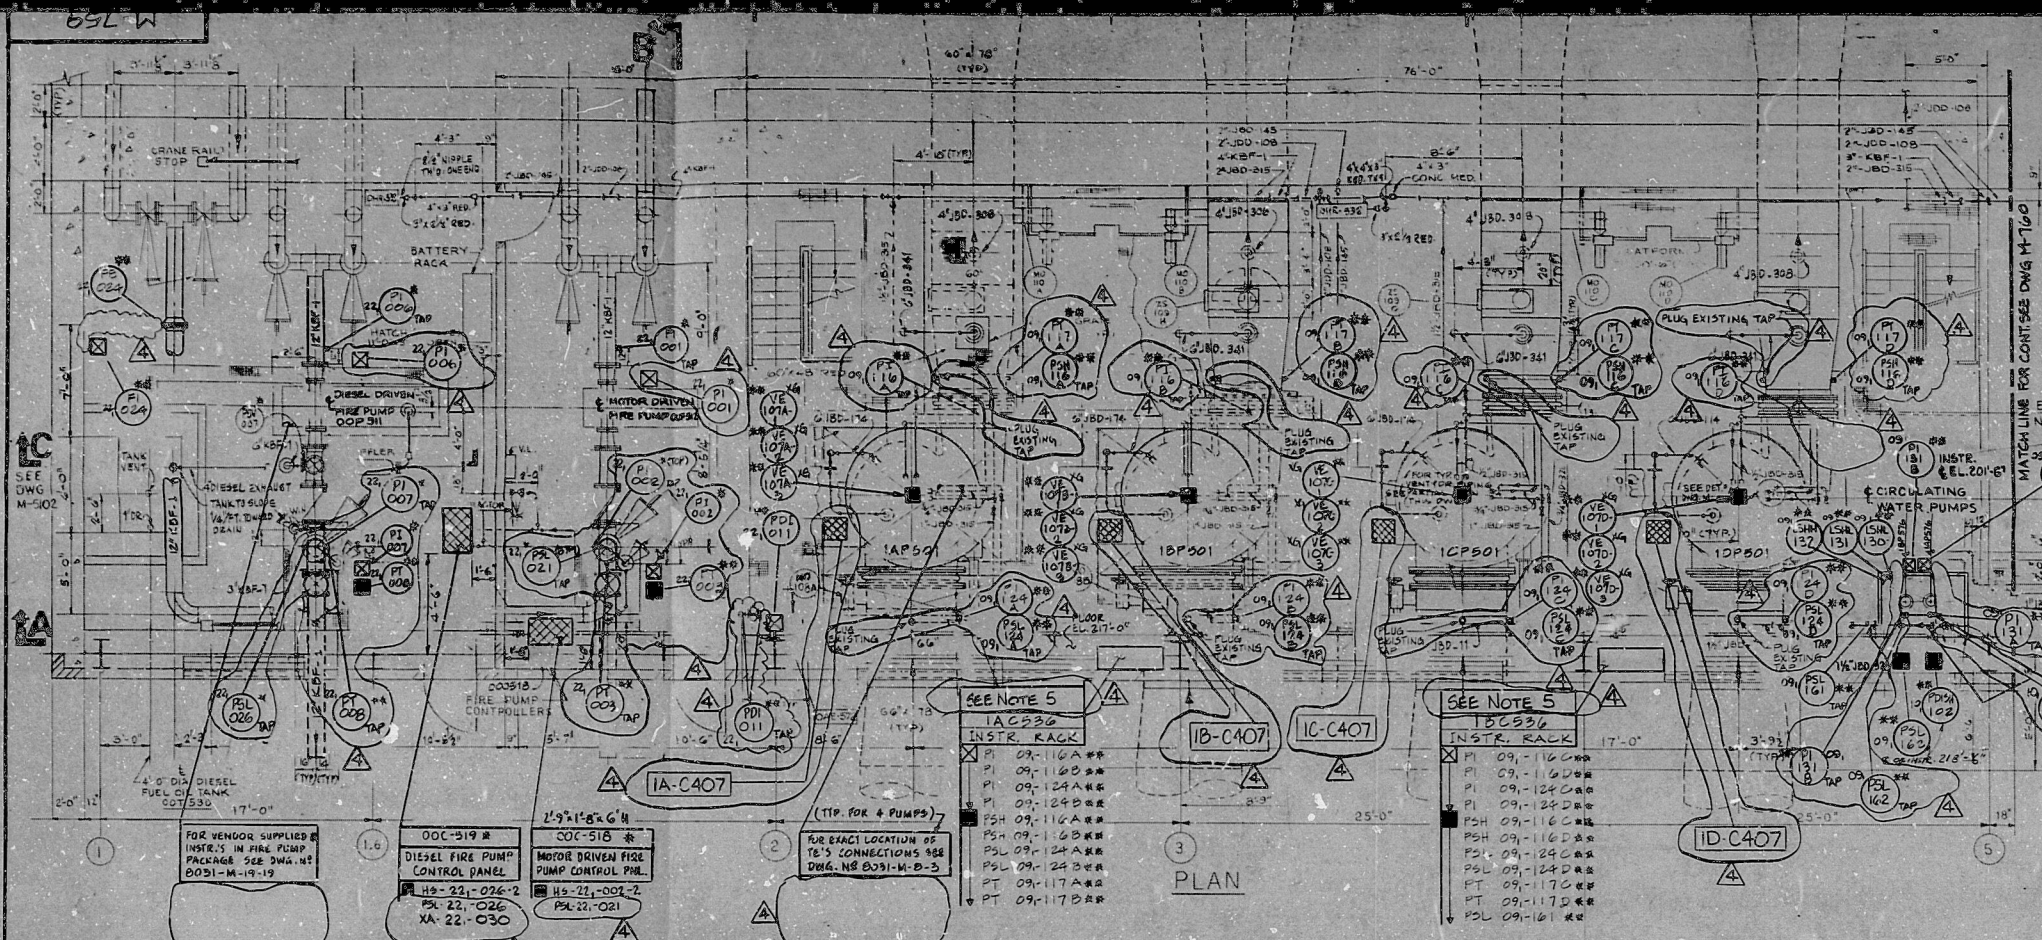

NOTE:

1. FOR LEGEND AND REFERENCE DRAWING LIST, SEE INSTRUMENT LOCATION DRAWING NO. M-760.
2. NON-ASTERISK (*) ITEMS ARE FURNISHED BY SUBCONTRACTOR.
3. * INDICATES INSTR. FURNISHED BY MAJOR EQUIPMENT DELIVER.
4. ** INDICATES INSTRUMENTS SUPPLIED BY BECHTEL.
5. FOR INSTR. INSTALLATION INFORMATION SEE INSTR. INSTALLATION DWG. M-762.

NO.	DATE	REVISION	BY	CHECKED	APPROVED

BECHTEL
SAN FRANCISCO

LIMERICK GENERATING STATION UNITS 1 & 2
PHILADELPHIA ELECTRIC COMPANY

INSTRUMENT LOCATION
CIRCULATING WATER PUMP HOUSE
UNIT 1
PLAN & SECTIONS

JOB NO.	DRAWING NO.	REV.
8031	M-759	4

BACKGROUND FOR THIS DRAWING
REPRODUCED FROM PLANT DESIGN
DRAWING NO. M-5101 REV. 4

TERA
APERTURE
CARD

RIDS

8110080572

