




RIDS

8110090081

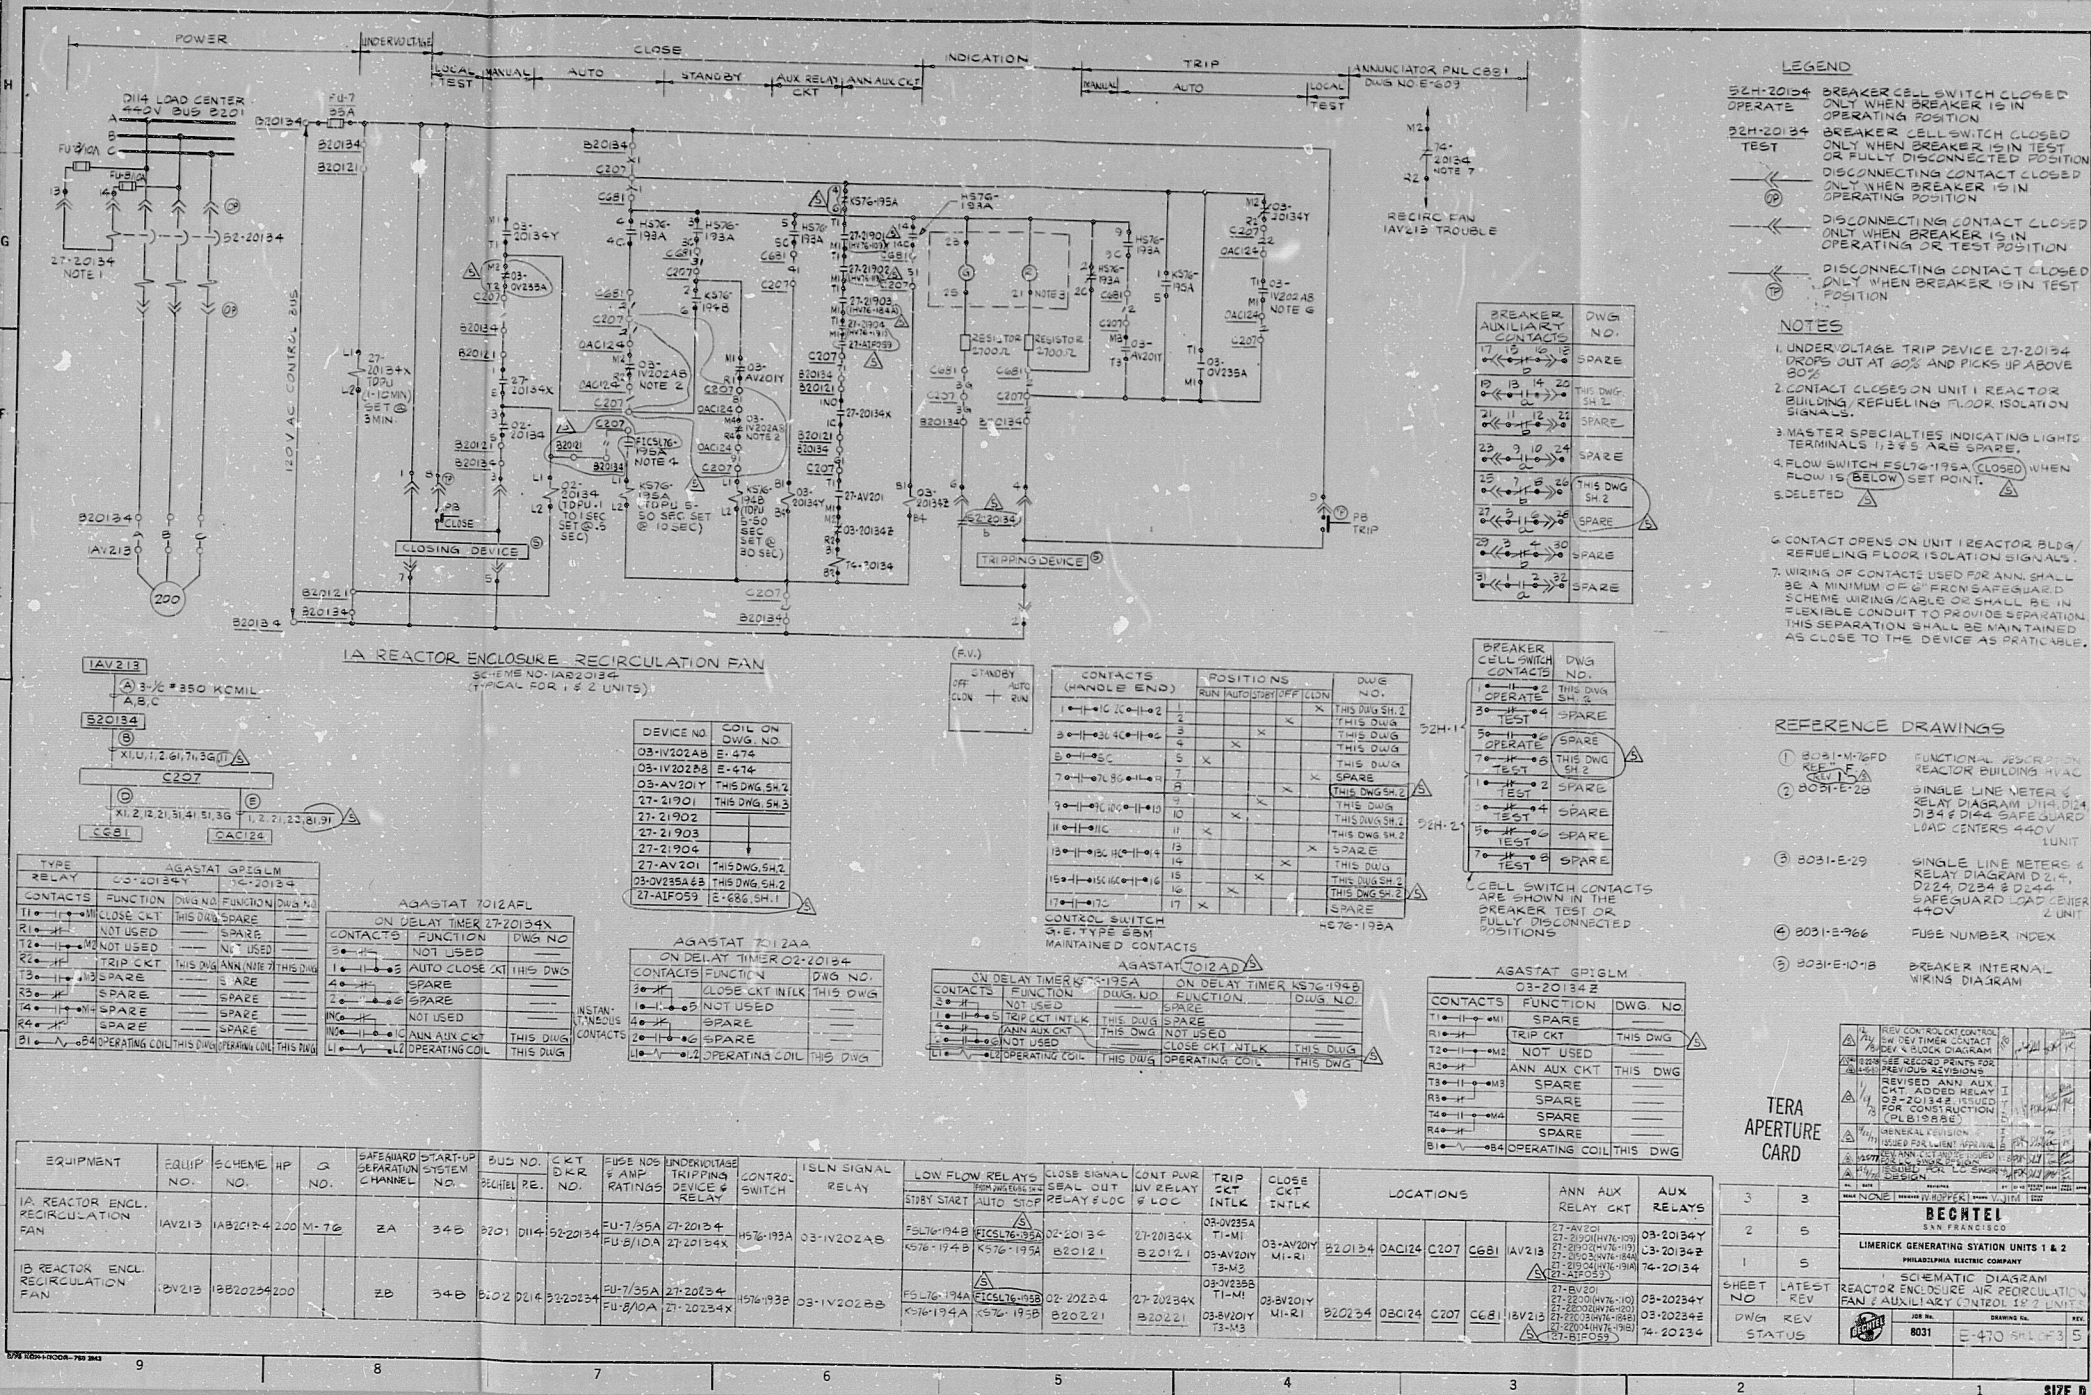