


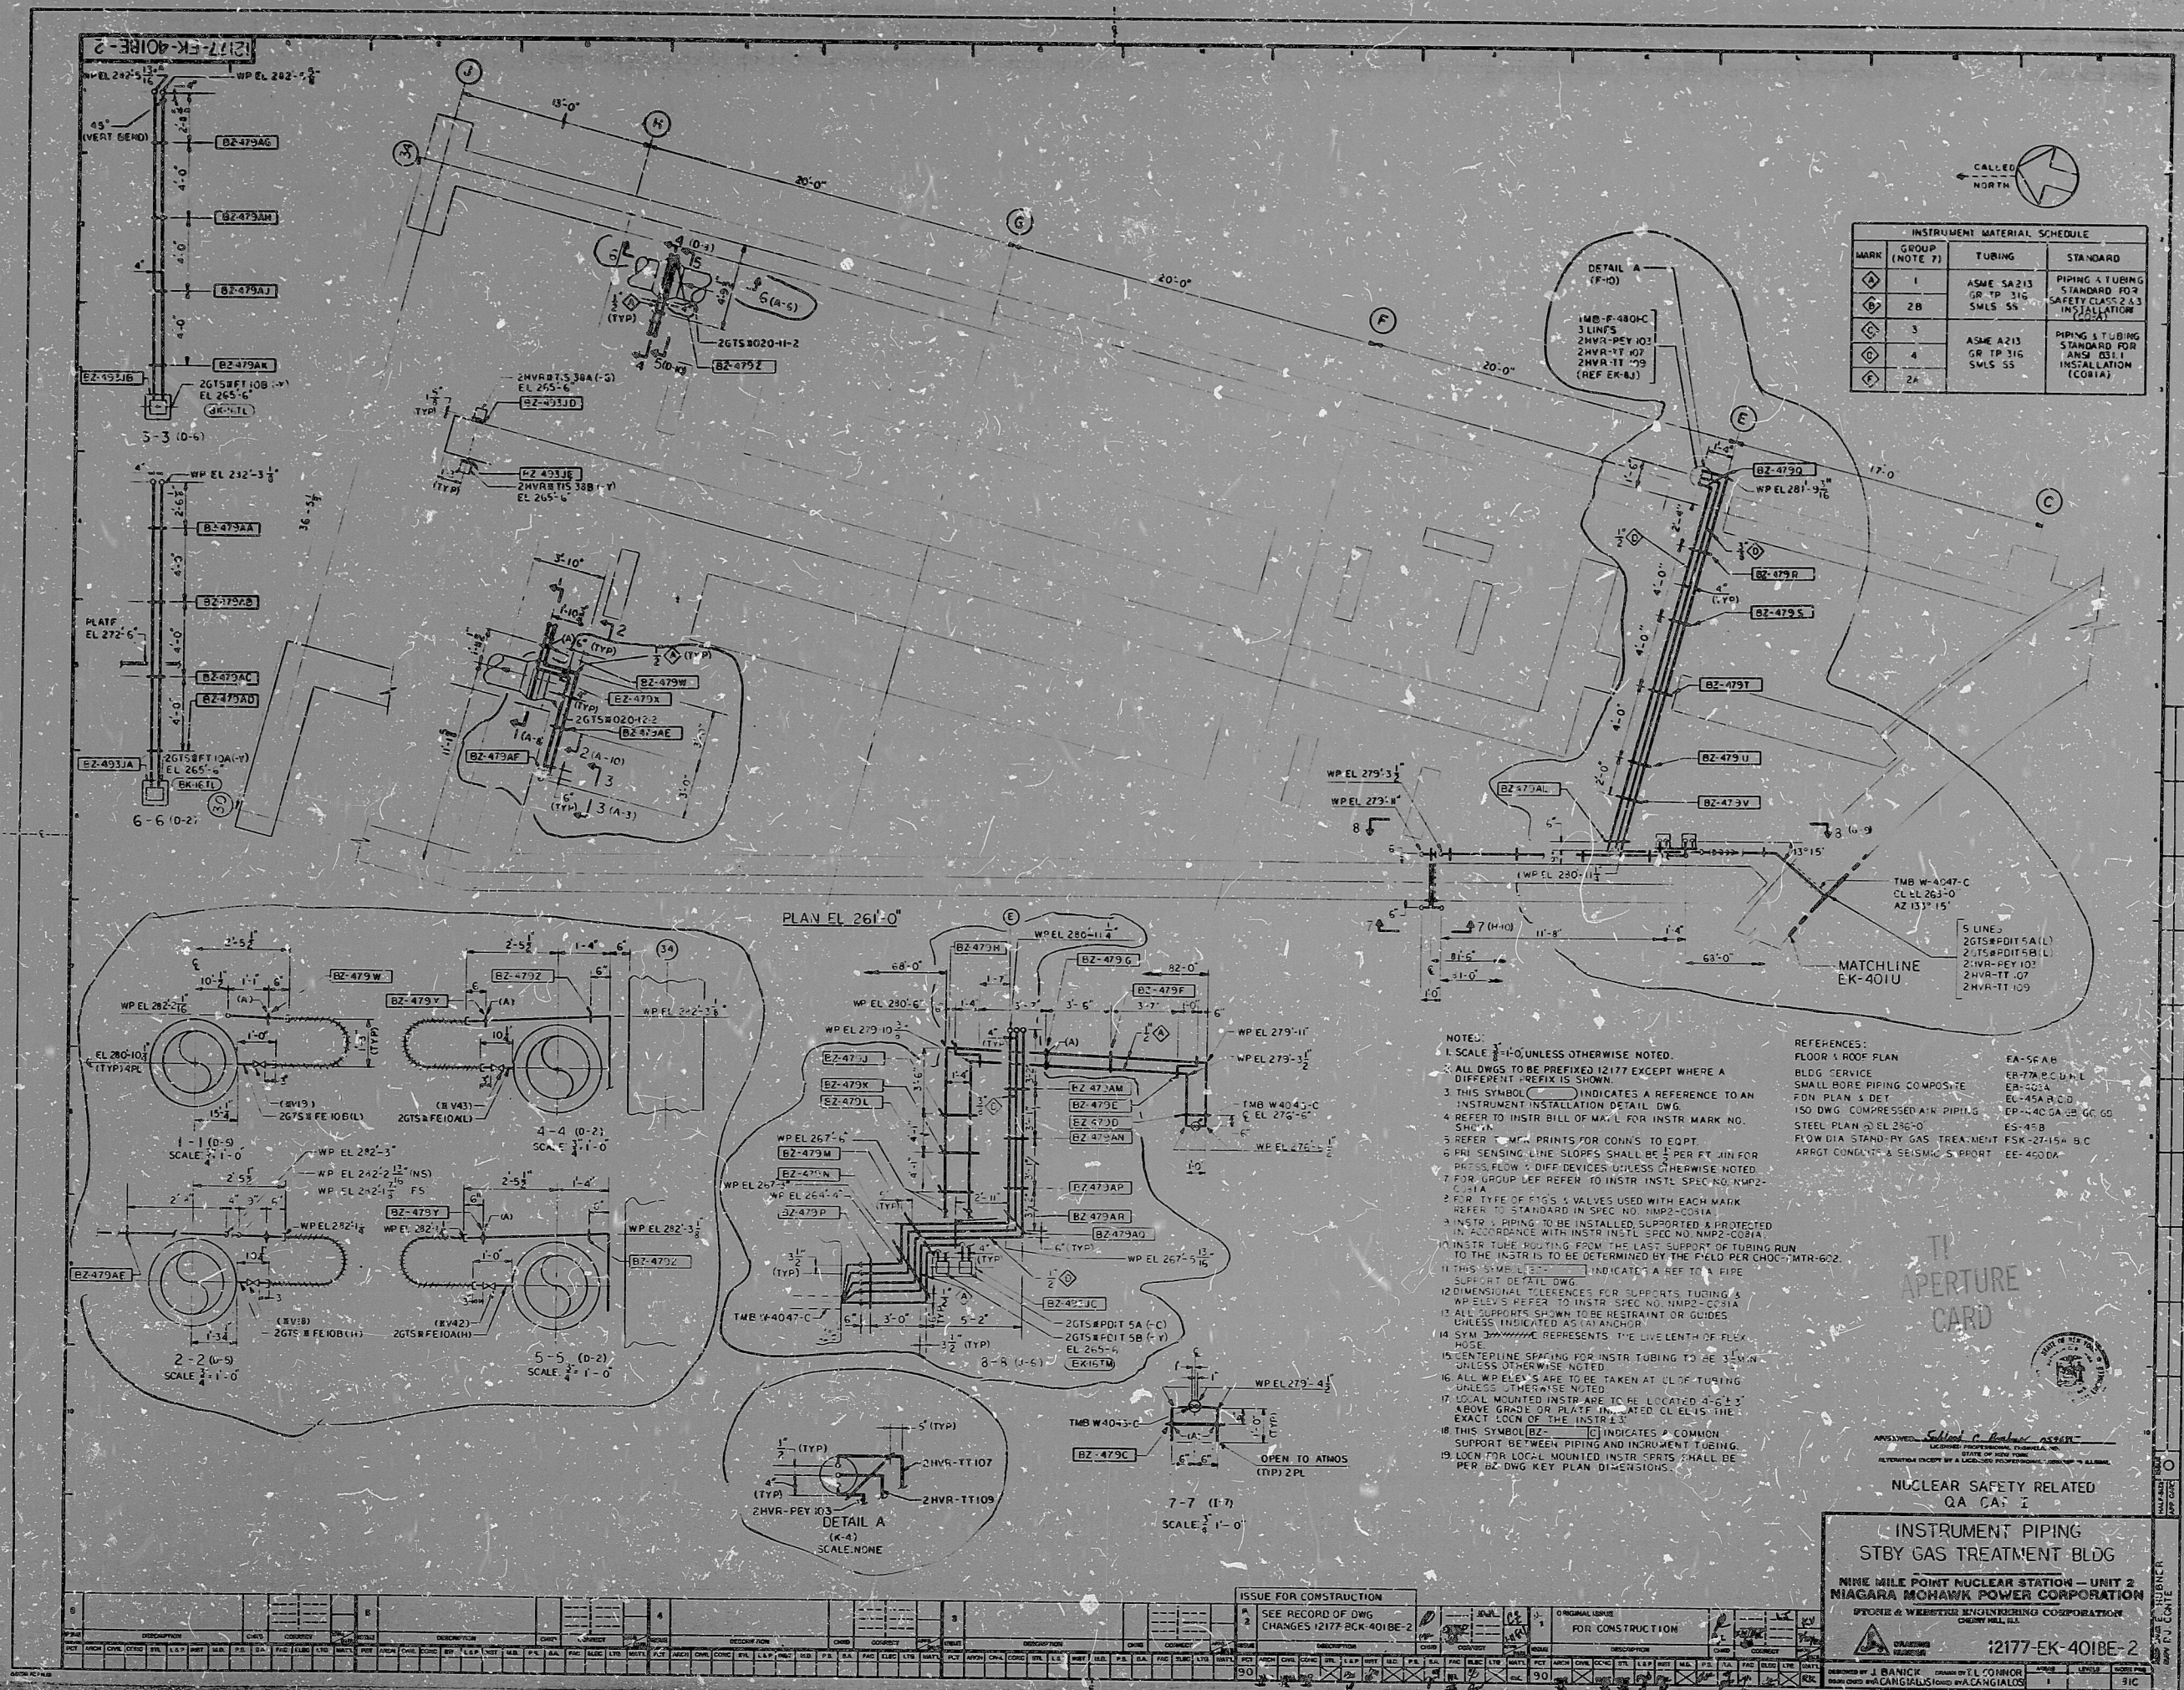

INSTRUMENT MATERIAL SCHEDULE			
MARK	GROUP (NOTE 7)	TUBING	STANDARD
A	1	ASME SA213 GR TP 316	PIPING & TUBING STANDARD FOR SAFETY CLASS 2 INSTALLATION (C2A)
B	2B	SMLS 55	
C	3		
D	4	ASME A213 GR TP 316 SMLS 55	PIPING & TUBING STANDARD FOR ANSI B31.1 INSTALLATION (C2BIA)
E	2A		

PDR RIDS

8404180156

