


12177-EE-IBC-6

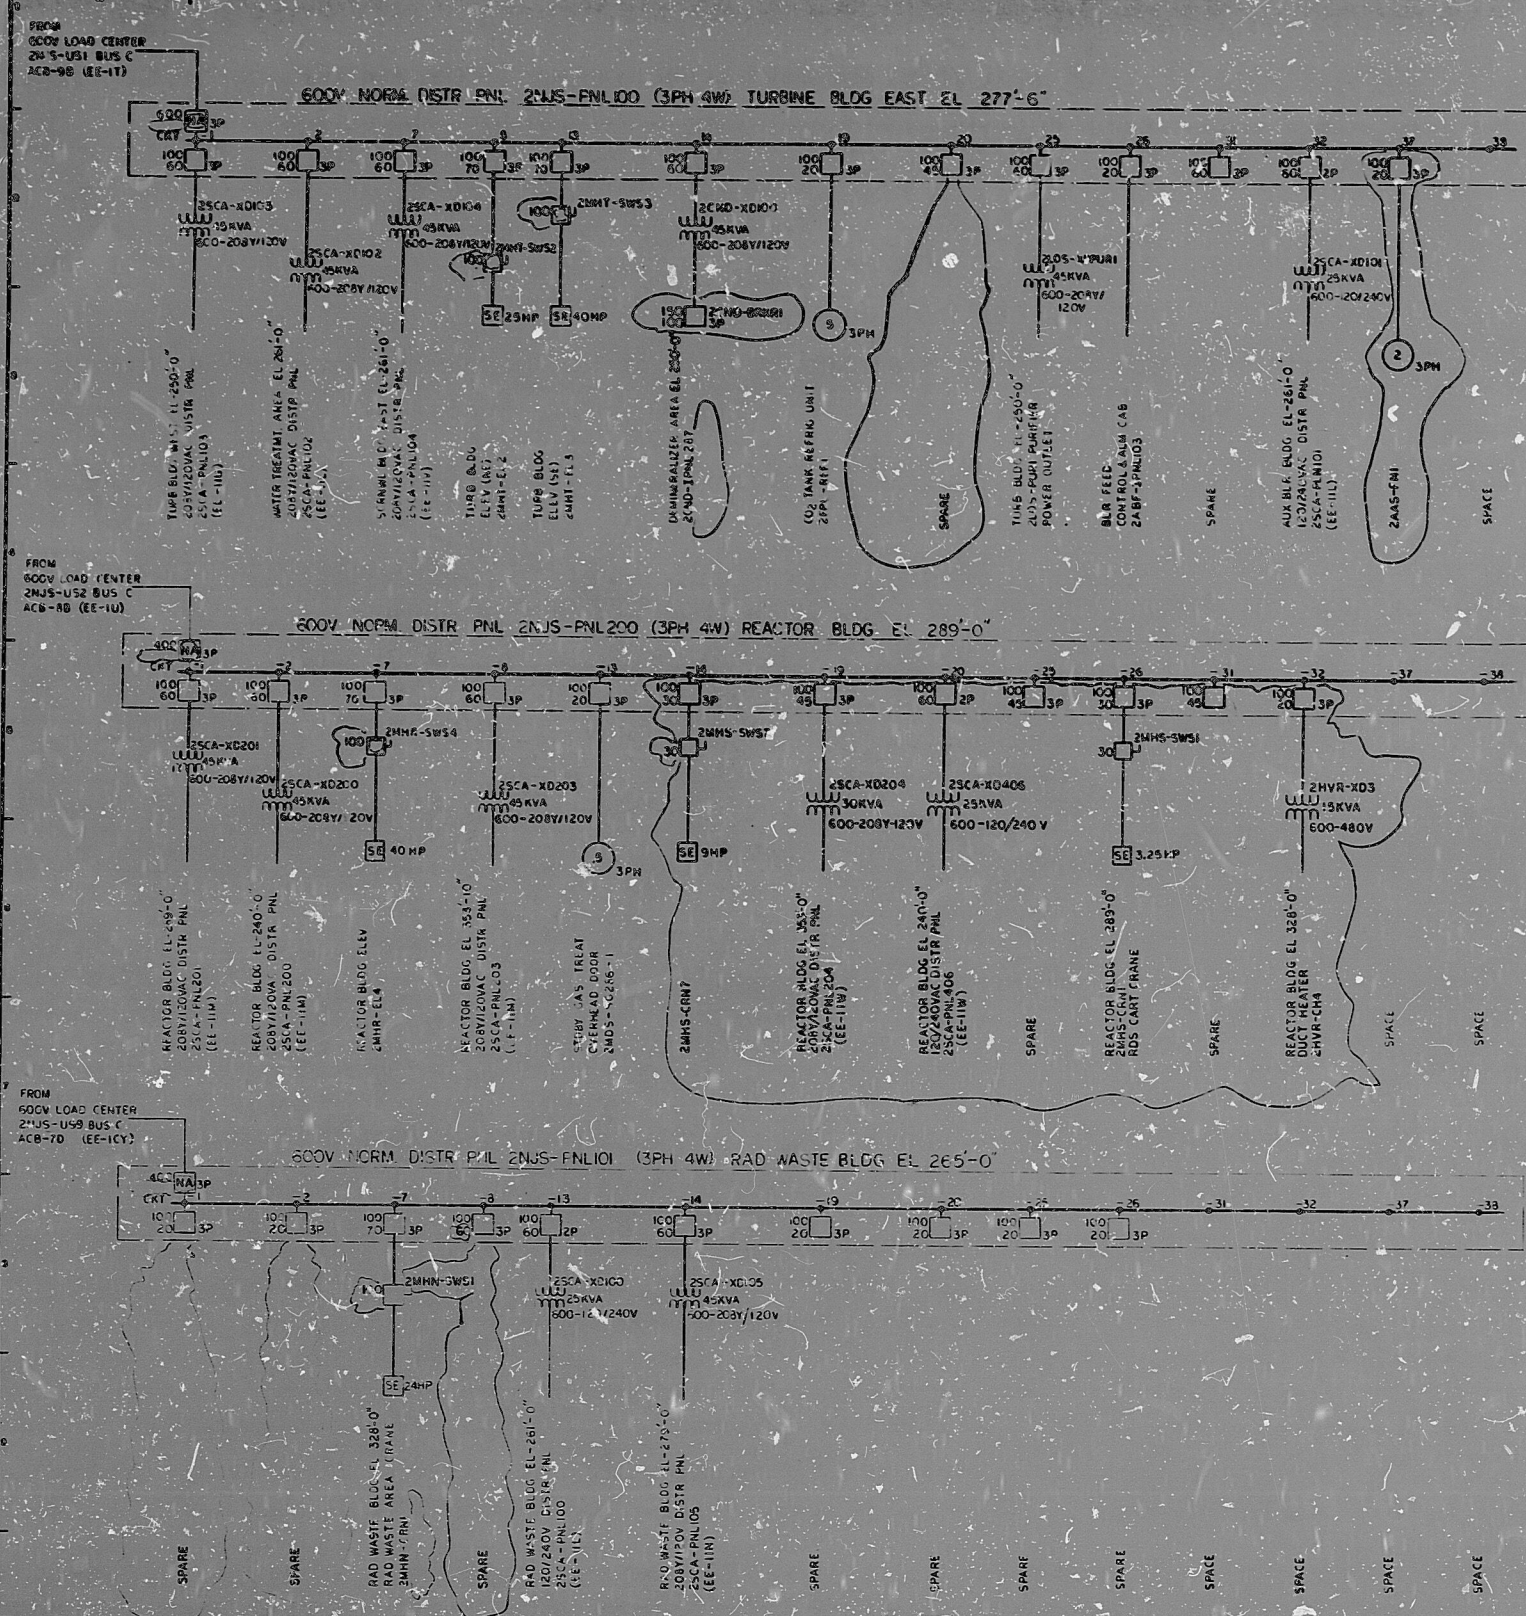

NOTES:
1. GENERAL NOTES, REFERENCES &
ADDITIONAL SYMBOLS SEE-ICA

TI
APERTURE
CARD

QA CAT II



APPROVED: *[Signature]*
STATE OF NEW YORK
SUPERVISOR OF ELECTRICITY AND GAS

600V ONE LINE DIAGRAM
DISTRIBUTION PANELS
2NJS-PNL100, PNL101 & PNL200

NINE MILE POINT NUCLEAR STATION - UNIT 2
NIAGARA MOHAWK POWER CORPORATION

12177-EE-IBC-6
(2.45)

REVISIONS									

PDR RIDS

8404180289

