


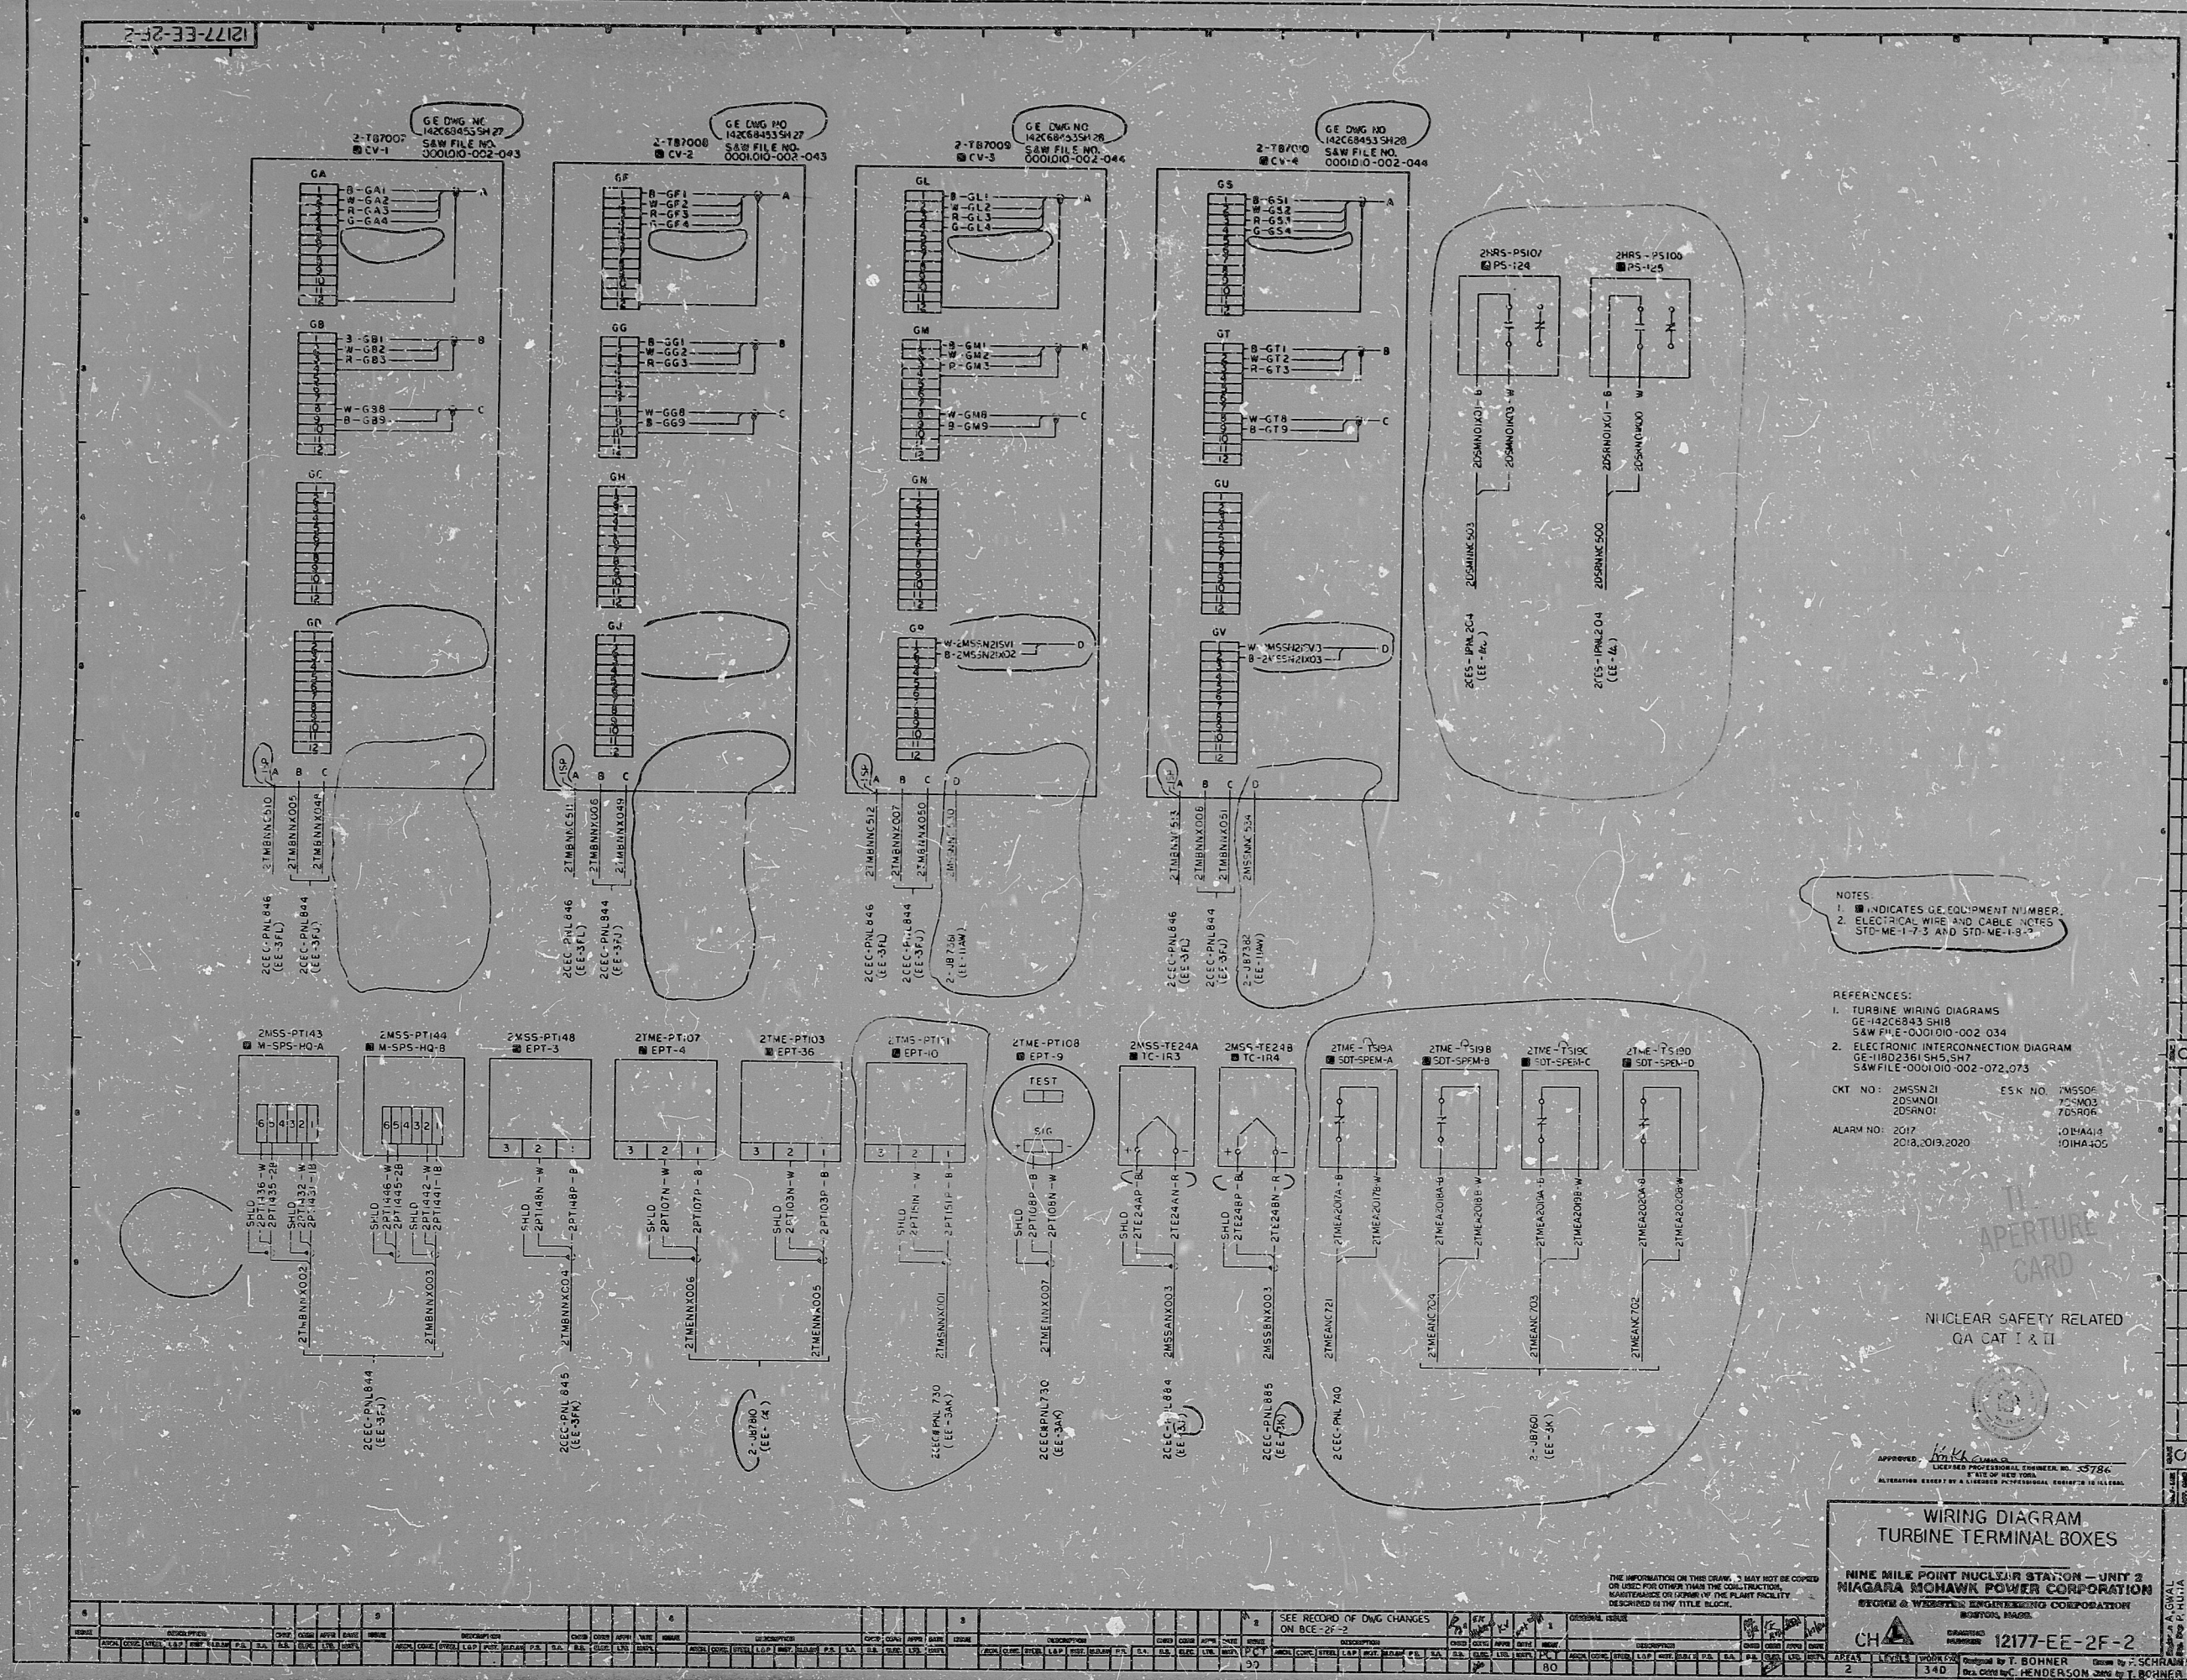

APPROVED: John J. Cunniff
 LICENSED PROFESSIONAL ENGINEER NO. 35786
 STATE OF NEW YORK
 ALTERATION EXCEPT BY A LICENSED PROFESSIONAL ENGINEER IS ILLEGAL

WIRING DIAGRAM TURBINE TERMINAL BOXES

NINE MILE POINT NUCLEAR STATION - UNIT 2
 NIAGARA MOHAWK POWER CORPORATION
 STONE & WEBSTER ENGINEERING CORPORATION
 BOSTON, MASS.

CH  DRAFTED NUMBER 12177-EE-2F-2

AREAS	LYNCH	WORKING	Original by T. BOHNER	Drawn by F.S.
2		34D	Des. Check by C. HENDERSON	Check by T.B.

PDR RIDS

8404180489

