


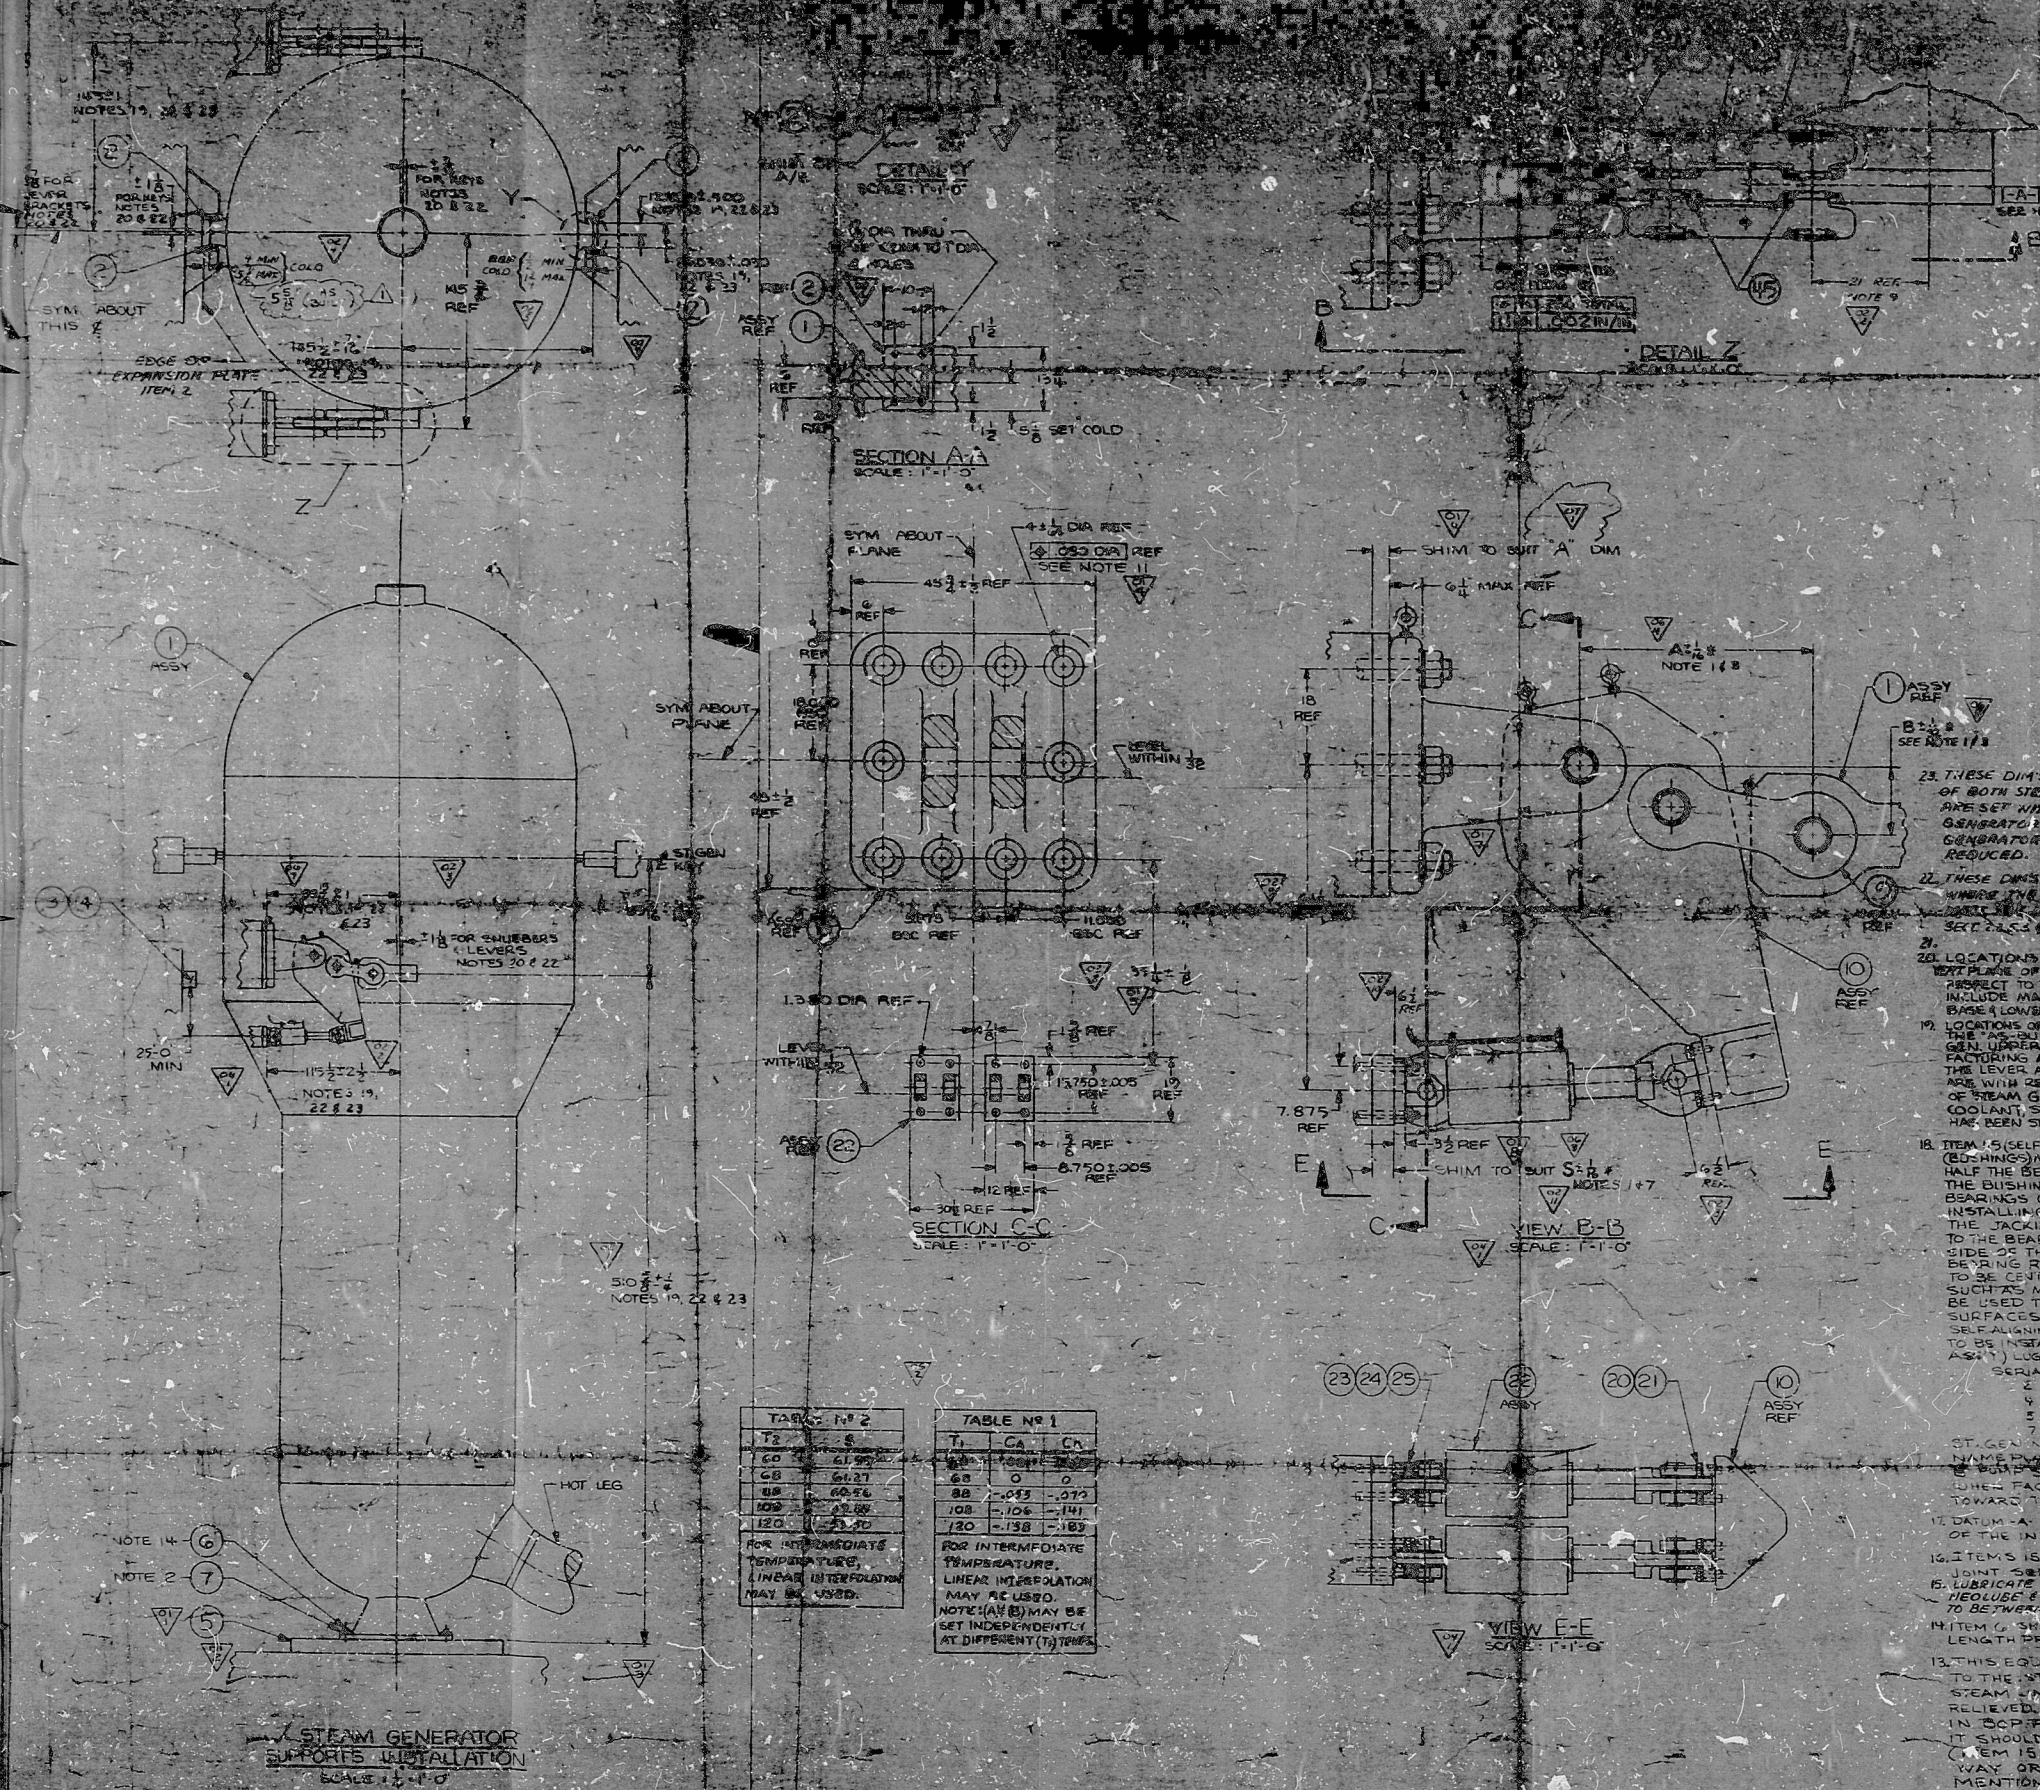


21. THESE DIMS & TOLLS INCLUDE THE "AS-BUILT" DIMS OF BOTH STEAM GENERATORS. IF THE INTERFACES ARE SET WITH RESPECT TO THE INDIVIDUAL STEAM GENERATOR, THE TOLERANCES SHOULD BE REDUCED.


DISCIPLINE COMMENT:

DATE BY: 10/1/59

8404190408

POOR ORIGINAL

1564-000 R3

BRAND SERVICES INCORPORATED

PDR RIDS

8404190408

