



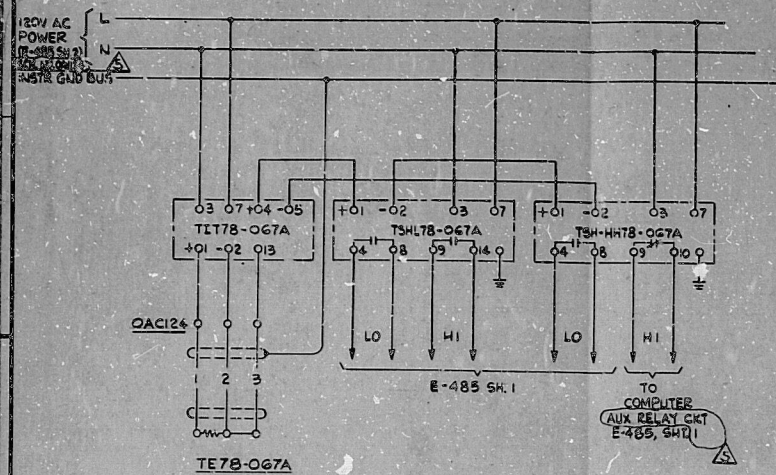


A STANDBY GAS TREATMENT SYSTEM ACCESS AREA UNIT COOLER TEMPERATURE
SCHEME NO. OAIH059


EQUIPMENT	EQUIP NO.	Q NO.	SCHEME NO.	SAFEGUARD SEPARATION CHANNEL	START-UP SYSTEM NO.	TRANSMITTER	SWITCHES	ELEMENT	120V AC POWER DWG NO.	SCHEME NO.	LOCATIONS	INTERLOCK DWG NO.	COMPUTER INPUT
A 50TS ACCESS AREA UNIT COOLER TEMPERATURE	OAVI41	M-78	OAIH059	ZA	30E	T178-067A	TSH-HH78-067A TSHL78-067A	TE78-067A	E-485, SH.2	OAVI24	OAC124 TE78-067A	E-485	C1418
B 50TS ACCESS AREA UNIT COOLER TEMPERATURE	C3VI41	M-78	OAIH059	ZB	30E	T178-067B	TSH-HH78-067B TSHL78-067B	TE78-067B	E-485, SH.2	OAVI24	OAC124 TE78-067B	E-485	C1419
A 50TS ROOM UNIT COOLER TEMPERATURE	OAVI40	M-78	OAIH060	ZA	30E	T178-068A	TSH-HH78-068A TSHL78-068A	TE78-068A	E-485, SH.2	OAVI24	OAC124 TE78-068A	E-485	C1416
B 50TS ROOM UNIT COOLER TEMPERATURE	OAVI40	M-78	OAIH060	ZB	30E	T178-068B	TSH-HH78-068B TSHL78-068B	TE78-068B	E-485, SH.2	OAVI24	OAC124 TE78-068B	E-485	C1417

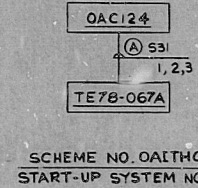

SCHEME NO. OAIH059
START-UP SYSTEM NO. 30E

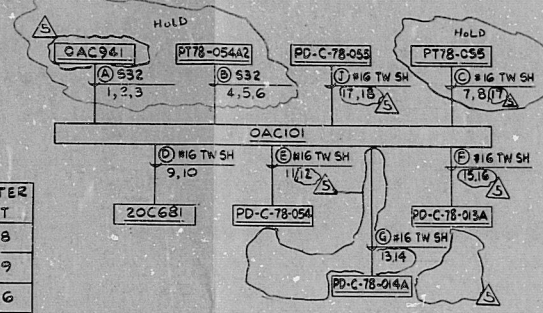

SCHEME NO. OCIPD026
START-UP SYSTEM 32A

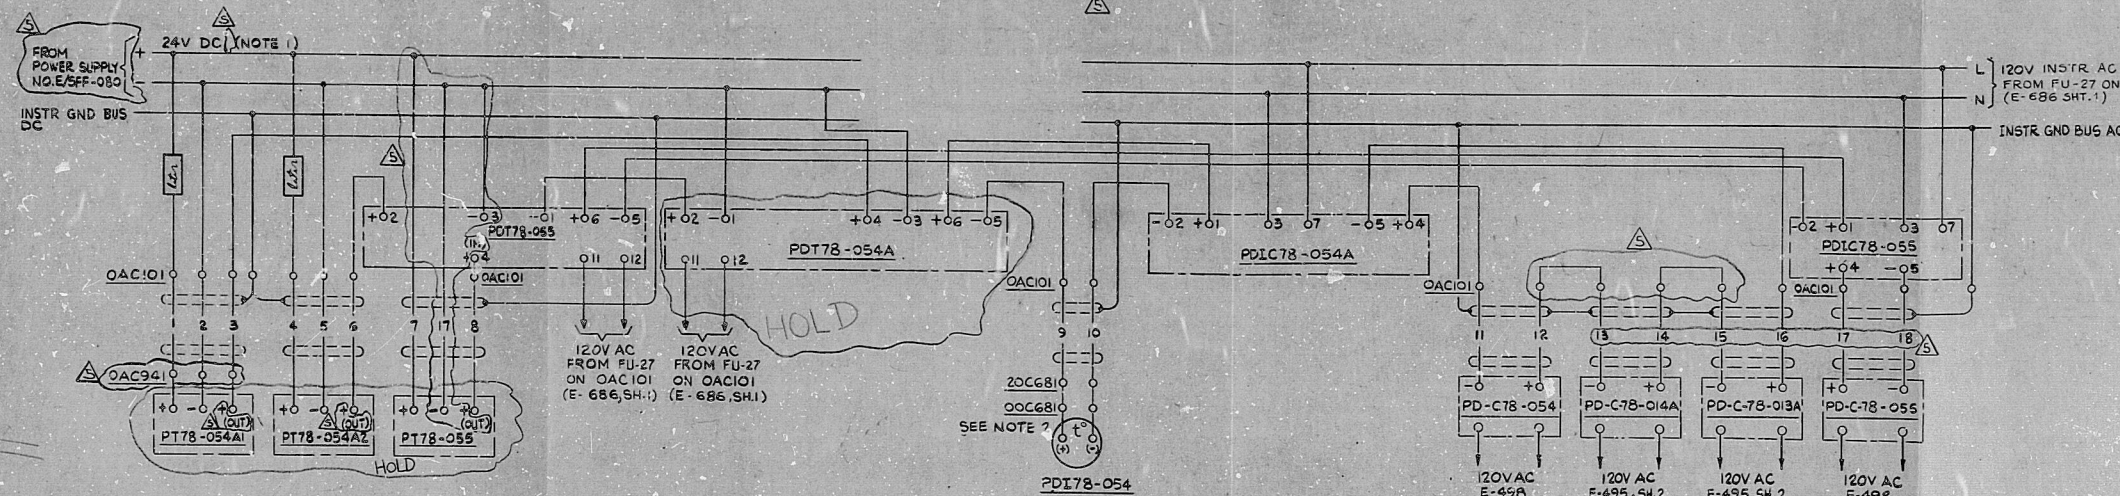

CONTROL ROOM LOOP A DIFFERENTIAL PRESSURE
SCHEME NO. OCIPD026

EQUIPMENT	EQUIP NO.	Q NO.	SCHEME NO.	SAFEGUARD SEPARATION CHANNEL	START-UP SYSTEM NO.	TRANSMITTER	DIFFERENTIAL PRESSURE CONTROL DAMPERS	INDICATOR	CONTROLLER	120V INSTR. AC FUSE NO.	24V DC PWR SUPPLY NO.
—	—	FU-27	E-686, SH.1


LOCATIONS


NOTES

- FOR 24V DC POWER SUPPLY, SEE SH. 1, THIS DWG.
- TERMINAL STRIP IS ON 20C681 AND CIRCUIT ELEMENT IS ON 00C681.

REVISIONS

NO.	DATE	DESCRIPTION	BY	CHKD

BECHTEL
SAN FRANCISCO

LIMERICK GENERATING STATION UNITS 1 & 2
PHILADELPHIA ELECTRIC COMPANY

SCHEMATIC DIAGRAM
HVAC MISCELLANEOUS SAFEGUARD INSTRUMENTATION
1 & 2 UNITS & COMMON

JOB NO. 8031
DRAWING NO. E-686
SH. 3 OF 15

TERA
APERTURE
CARD

RIDS

811030148

