
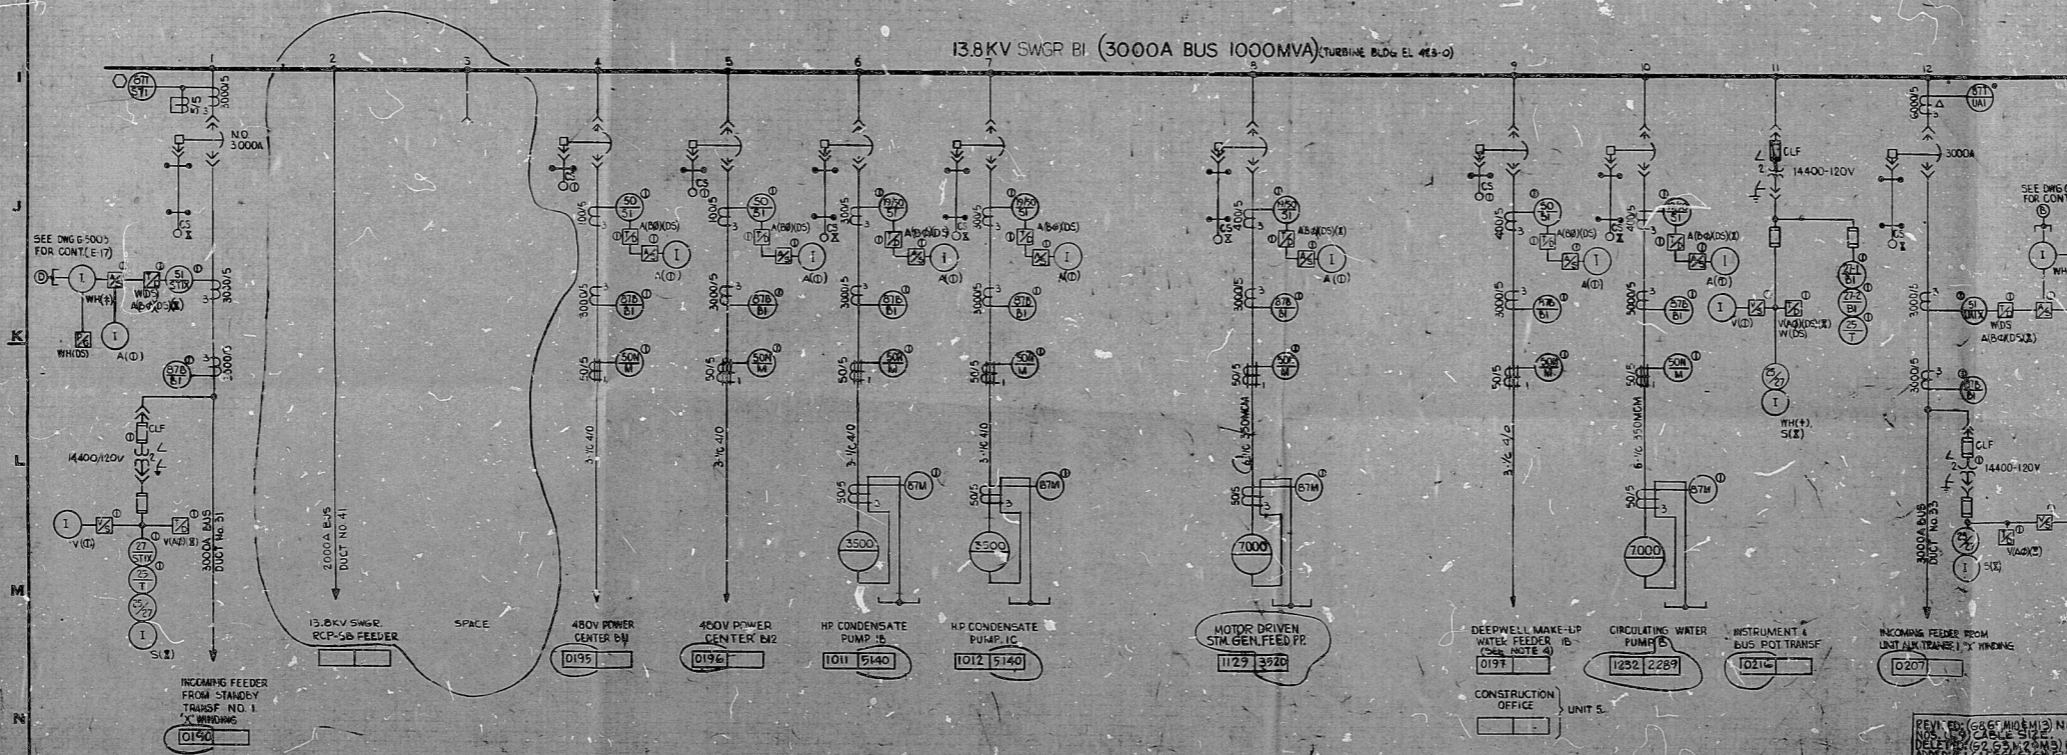


WPPS-3240-G-5017  
SHEET 5

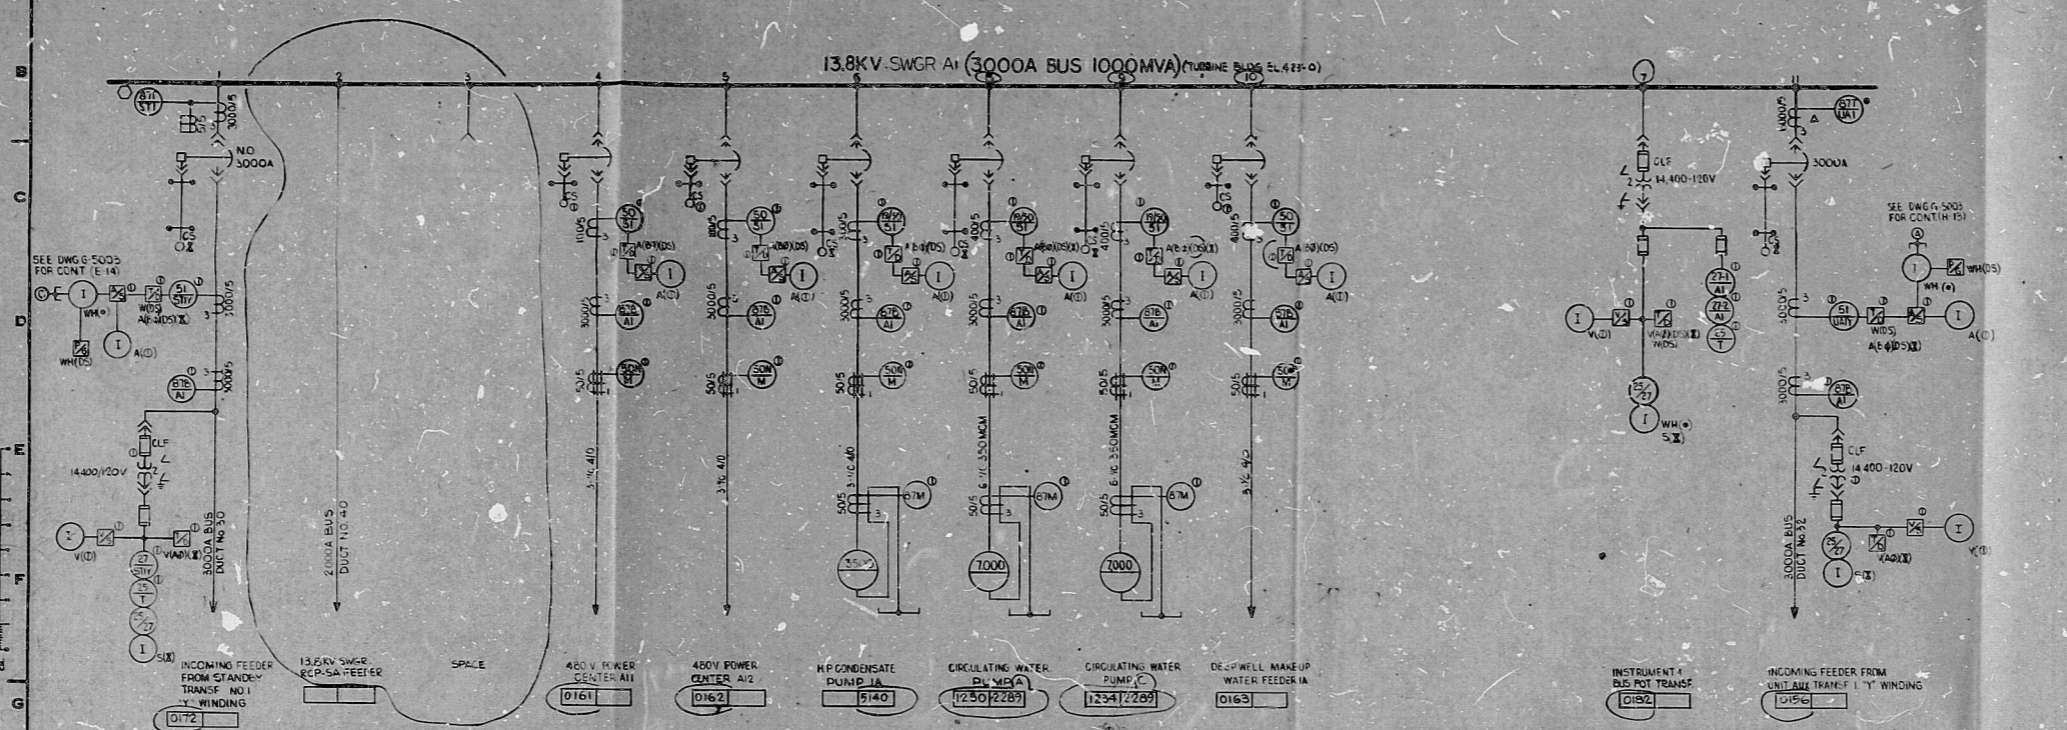

NOTE  
FOR GENERAL NOTES, 13.8KV SWITCHGEAR NOTES, SYMBOLS, ABBREVIATIONS & REFERENCE DRAWINGS, SEE DWG. G-5017-1.

WPPSS QUALITY CLASS II

PRC  
APERTURE  
CARD

EBASCO  
CONSTRUCTION SITE

WASHINGTON PUBLIC POWER SUPPLY SYSTEM  
NUCLEAR PROJECTS NO. 385  
1981-1300 MW INSTALLATION  
1983-1500 MW INSTALLATION

POWER DISTRIBUTION AND MOTOR DATA SHEET  
13.8KV SWITCHGEAR, BUS AI & BI

ERASCO SERVICES INCORPORATED

DATE: 11-27-79

WPPS-3240-G-5017

REV.	DATE	DESCRIPTION	BY	CHKD.
1	11-27-79	ISSUED FOR CONSTRUCTION	LM	
2	11-27-79	REVISED TO SHOW CONTROL PANELS	LM	

**RIDS**

8303210145

