
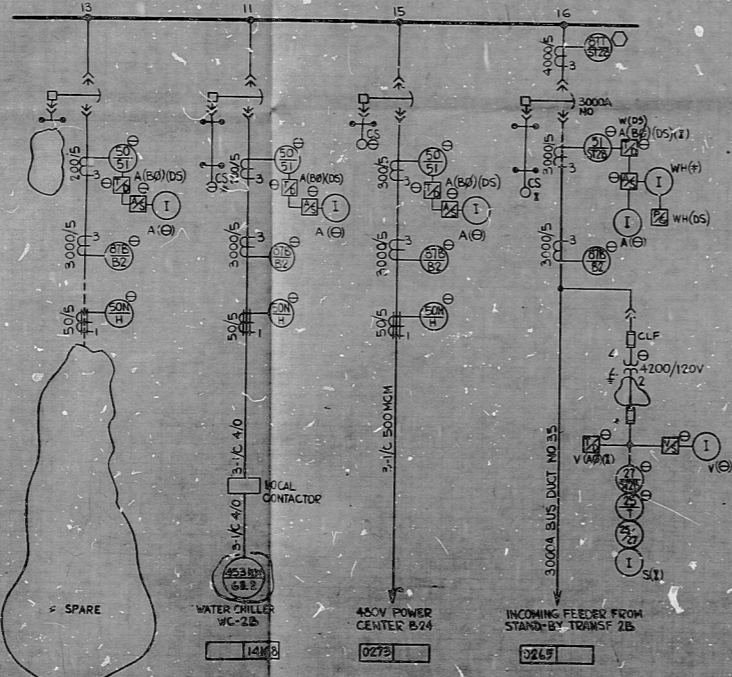


WPPS-3240-G-5017
SHEET 7

4.16 KV SWGR R2 (3000A BUS 350MVA) (TURBINE BLDG. EL. 423.0)

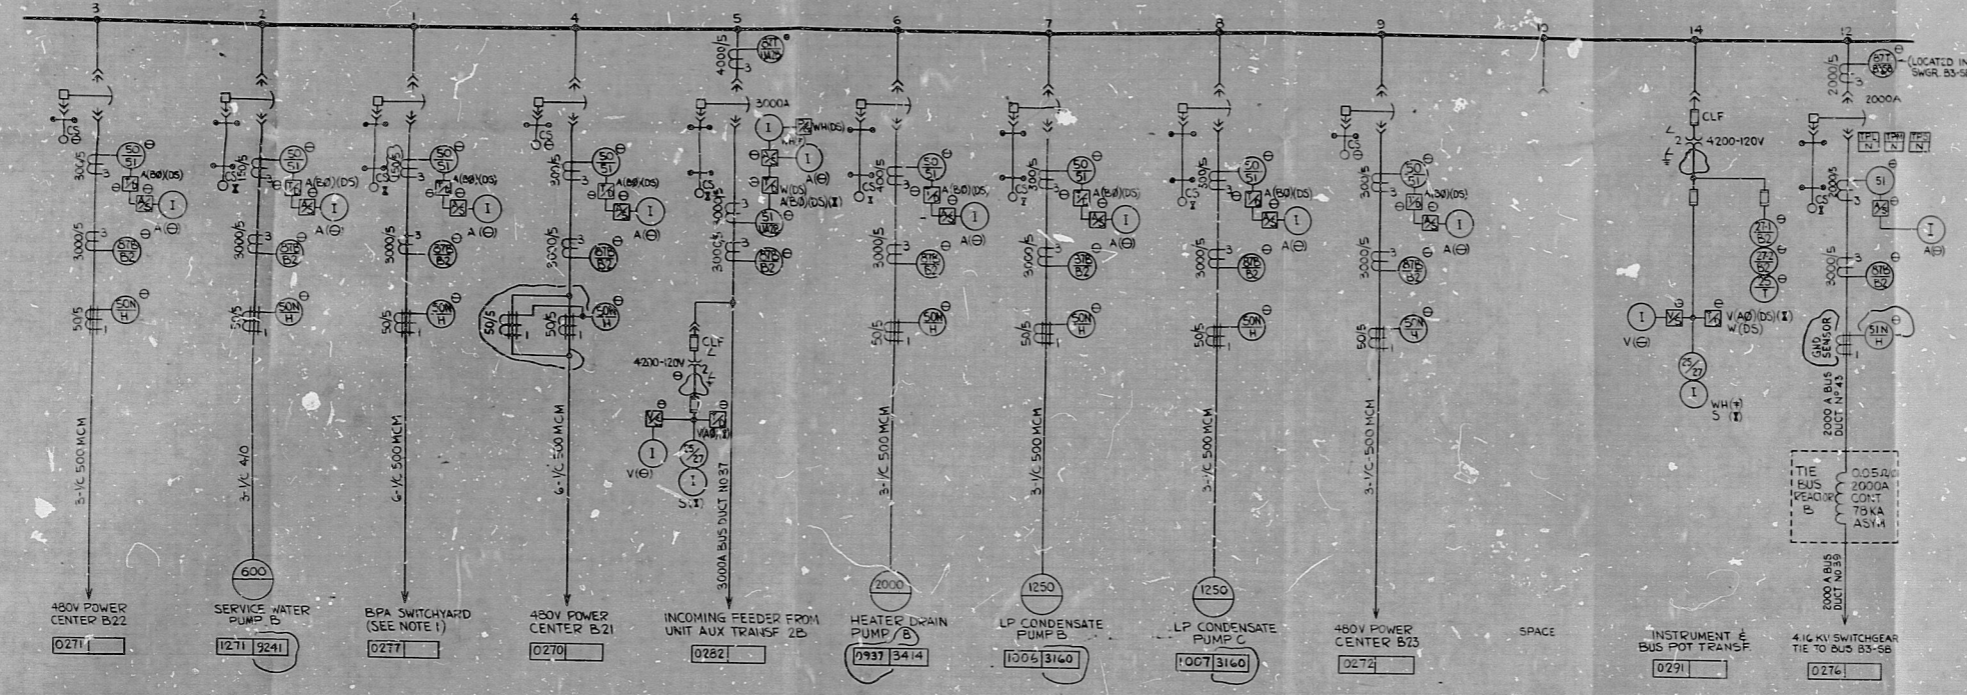

NOTE
FOR GENERAL NOTES, 4.16KV SWITCHGEAR
NOTES, SYMBOLS, ABBREVIATIONS
& REFERENCE DRAWINGS SEE DWG. G-5017
SHEET 1

WPPSS QUALITY CLASS II

PRC
APERTURE
CARD

WASHINGTON PUBLIC POWER SUPPLY SYSTEM
NUCLEAR PROJECTS NO 385
1984-1985 INSTALLATION
1984-1985 INSTALLATION
POWER DISTRIBUTION AND MOTOR DATA SHEET
4.16 KV SWITCHGEAR B2

REVISIONS: (A) UNIT #18 MADE SPARE, DISCONNECTED
ADDED: (B) CHANGE AND CT TO AGREE WITH M&E INVOICES, GS, GS

NO.	DATE	BY	CHKD.

DATE: 2-14-77
SHEET: 7 OF 7
WPPSS
0-5017

RIDs

8303210148

