


WRPS-3240-G-5017
SHEET B

4.16 KV SWGR A2 (3000A BUS 350MVA) (TURBINE BLDG EL. 423'-0")

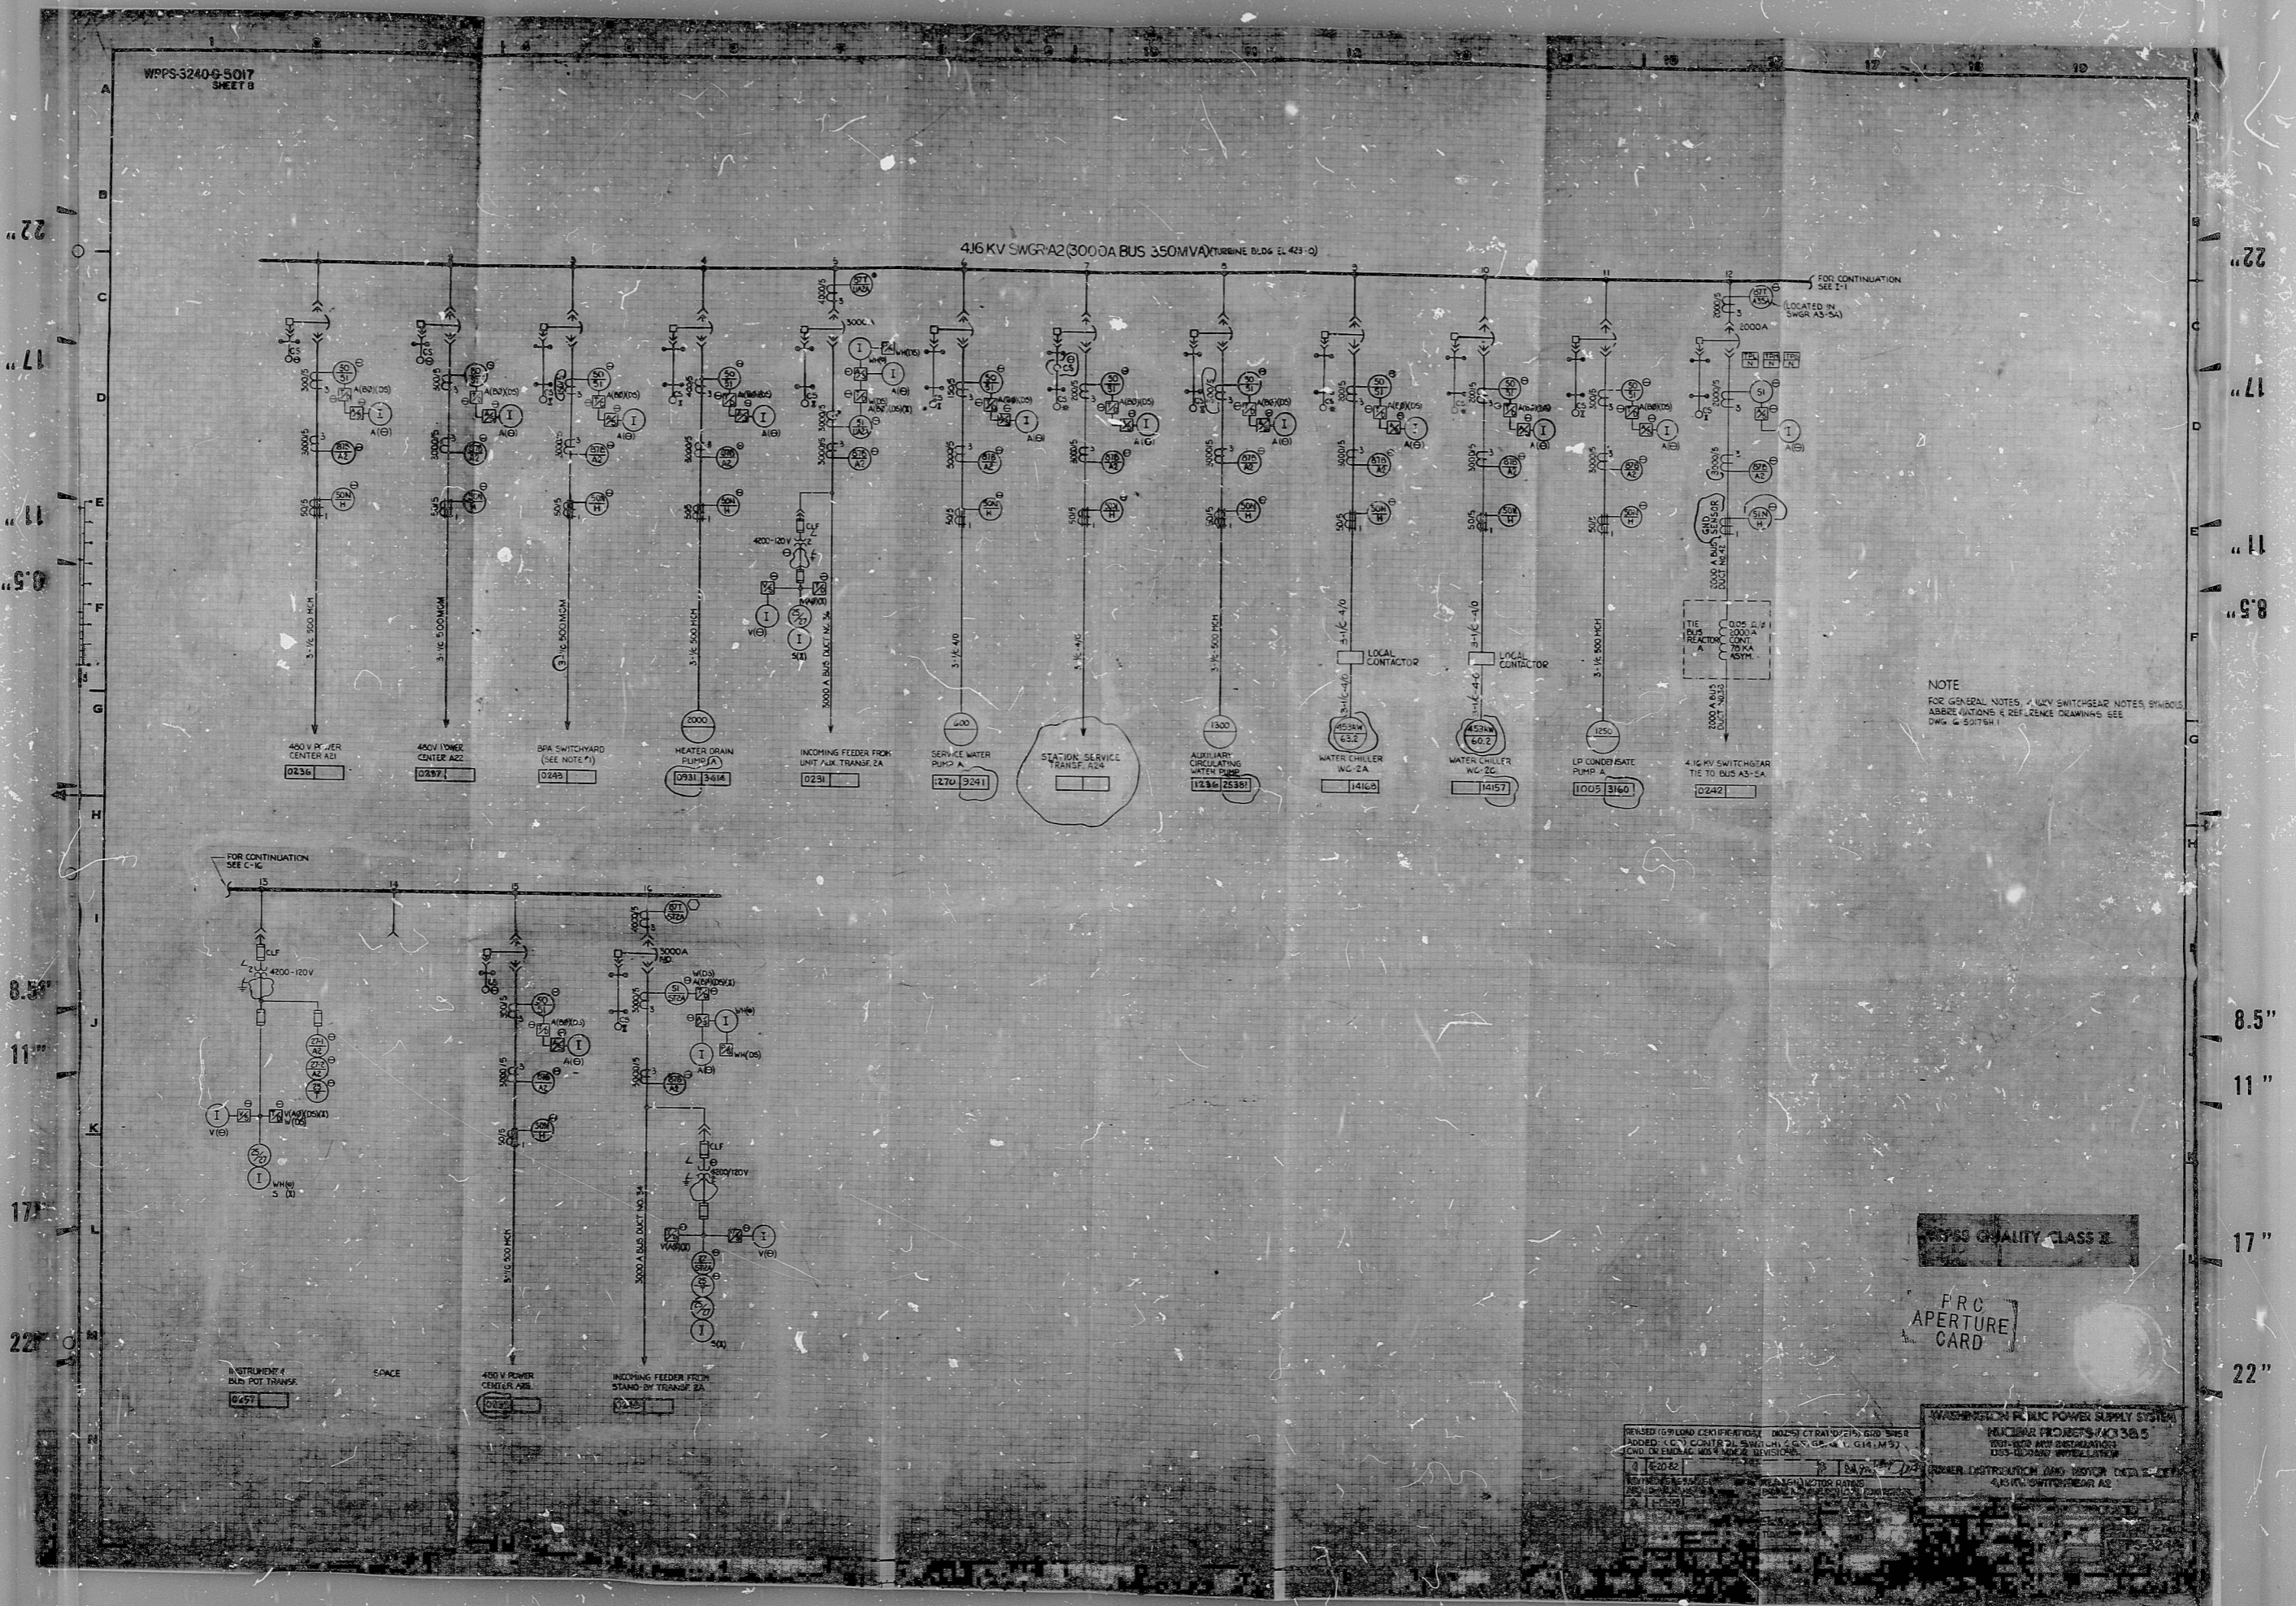

NOTE
 FOR GENERAL NOTES, 4.16KV SWITCHGEAR NOTES, SYMBOLS,
 AND REVISIONS & REFERENCE DRAWINGS SEE
 DWG. G-5017B-1


FRC
 APERTURE
 CARD


WASHINGTON PUBLIC POWER SUPPLY SYSTEM
 4.16KV SWITCHGEAR A2

KWS

8303210151

