
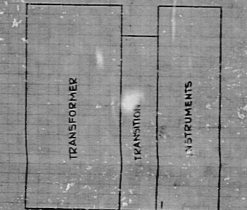
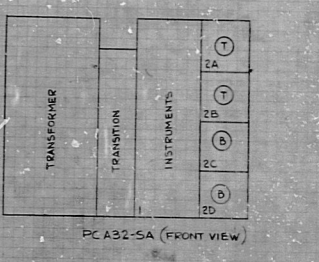
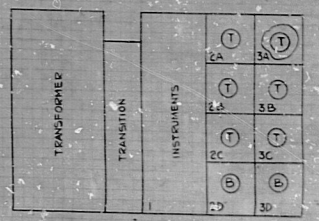


34

34

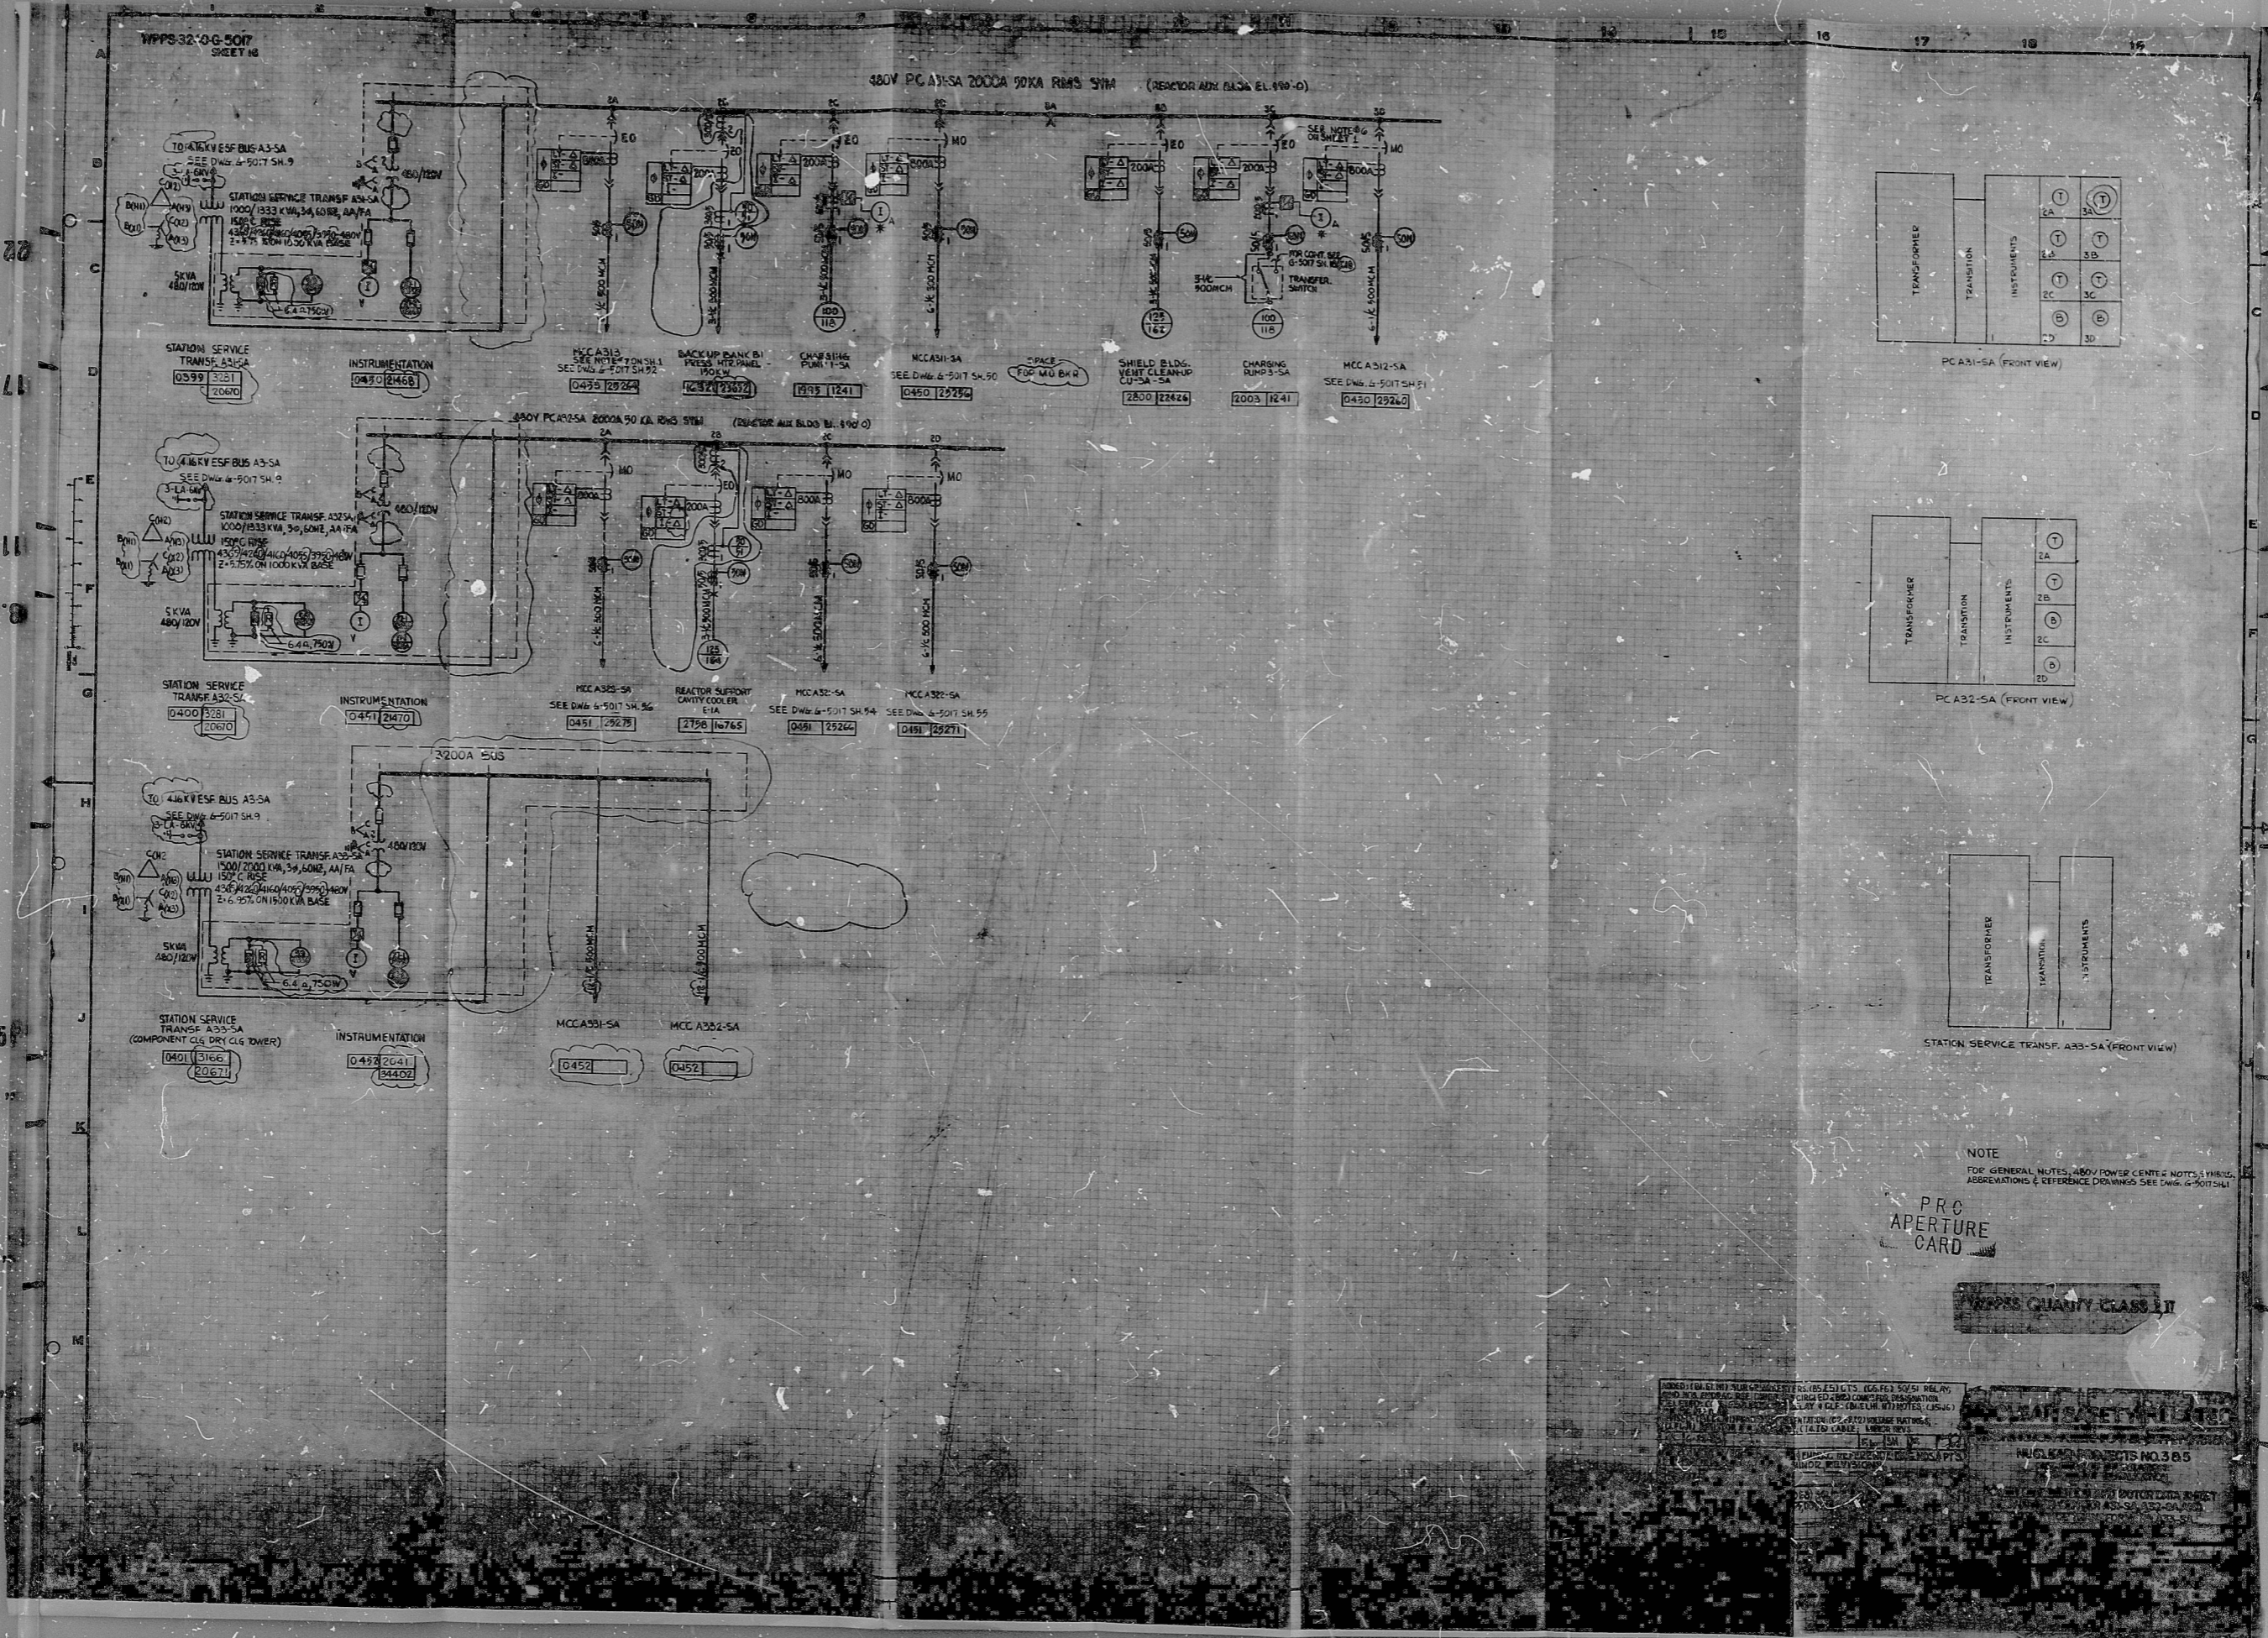

NOTE  
FOR GENERAL NOTES, ABOVE POWER CENTER, NOTES, SYMBOLS,  
ABBREVIATIONS & REFERENCE DRAWINGS SEE DRAWING 5017 SH-1

PRO  
APERTURE  
CARD


NUCLEAR PROJECTS NO. 385  
APERTURE CARD  
WPPSS QUANTITY CLASS 111

22"  
17"  
11"  
8.5"  
11"  
17"  
22"

22"  
17"  
11"  
8.5"  
11"  
17"  
22"

**RIDS**

8303210168

