

34

34

22

22

17

17

11

11

8.5

8.5

8.5

8.5

11


11

17

17

22

22

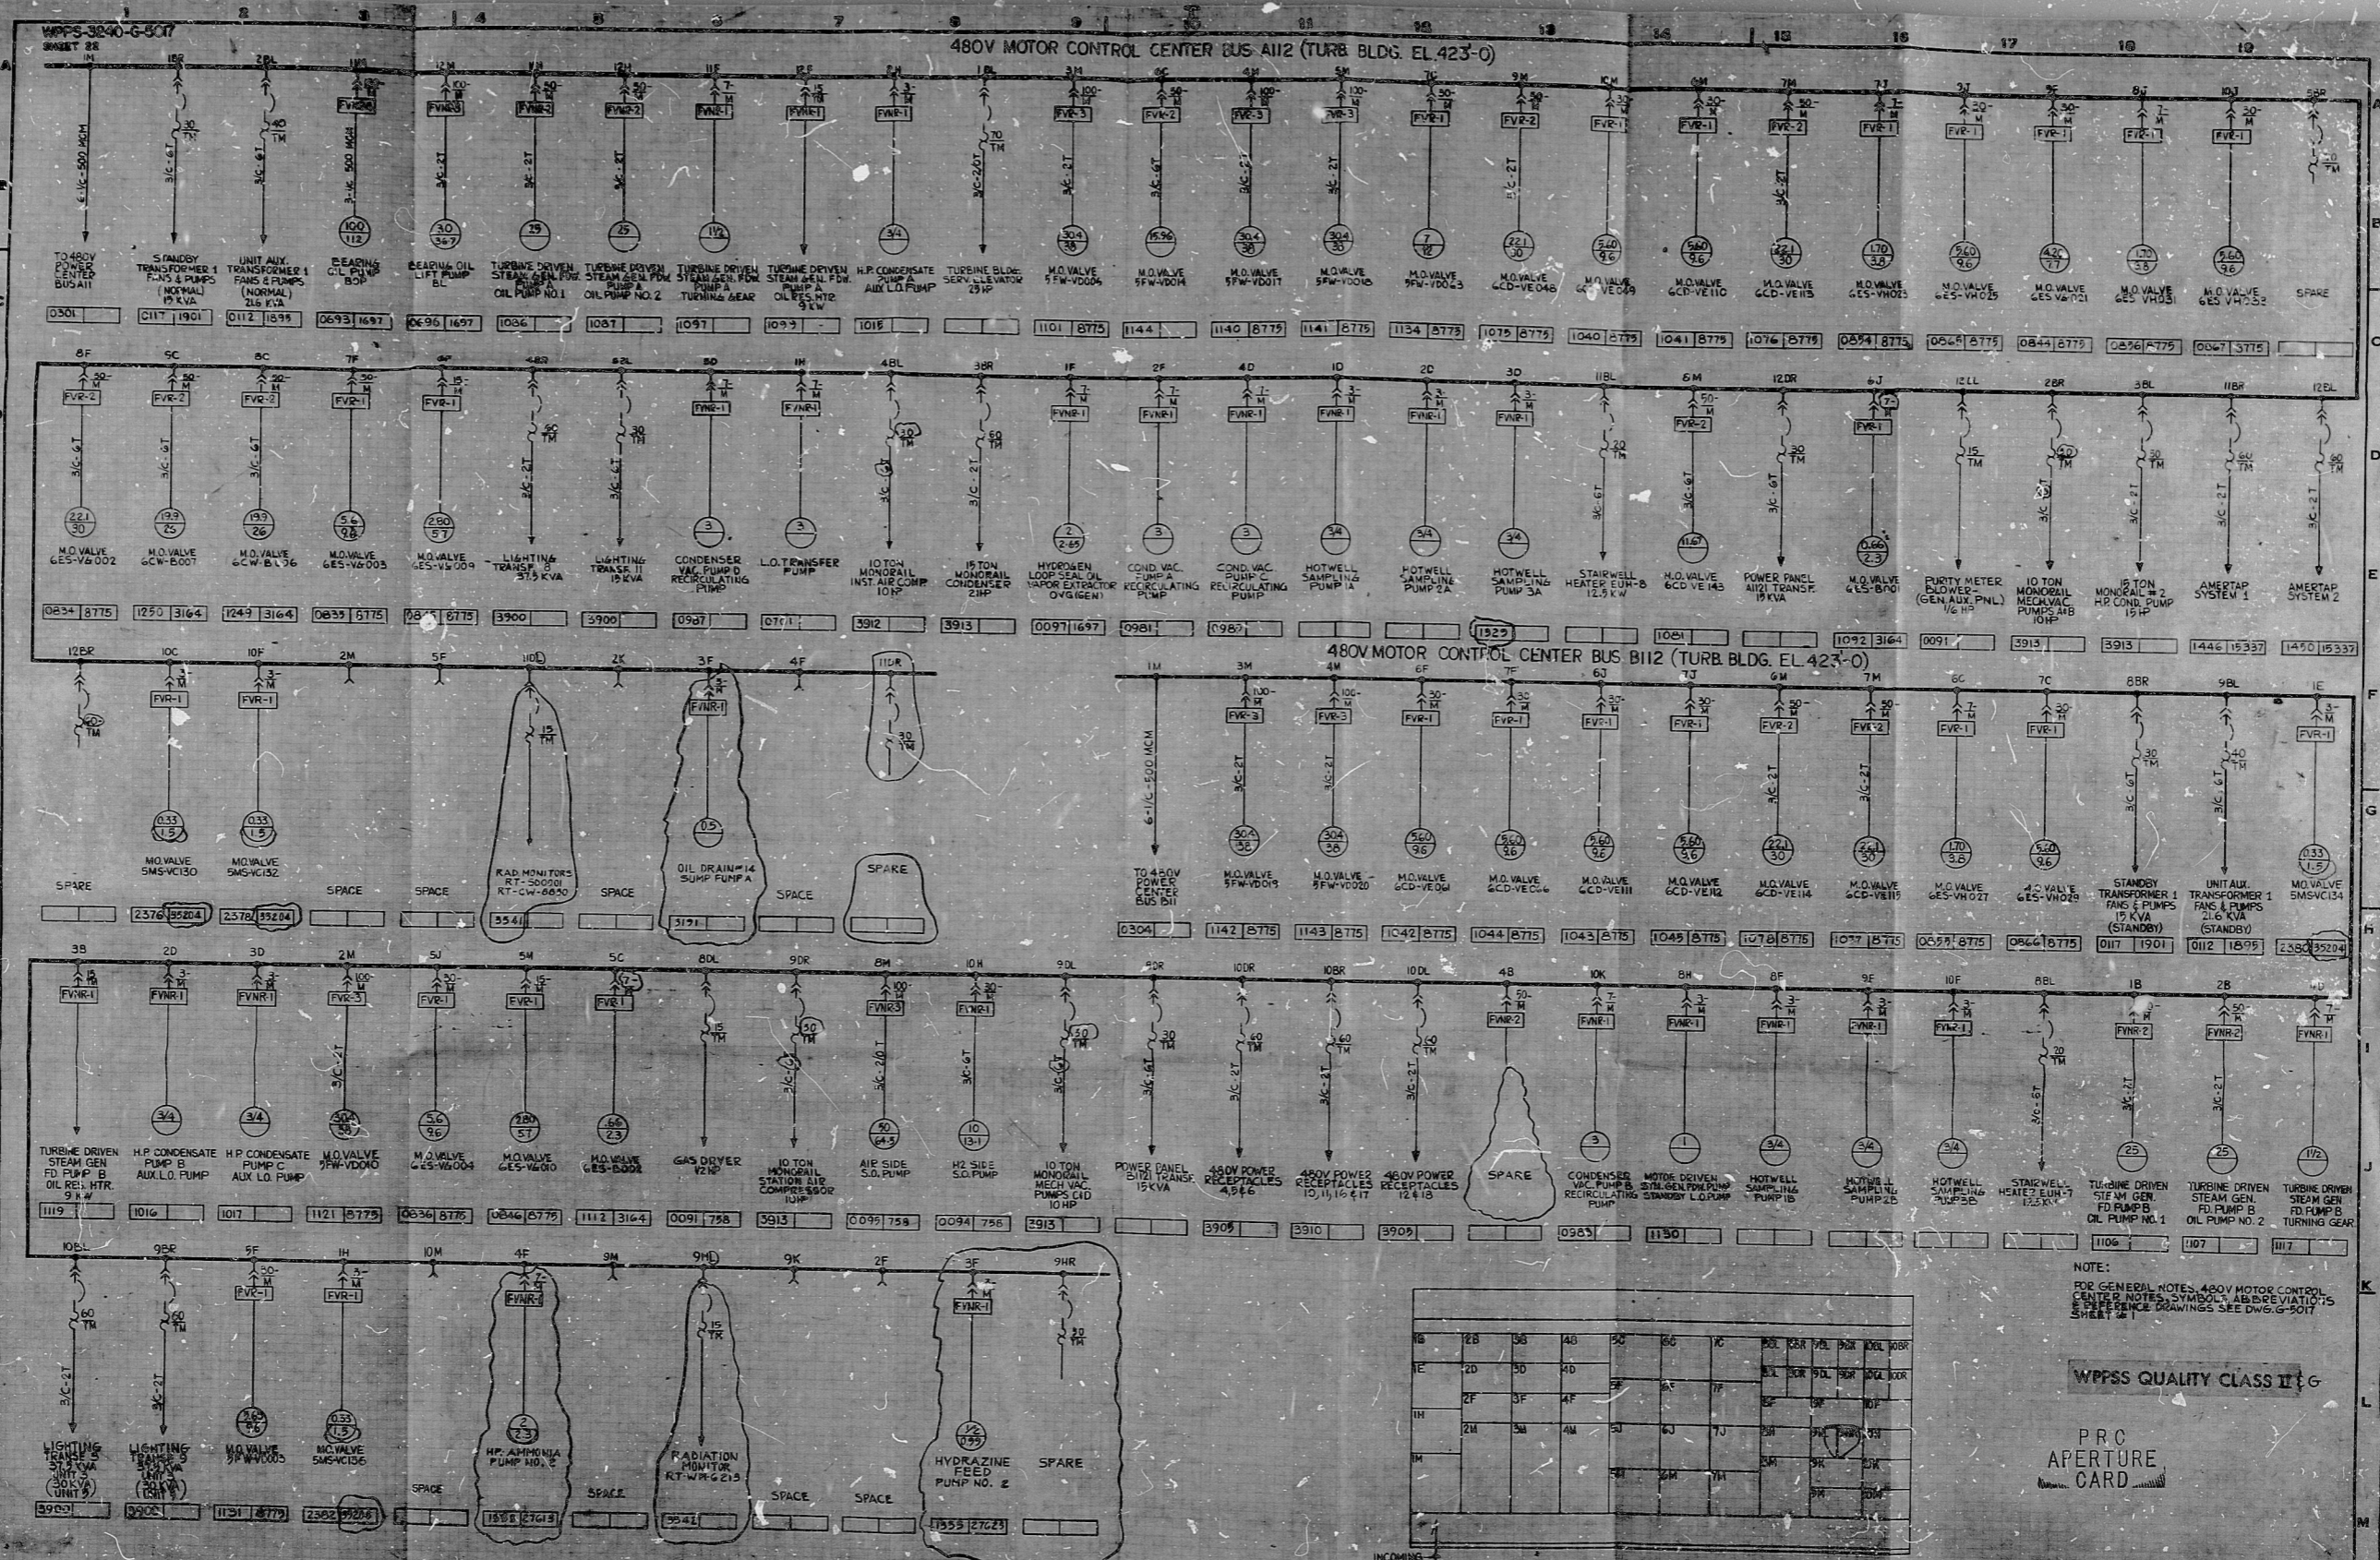

MCC A112 (FRONT VIEW)
(SEE DWG. G-907 FOR MAIN)


NOTE:

WPSS QUALITY CLASS II-G

PRC APERTURE CARD

WASHINGTON PUBLIC POWER SUPPLY SYSTEM
NUCLEAR PROJECTS NO. 808
480V MOTOR CONTROL CENTER A112 & B112

34

KODAK

8303210174

