

34

34

22

22

17

17

11

11

8.5

8.5

8.5

8.5

11



11

17

17

22

22

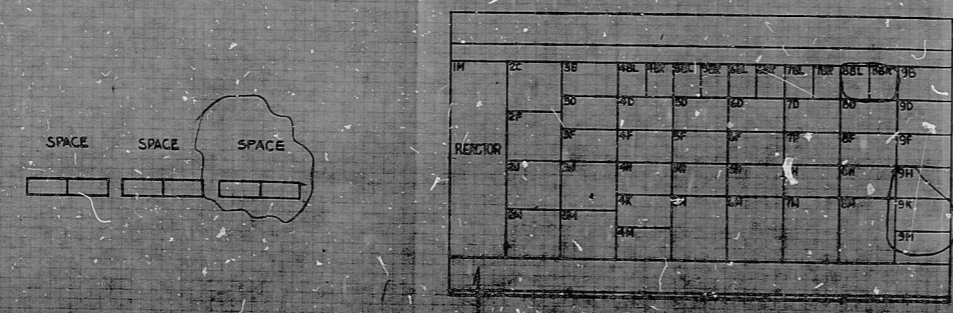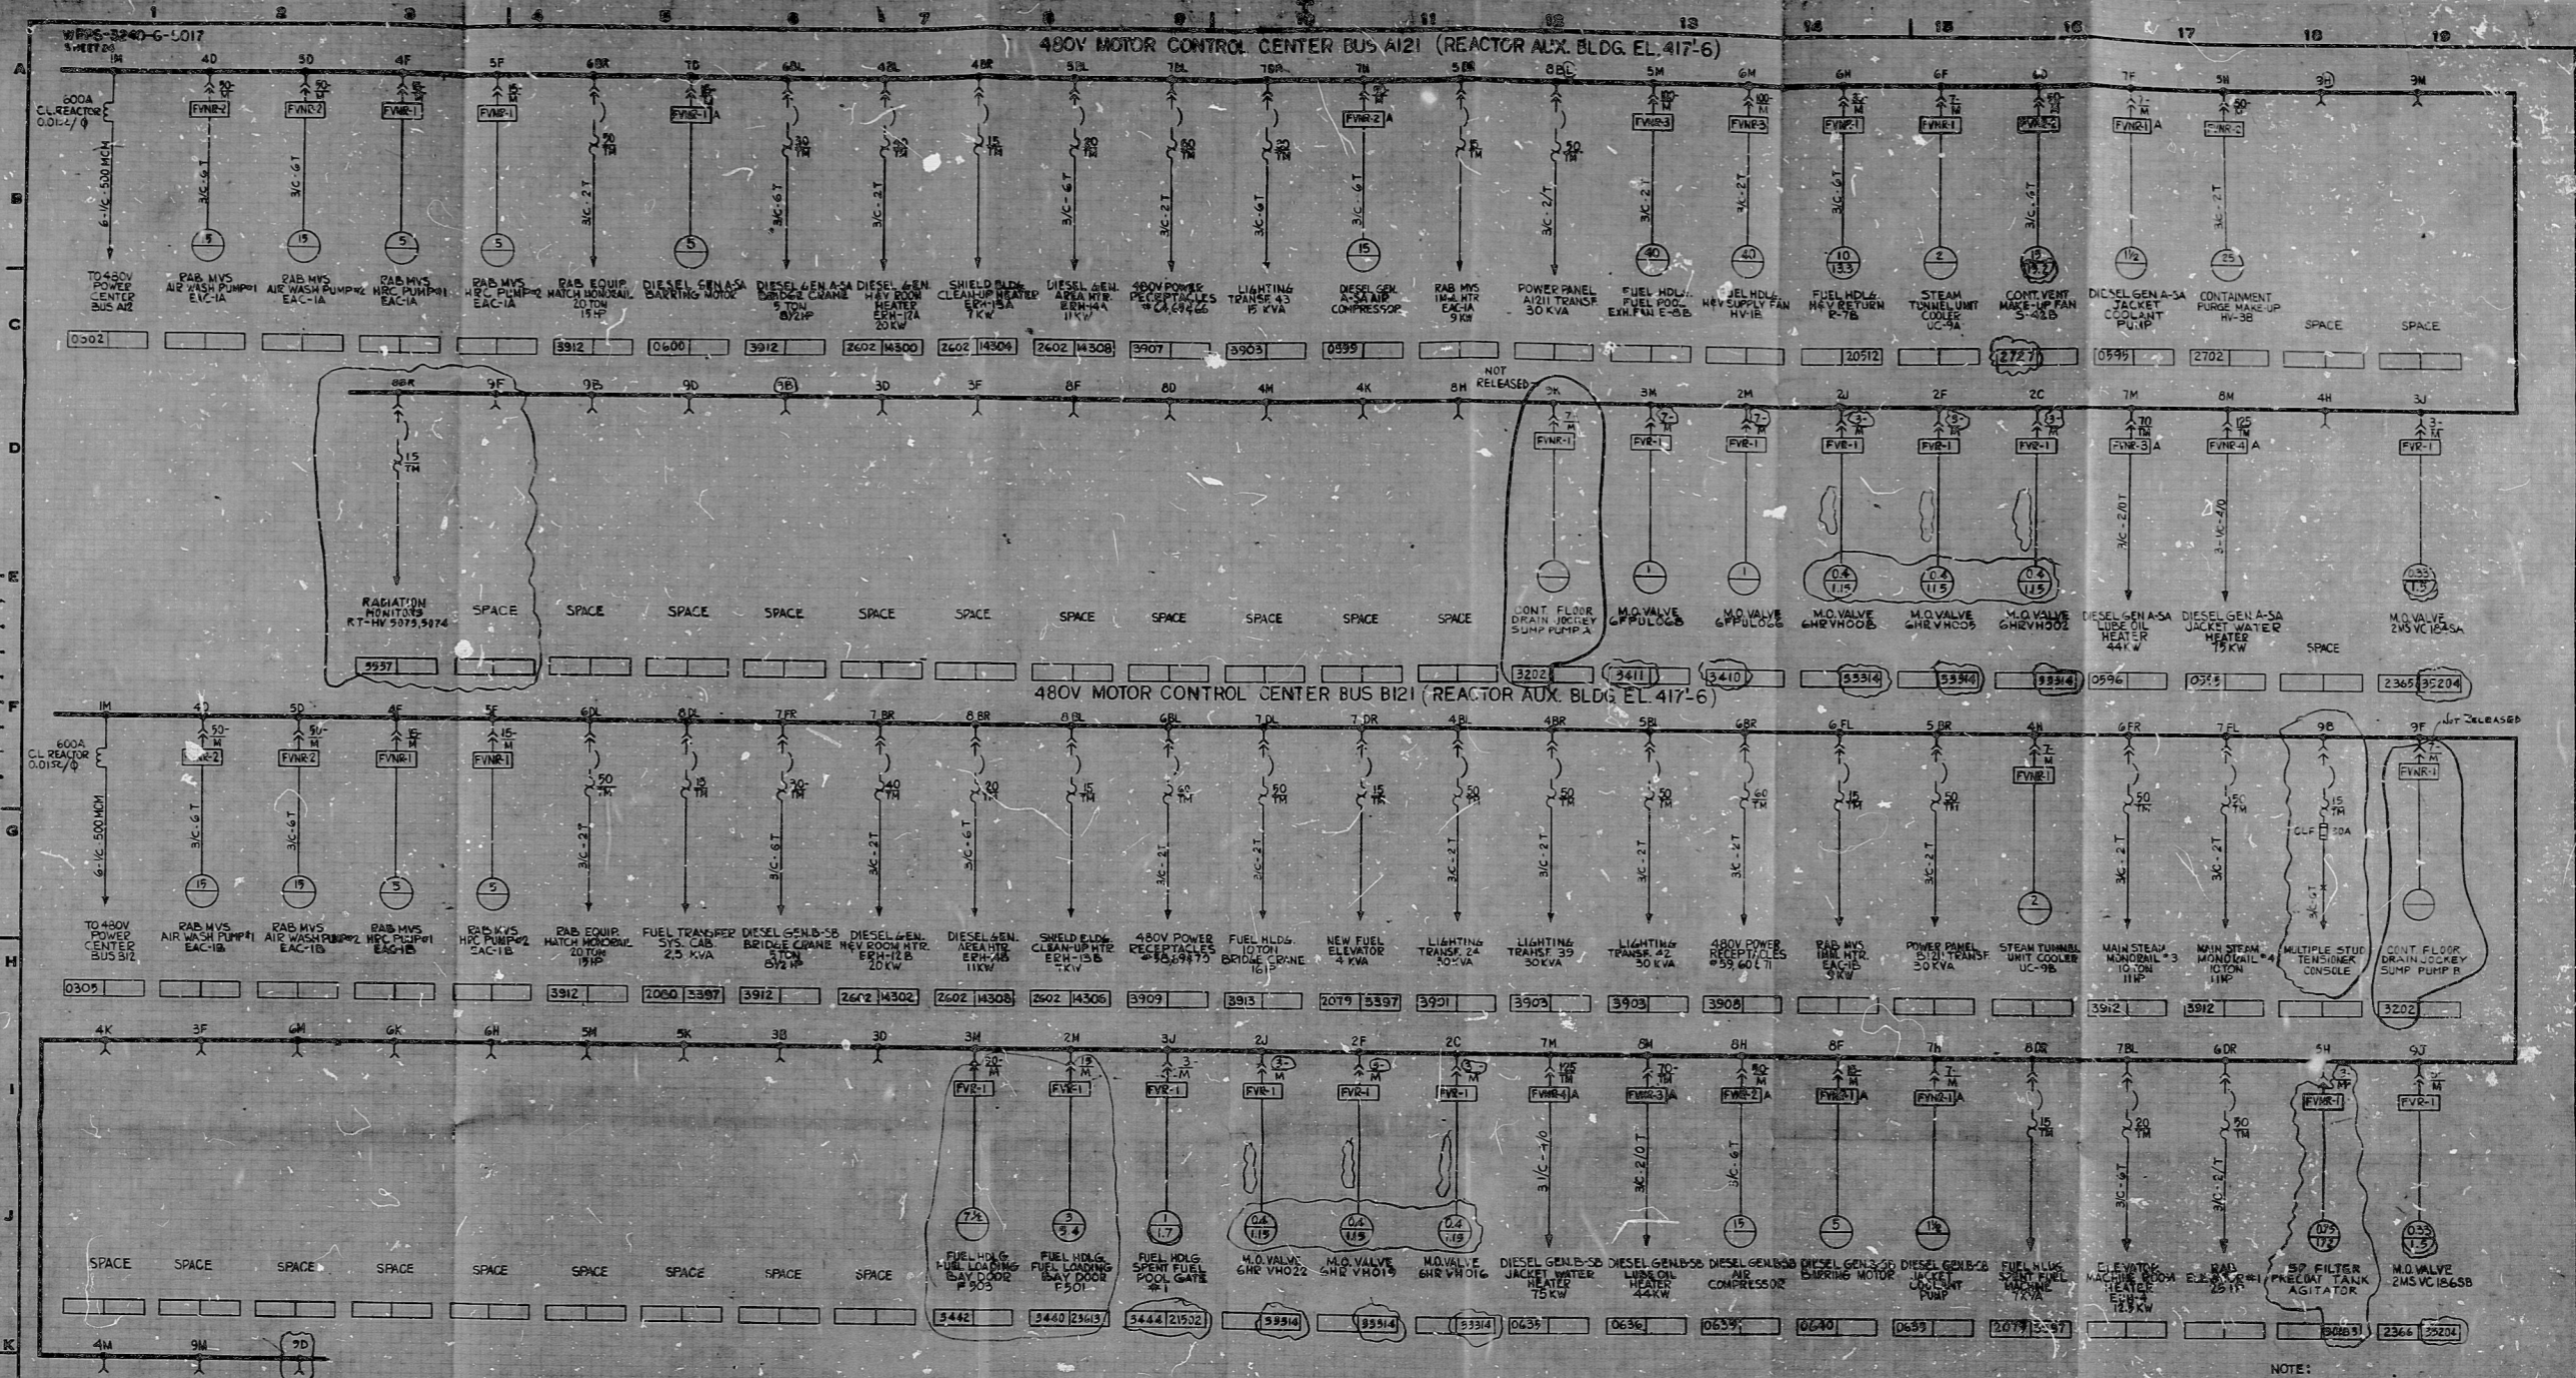

NOTE:  
 PFR GENERAL NOTES 480V MOTOR CONTROL CENTER NOTES SYMBOL ABBREVIATIONS & REFERENCE DRAWINGS SEE DWG 6-5011 SHEET 1

WPPSS QUALITY CLASS 220  
 PRC APERTURE CARD

WASHINGTON PUBLIC POWER SUPPLY SYSTEM  

**RIDS**

8303210175

