

34

34

22

22

17

17

11

11

8.5

8.5

8.5

8.5

11




11

17

17

22

22

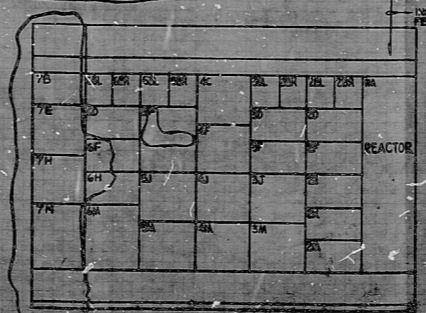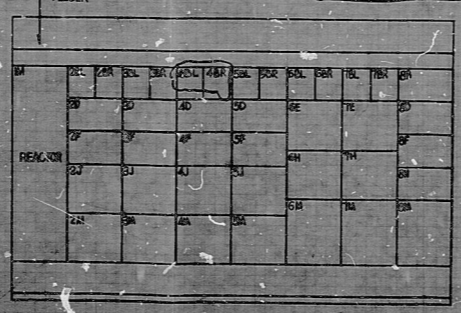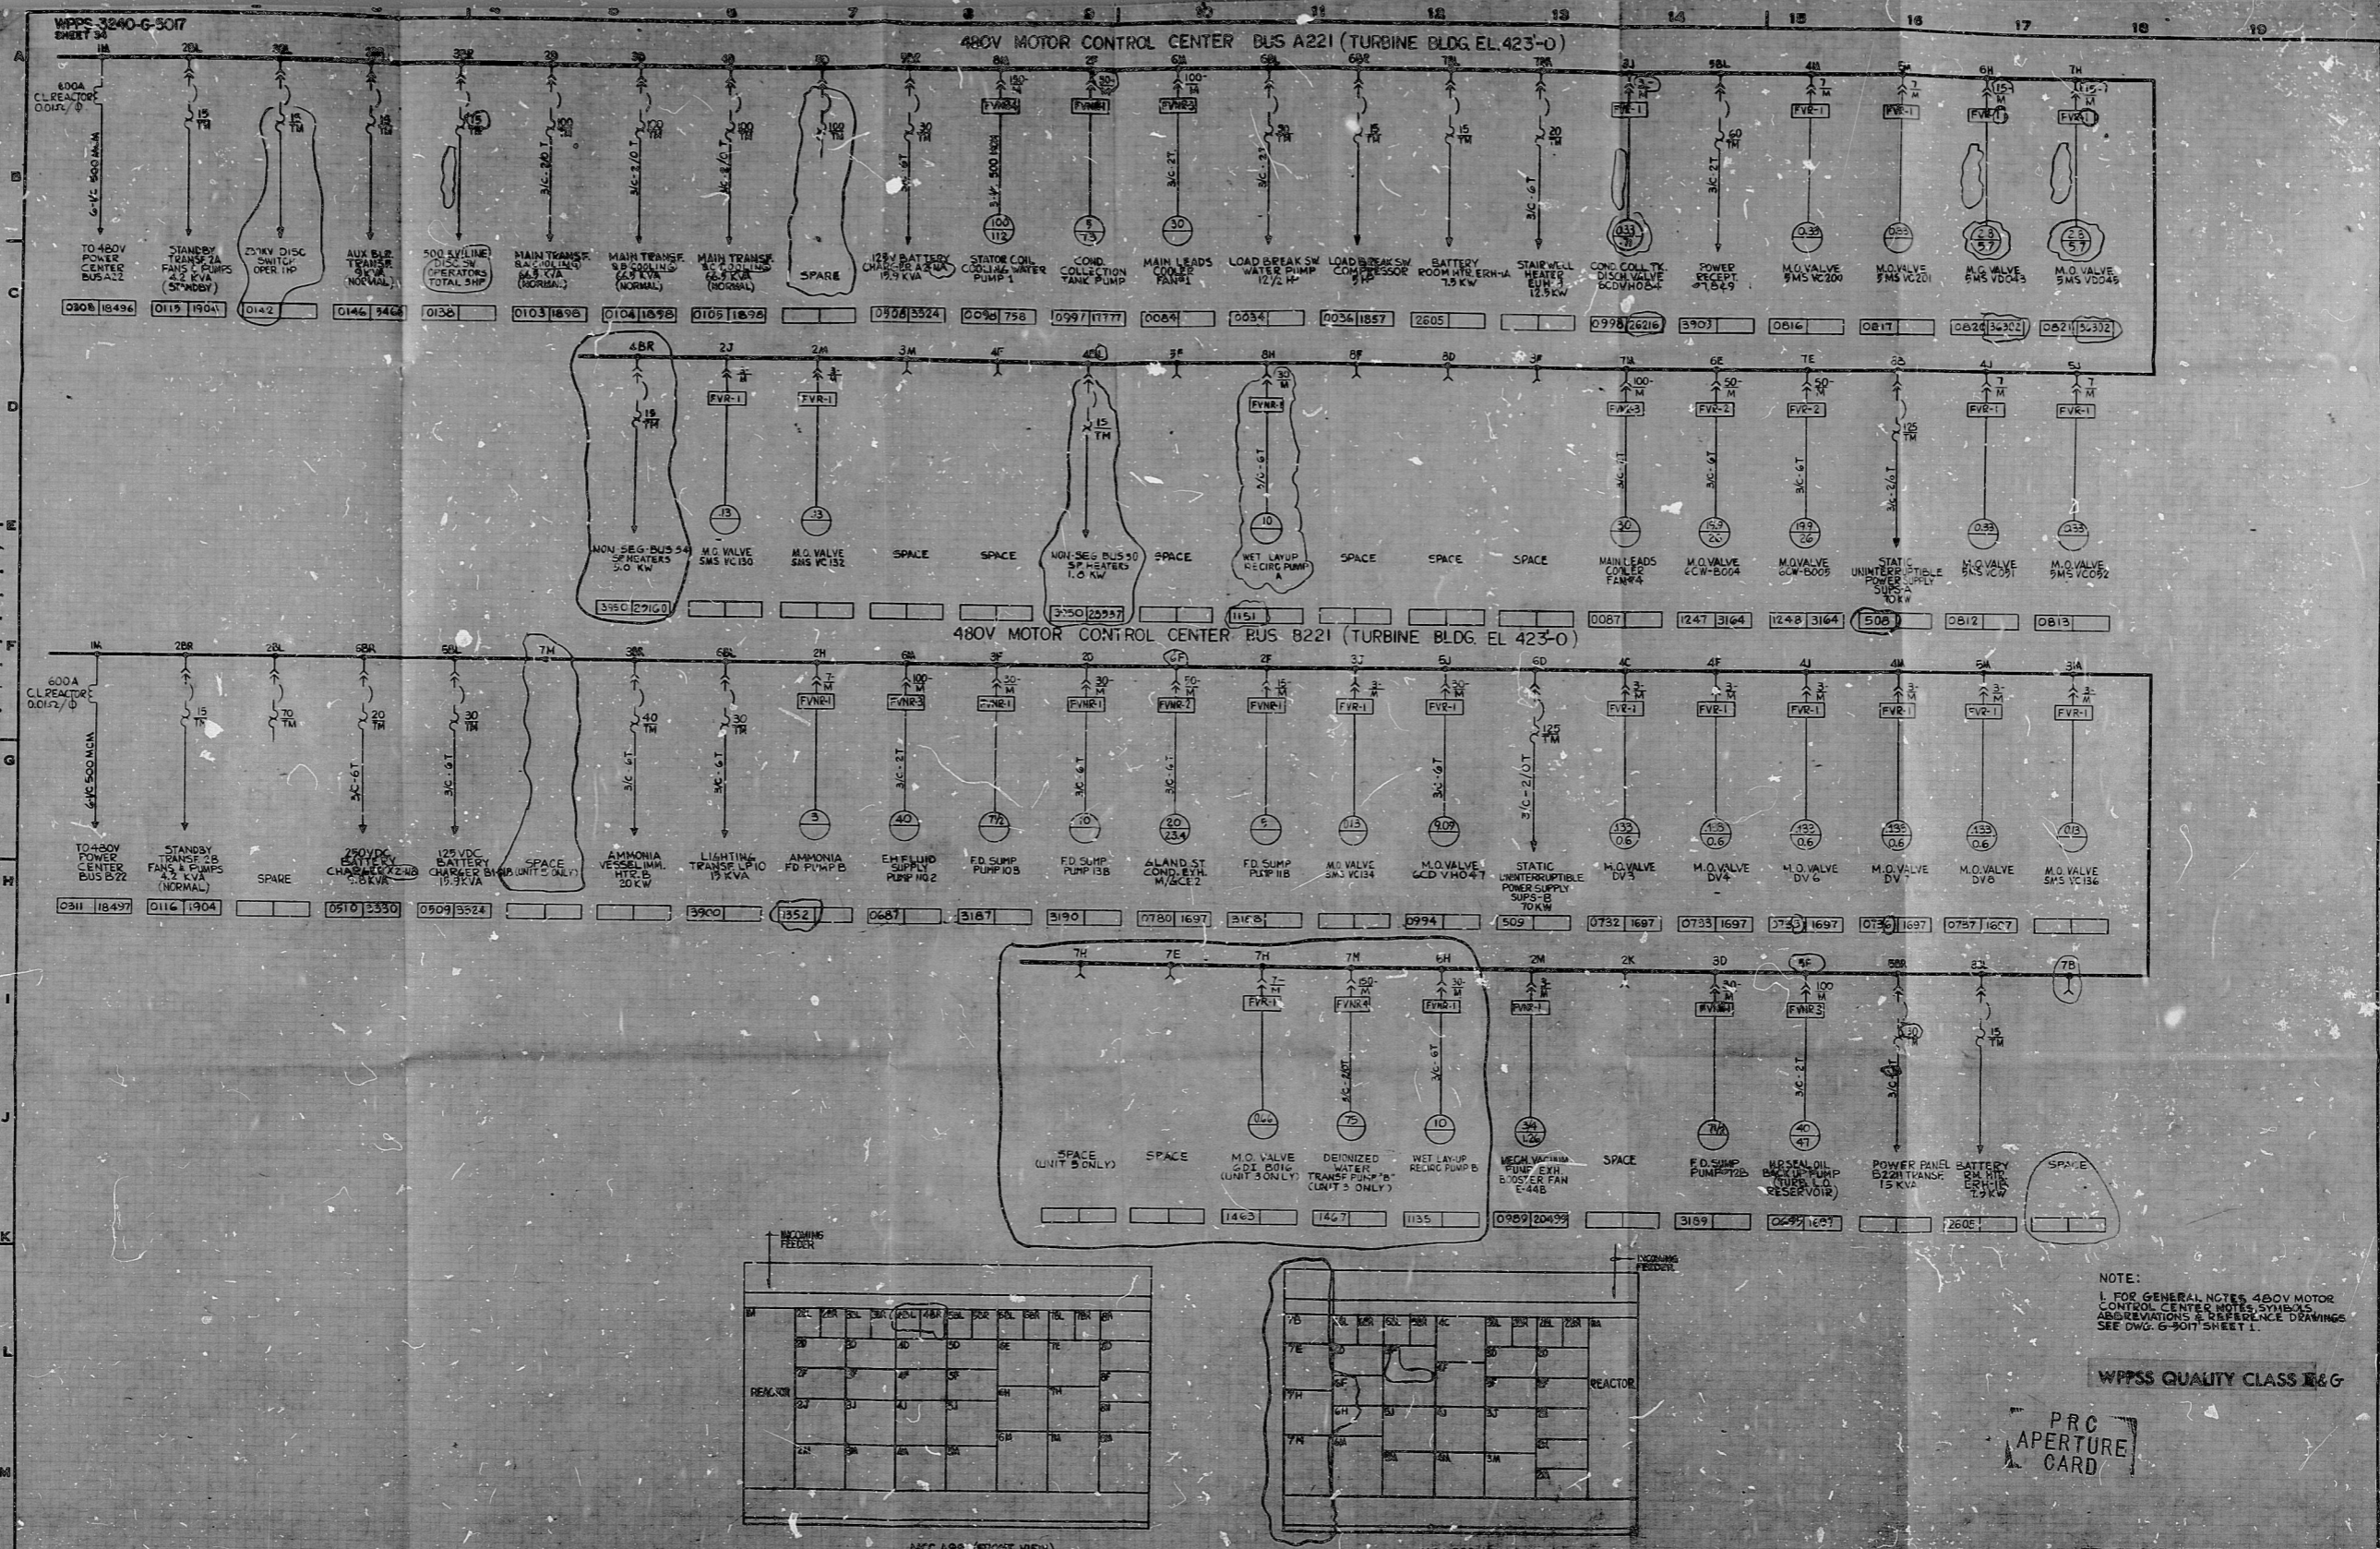

WPPSS QUALITY CLASS R&G

PRC APERTURE CARD

NOTE: 1. FOR GENERAL NOTES 480V MOTOR CONTROL CENTER, NOTES, SYMBOLS, ABBREVIATIONS & REFERENCE DRAWINGS SEE DWG. G-9001 SHEET 1.



**RIDS**

8303210187

