

34

34

22

22

17

17

11

11

8.5

8.5

8.5

8.5

11


11

17


17

22


22

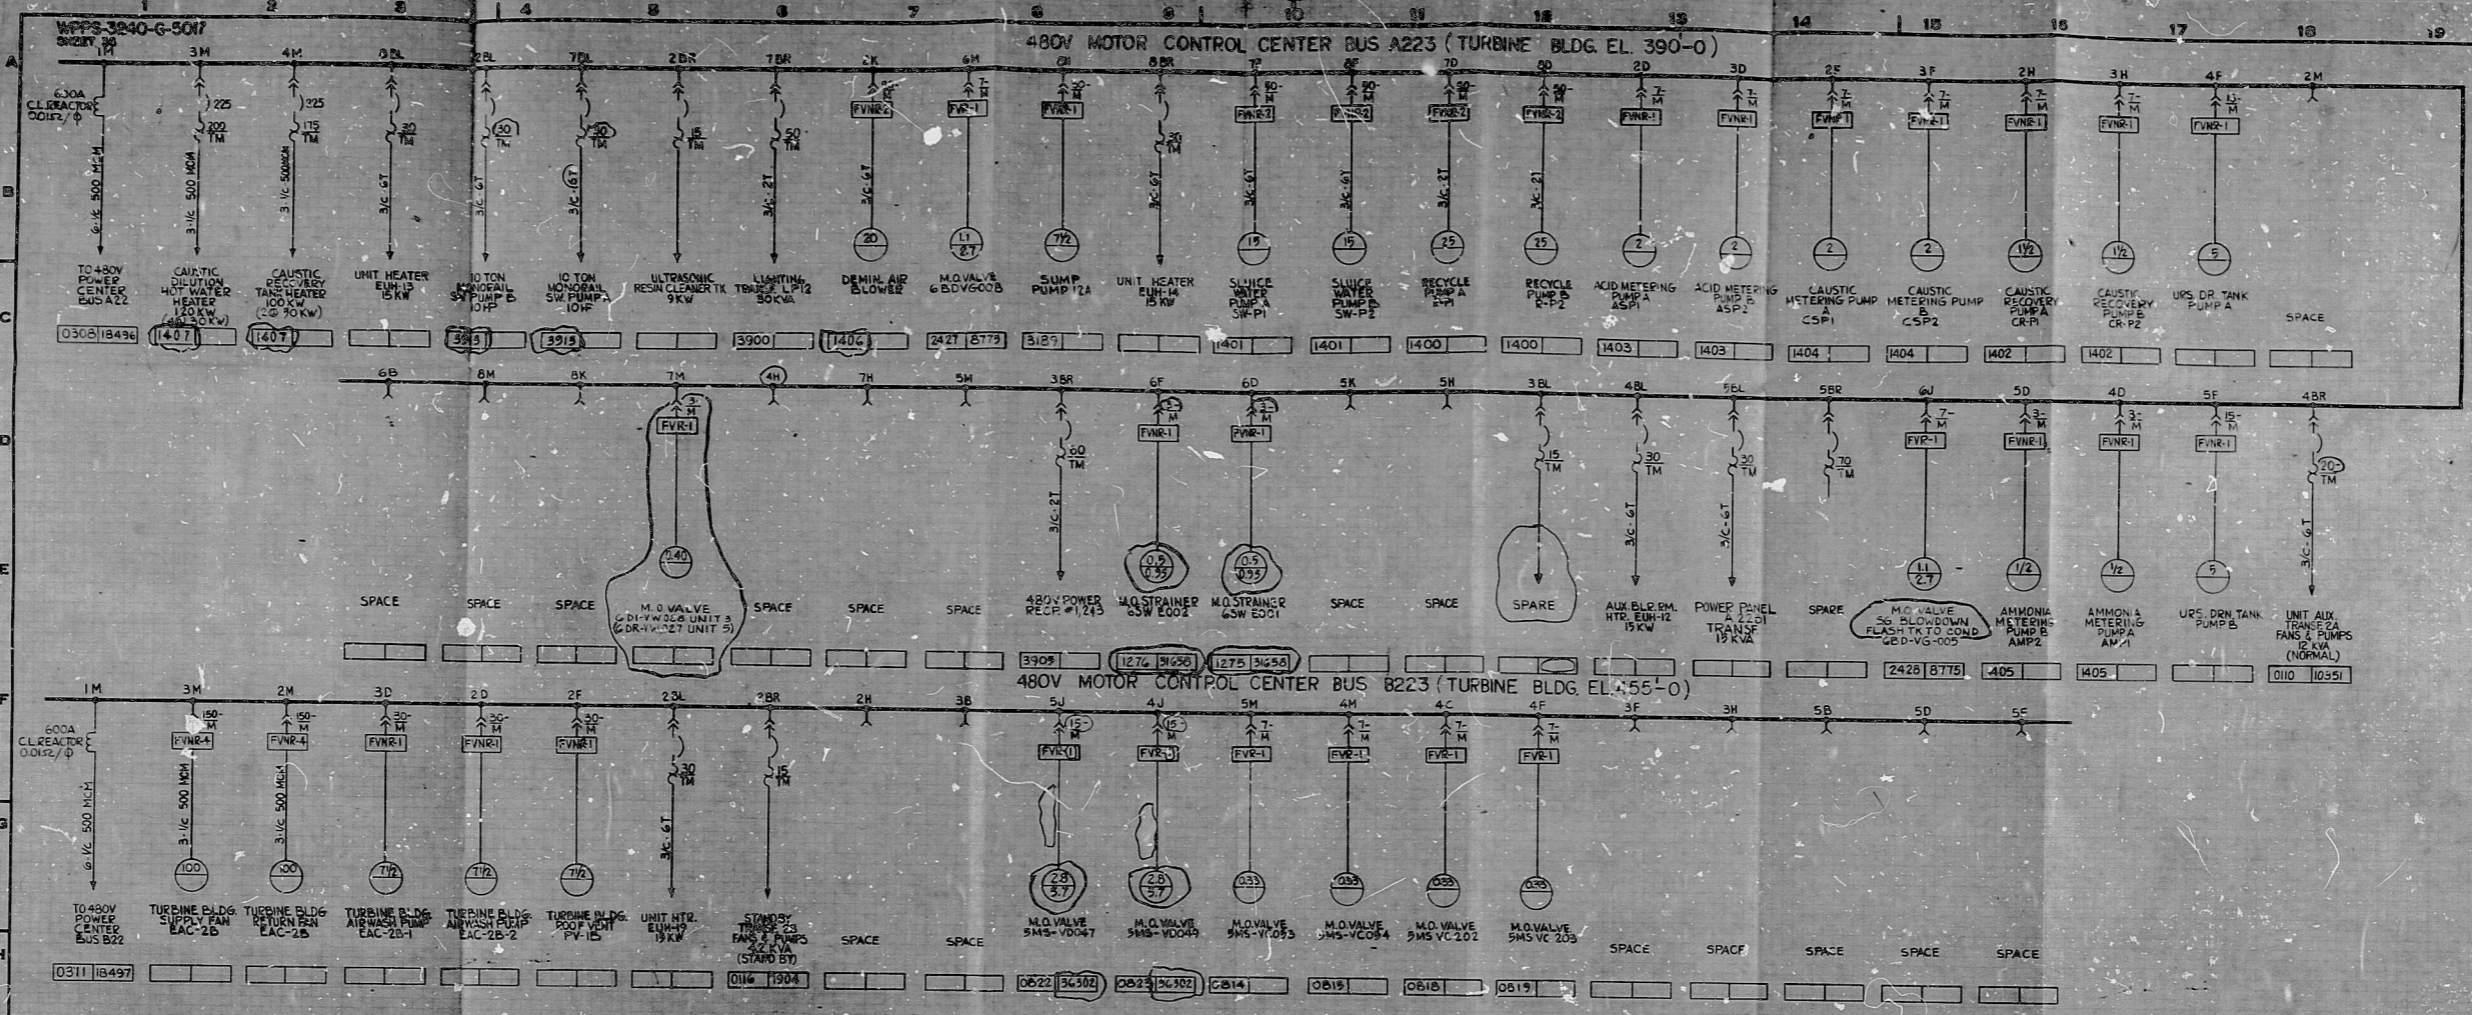

NOTE:  
 1. FOR GENERAL NOTES, 480V MOTOR CONTROL CENTER NOTES, SYMBOL ABBREVIATIONS, REFERENCE DRAWINGS, SEE DWG. G-5017 SHEET 1

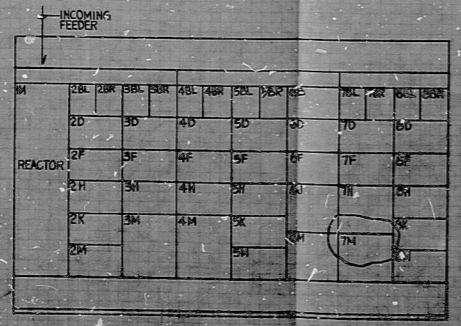

MCC A223 (FRONT VIEW)

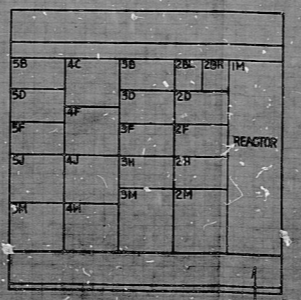

MCC B223 (FRONT VIEW)

WPPSS QUALITY CLASS J&G

PRC APERTURE CARD

WARRICKON NUCLEAR POWER SUPPLY SYSTEM  
 NUCLEAR POWER SYSTEMS  
 POWER DISTRIBUTION CENTER SHEET  
 G-5017 SHEET 1

**RIDS**

8303210190

