
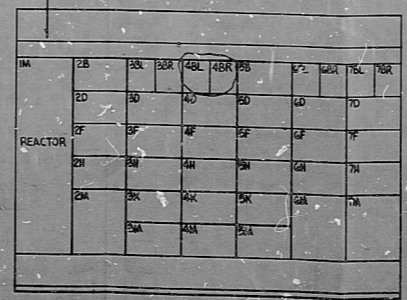


NOTE:
 1 FOR GENERAL NOTES, 480V MOTOR CONTROL CENTER NOTES, SYMBOLS, ABBREVIATIONS & REFERENCE DRAWINGS SEE DWG. G-5017 SHEET 1.

WPSS QUALITY CLASS I & G

PRC APERTURE CARD

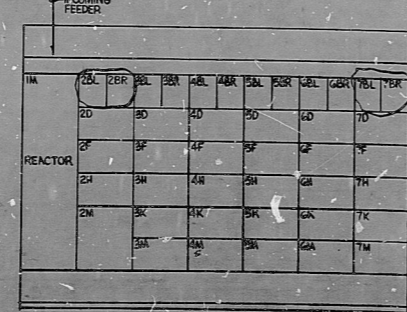

WASHINGTON PUBLIC POWER SUPPLY SYSTEM
 NUCLEAR PROJECTS NO. 3 & 5

POWER DISTRIBUTION & MOTOR DATA SHEET
 480V MOTOR CONTROL CENTER A232 & B232

ESASCO SERVICES INCORPORATED

DATE: 3-27-79
 SHEET NO. 39
 WPPSS-2440
 G-5017

RID's

8303210196

