

34

34

22

22

17

17

11

11

8.5

8.5

8.5

8.5

11


11

17

17

22

22

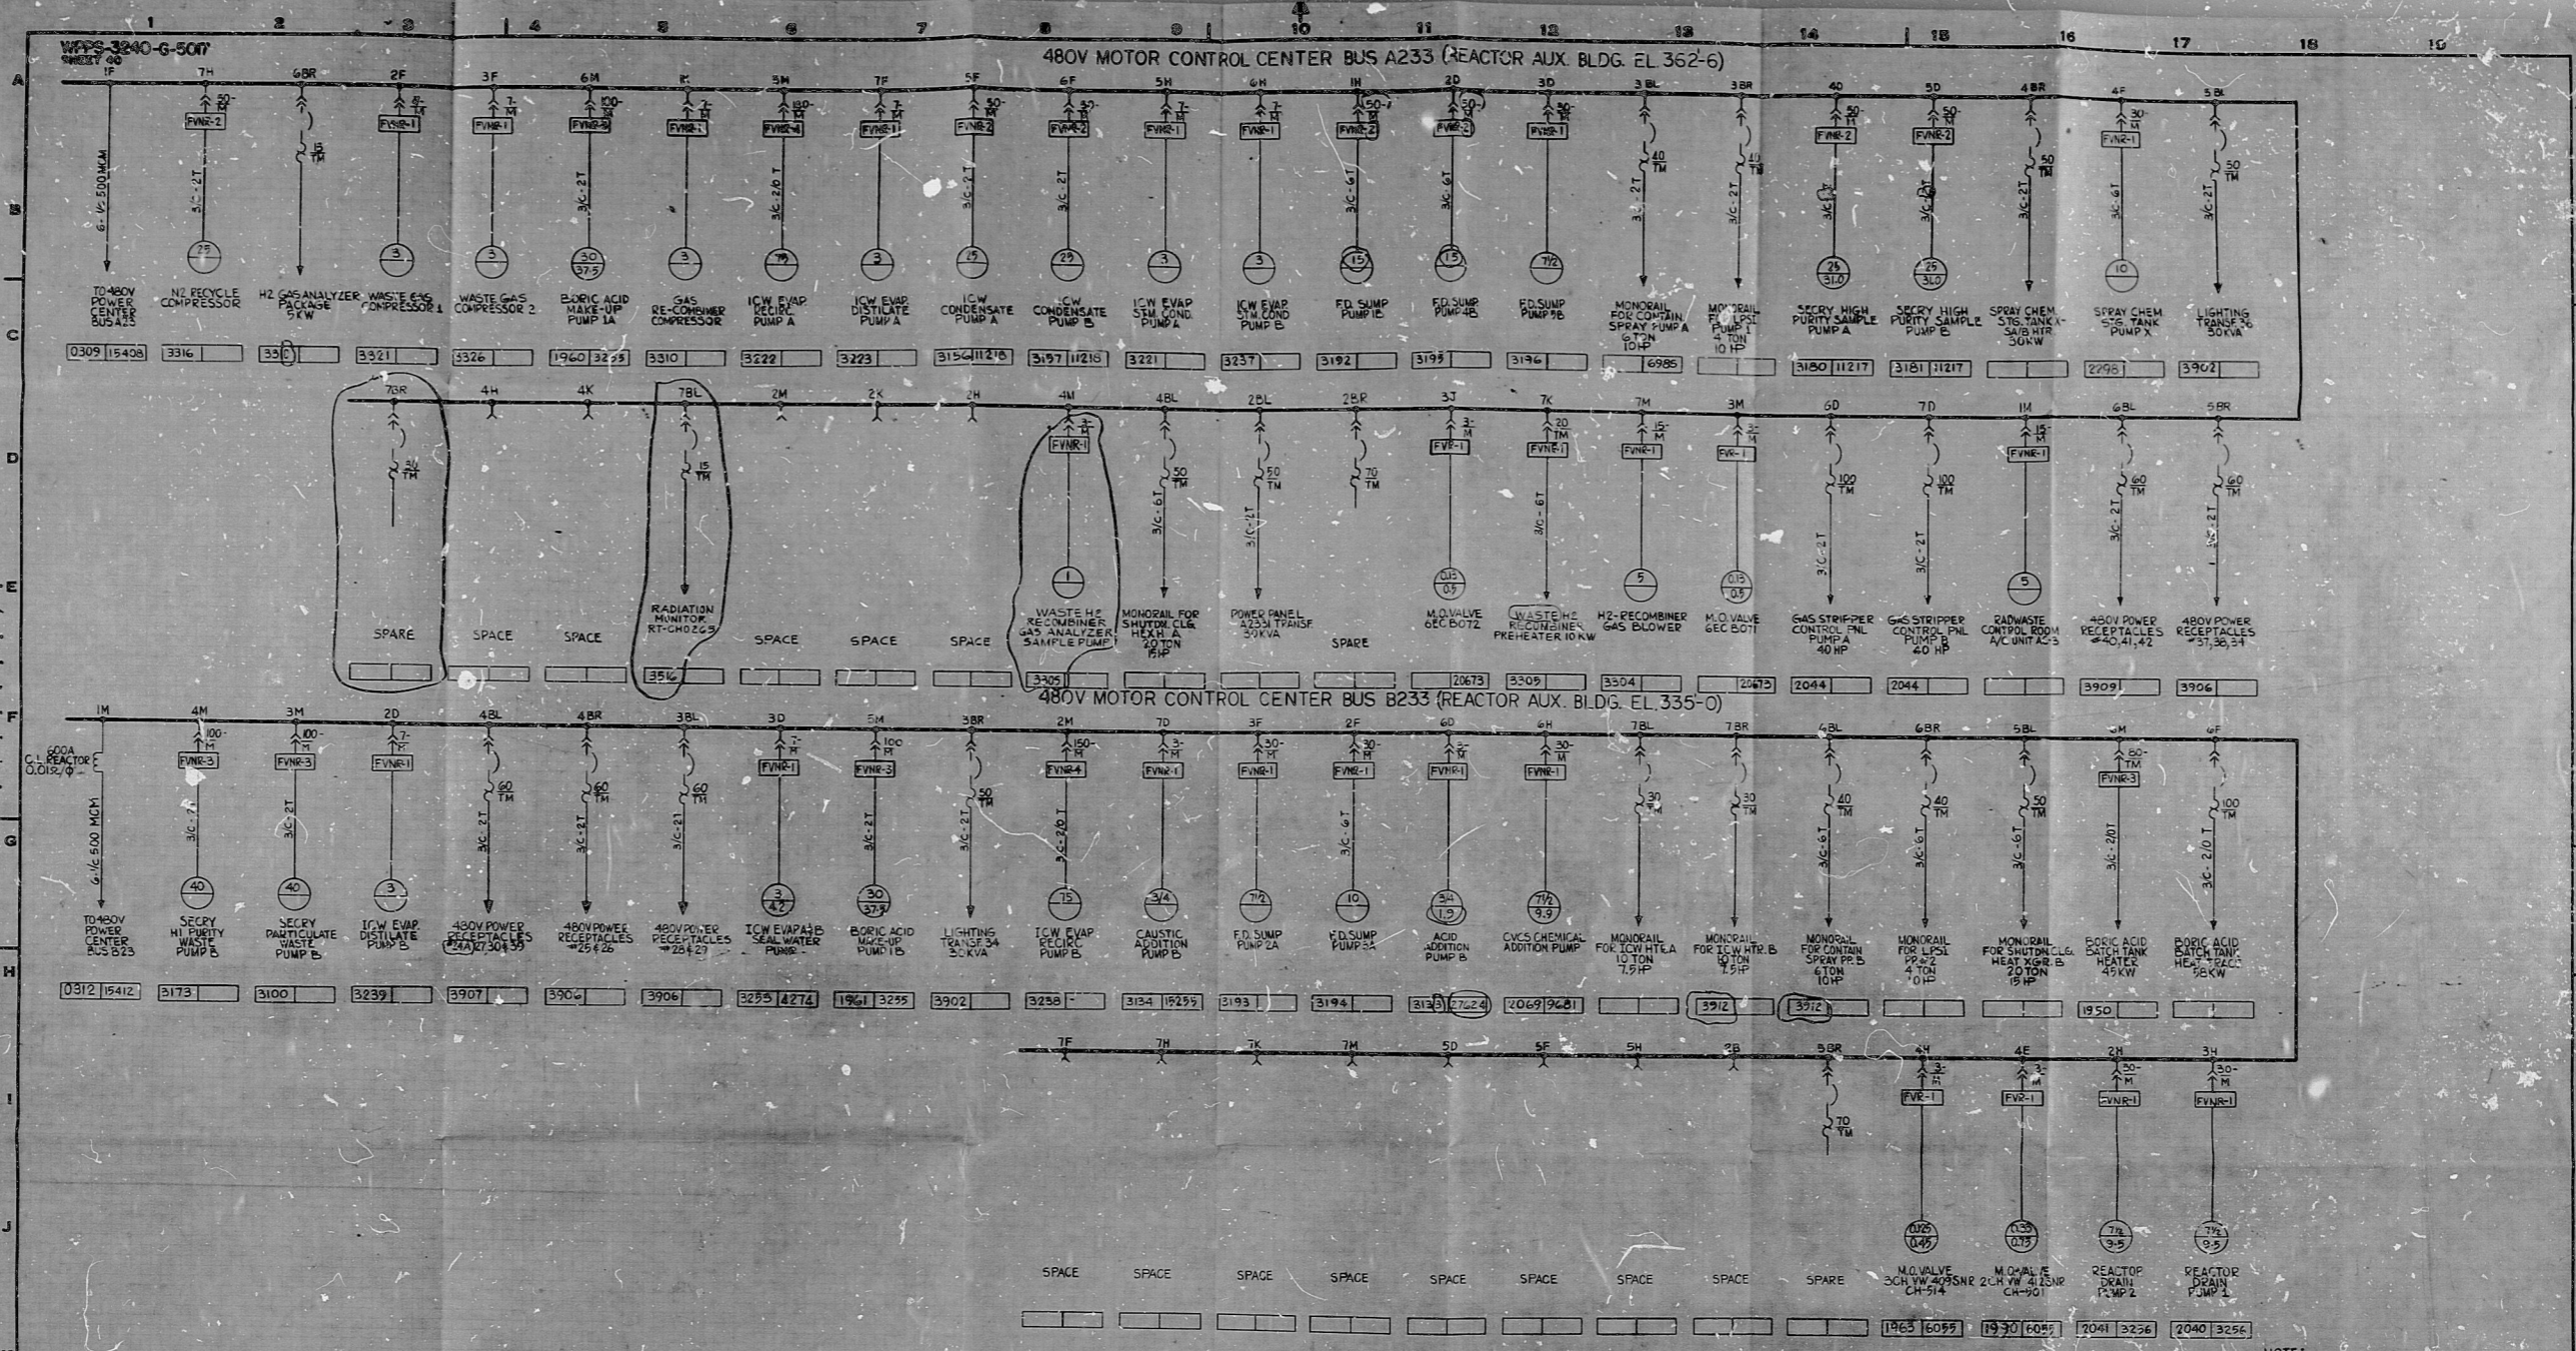

INCOMING FEEDER

24L	24R	30L	30R	40L	40R	50L	50R	60L	60R	70L	70R
2F	3F	4F	5F	6F	7F						
2H	3H	4H	5H	6H	7H						
2K	3K	4K	5K	6K	7K						
2M	3M	4M	5M	6M	7M						

MCC A233 (FRONT VIEW)

INCOMING FEEDER

24L	24R	30L	30R	40L	40R	50L	50R	60L	60R	70L	70R
2F	3F	4F	5F	6F	7F						
2H	3H	4H	5H	6H	7H						
2K	3K	4K	5K	6K	7K						
2M	3M	4M	5M	6M	7M						

MCC B233 (FRONT VIEW)

NOTE:  
 1. FOR GENERAL NOTES, 480V MOTOR CONTROL CENTER NOTES, SYMBOLS, ABBREVIATIONS & REFERENCE DRAWINGS SEE DWG. 6-5017 SHEET 1.

WIRE QUALITY CLASS 1&G

P.R.C. APERTURE CARD

WASHINGTON PUBLIC POWER SUPPLY SYSTEM  
 NUCLEAR PROJECT NO. 305  
 480V MOTOR CONTROL CENTER  
 480V MOTOR CONTROL CENTER SHEET  
 6-5017 SHEET 1



**RWS**

8303210199

