

SCALING RULES

E-1190

FOR CONSTRUCTION USE

ADDED	REVISED	DELETED
AY001	C-3	AY066
AY007	D-7	
AY008	A-4	
AY009	A-1	
AY010	F-3	

AY001-1/2 ENT

AY007-1/2 ENT

AY008-1/2 ENT

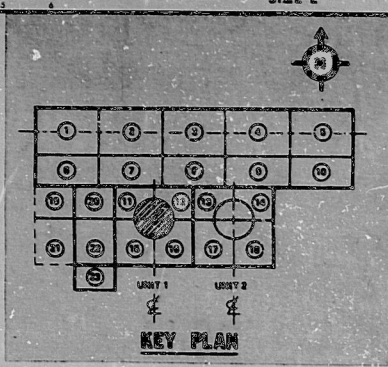

NOTES

1. ALL CONDUITS ARE RUN BELOW STRUCTURAL STEEL EXCEPT THOSE ON LINER PLATE AND WHERE OTHERWISE NOTED.
2. FOR ELEVATION OF CONDUITS ON LINER PLATE SEE DRAWING E-1188 SH. 1, 2, 3 AND 4.
3. FOR CONDUITS GOING UP SEE DRAWING E-1193.
4. ALL MOTOR OPERATED VALVES SHALL BE PROVIDED WITH IN-LINE PLUG CONNECTORS. SEE DWG E-1406 SH. 1 FOR TYPICAL CONDUIT INSTALLATION.
5. THE FOLLOWING ARE FOR'S & FOR'S NOT REQUIRING DOCUMENT REVISIONS: REFER TO PARTICULAR FOR & FOR FOR DETAIL.

REFERENCE DRAWINGS

- C-270 LINER PLATE PENETRATION LOCATION
- C-279 PENETRATION SCHEDULE
- C-927 STRUCTURAL STEEL
- M-213 PIPING AND MECHANICAL
- M-1104 COILING AND VENTILATING
- SPM-213 SMALL PIPING AND MECHANICAL
- M-840 INSTRUMENT LOCATION
- M-119 EQUIPMENT LOCATION

REV	DATE	BY	CHKD	APPD
1	10/1/64	W. L. LARSEN		
2	10/1/64	W. L. LARSEN		
BECHTEL SAN FRANCISCO		
LIMERICK GENERATING STATION UNITS 1 & 2 PHILADELPHIA ELECTRIC COMPANY		
RACEWAY LAYOUT CONTAINMENT UNIT 1 EL. 238'-1"		
RACEWAY SUPPORTED FROM STEEL AT EL. 253'-0"		
JOB NO.	DRAWING NO.	REV.
8031	E-1190	14

TERA
APERTURE
CARD

RIDS

8110140087

