


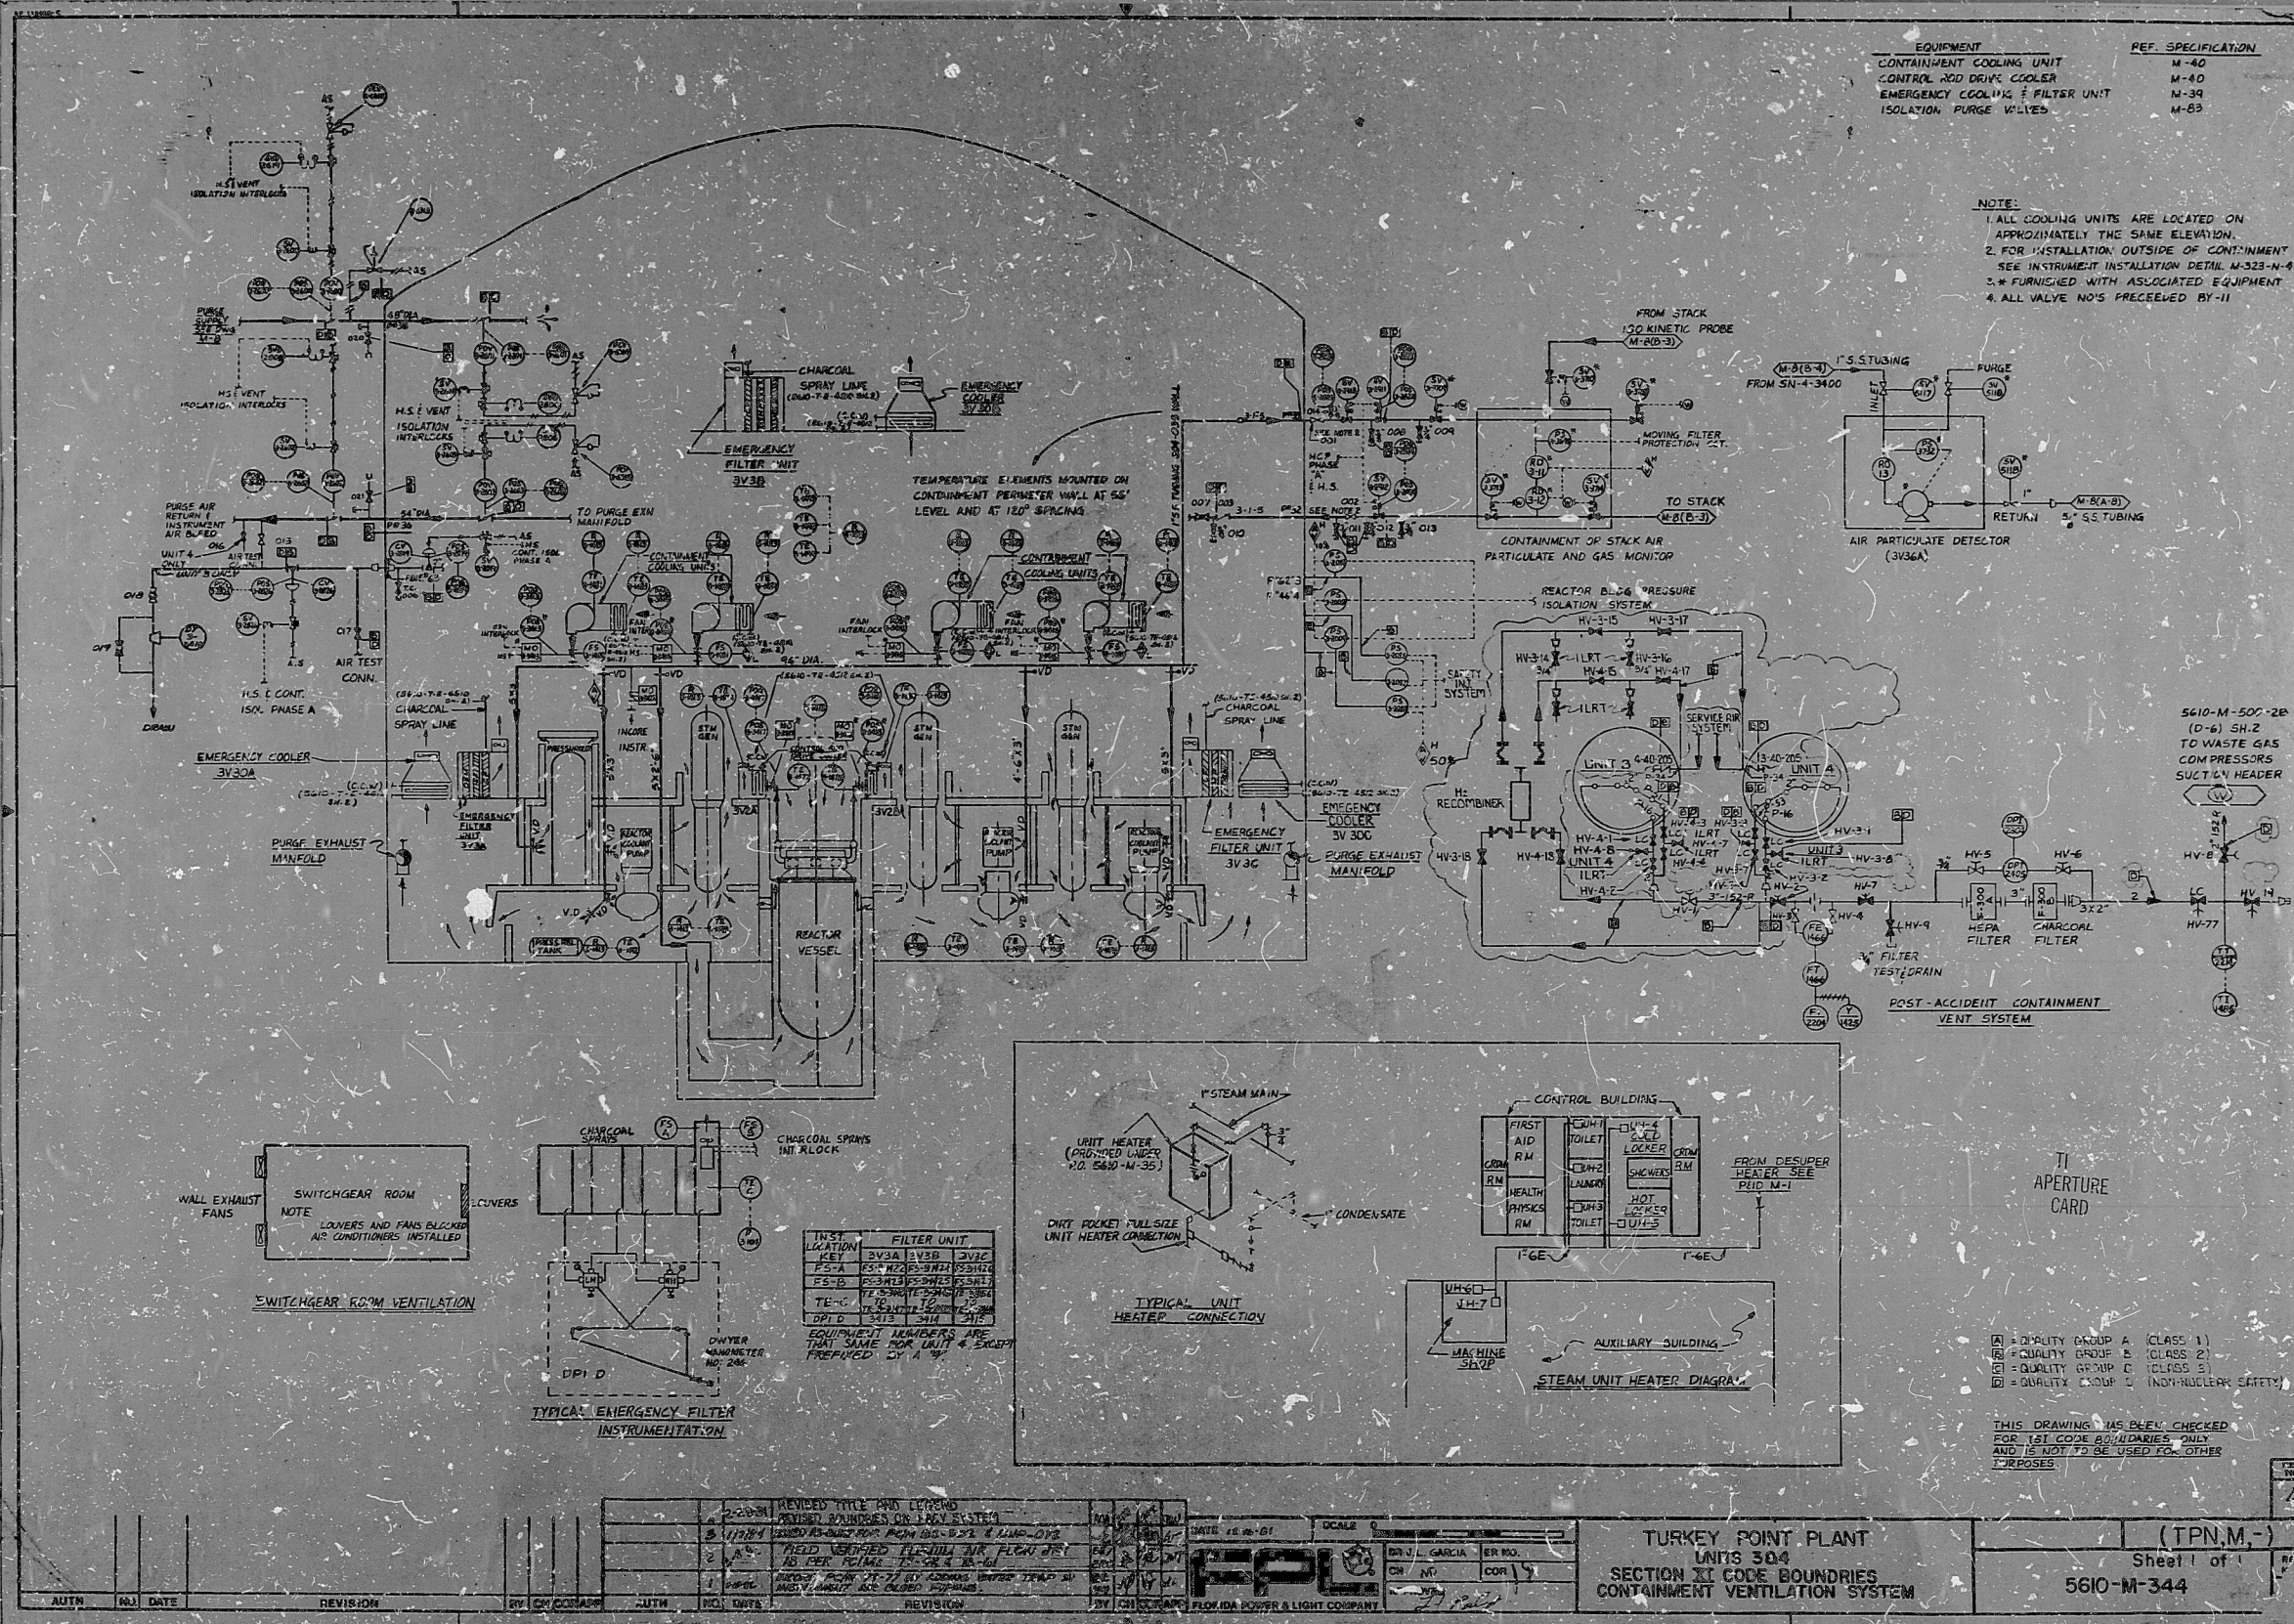



8404230379

PDRIDS

