


34

33

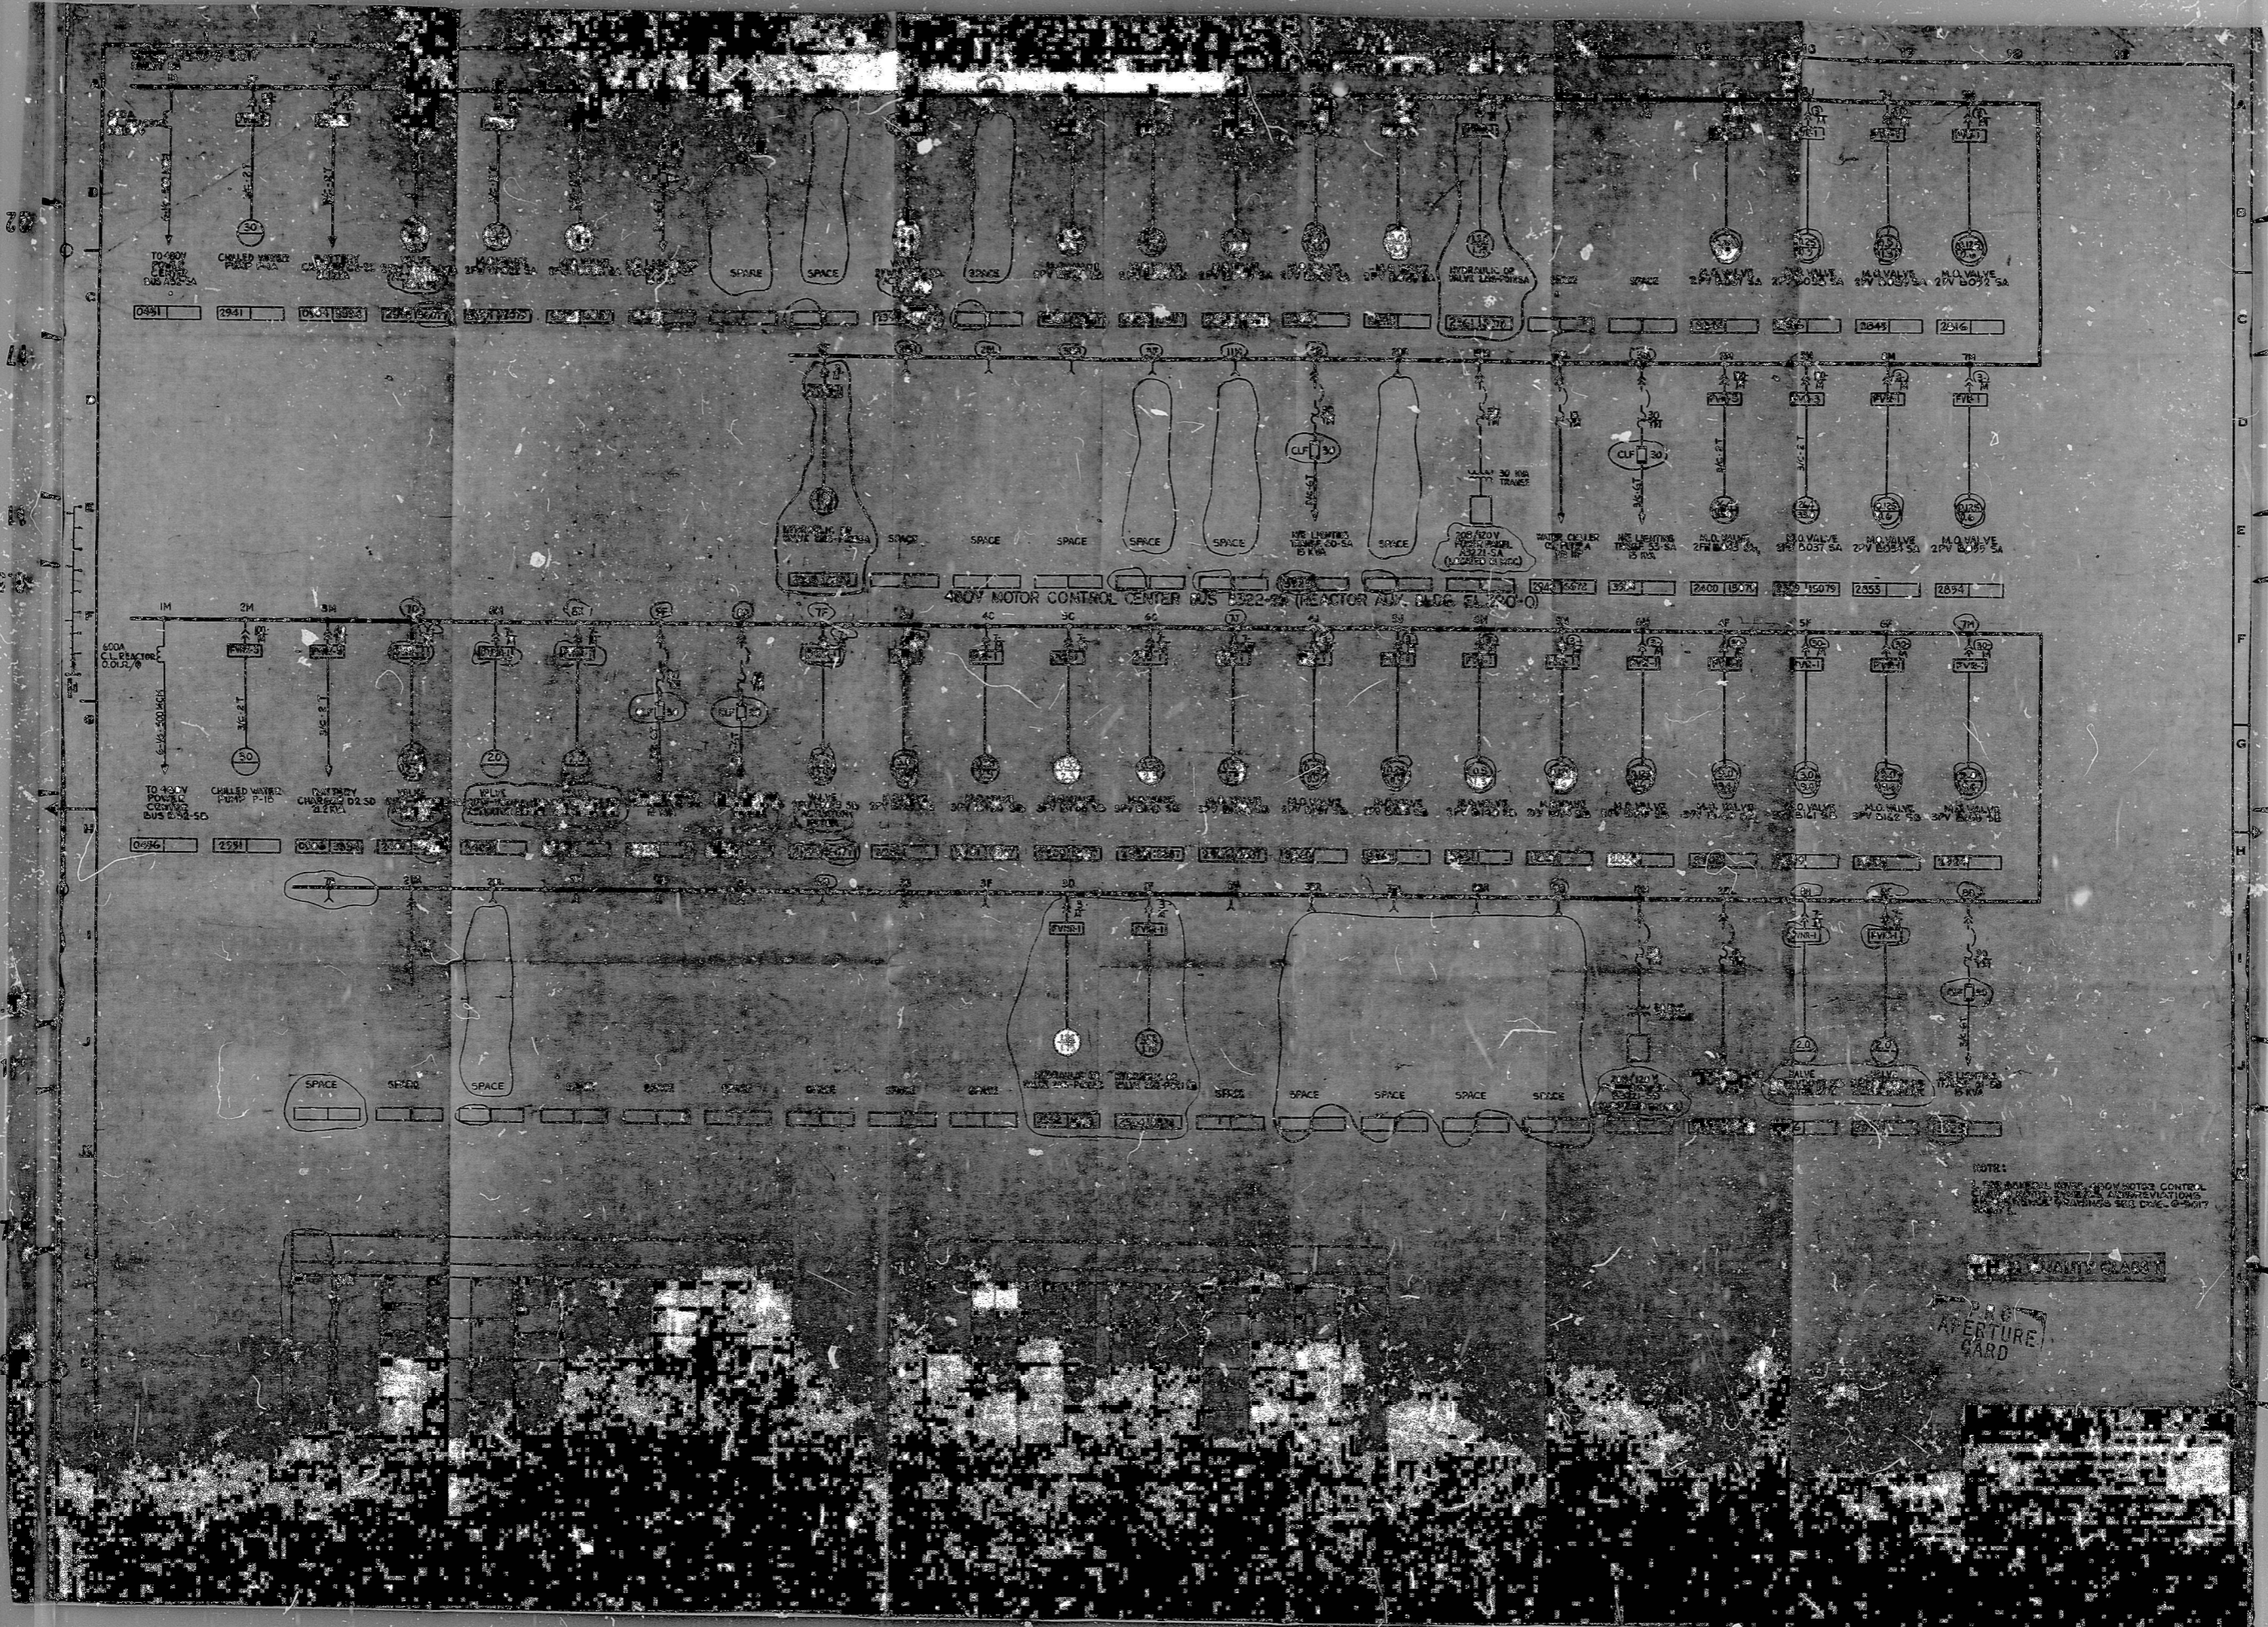

22

22

17

17

11

11

8.5

8.5

0.5

0.5

11

11

17

17

22

22

NOTE:

400V MOTOR CONTROL CENTER

APERTURE
 CARD

RIDS

8303210216

