

34

34

22

22

17

17

11

11

8.5

8.5

8.5

8.5

11



11

17

17

22

22

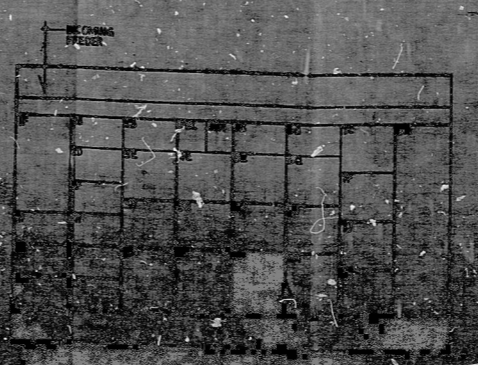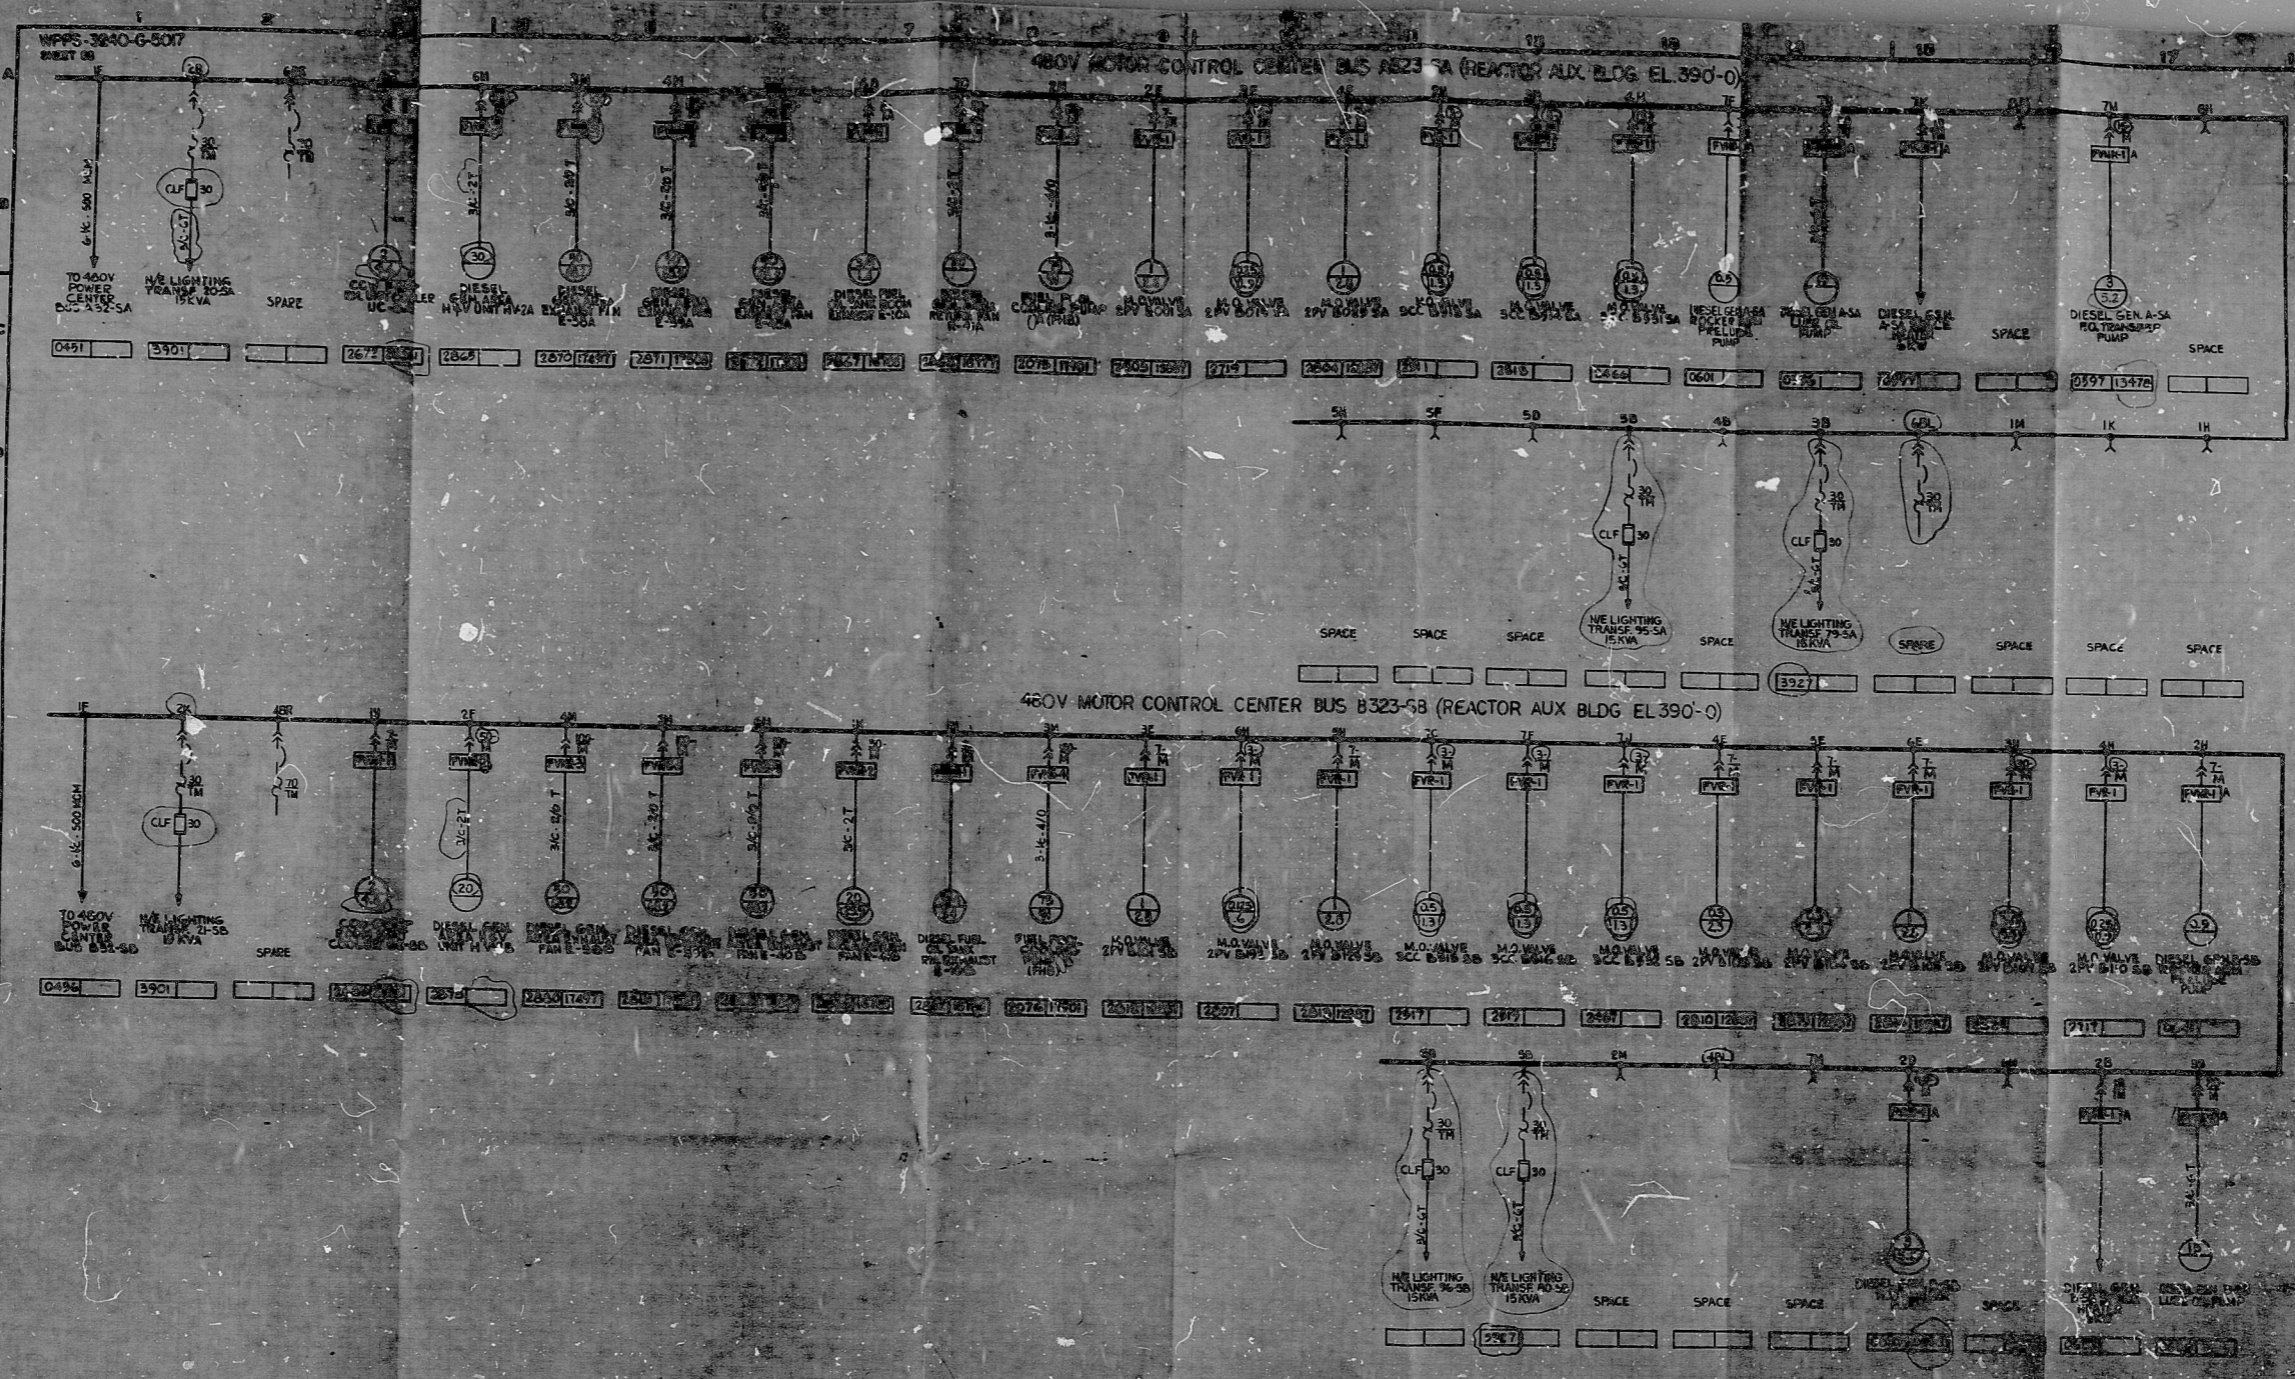

CLASS

RIDS

8303210217

