


PRC APERTURE CARD

- NOTES:
- FOR CONNECTION TO EMBEDDED R. SEE SH 55-6
 - FOR PREFABRICATED CONN. FITTINGS SEE SH 55-7.

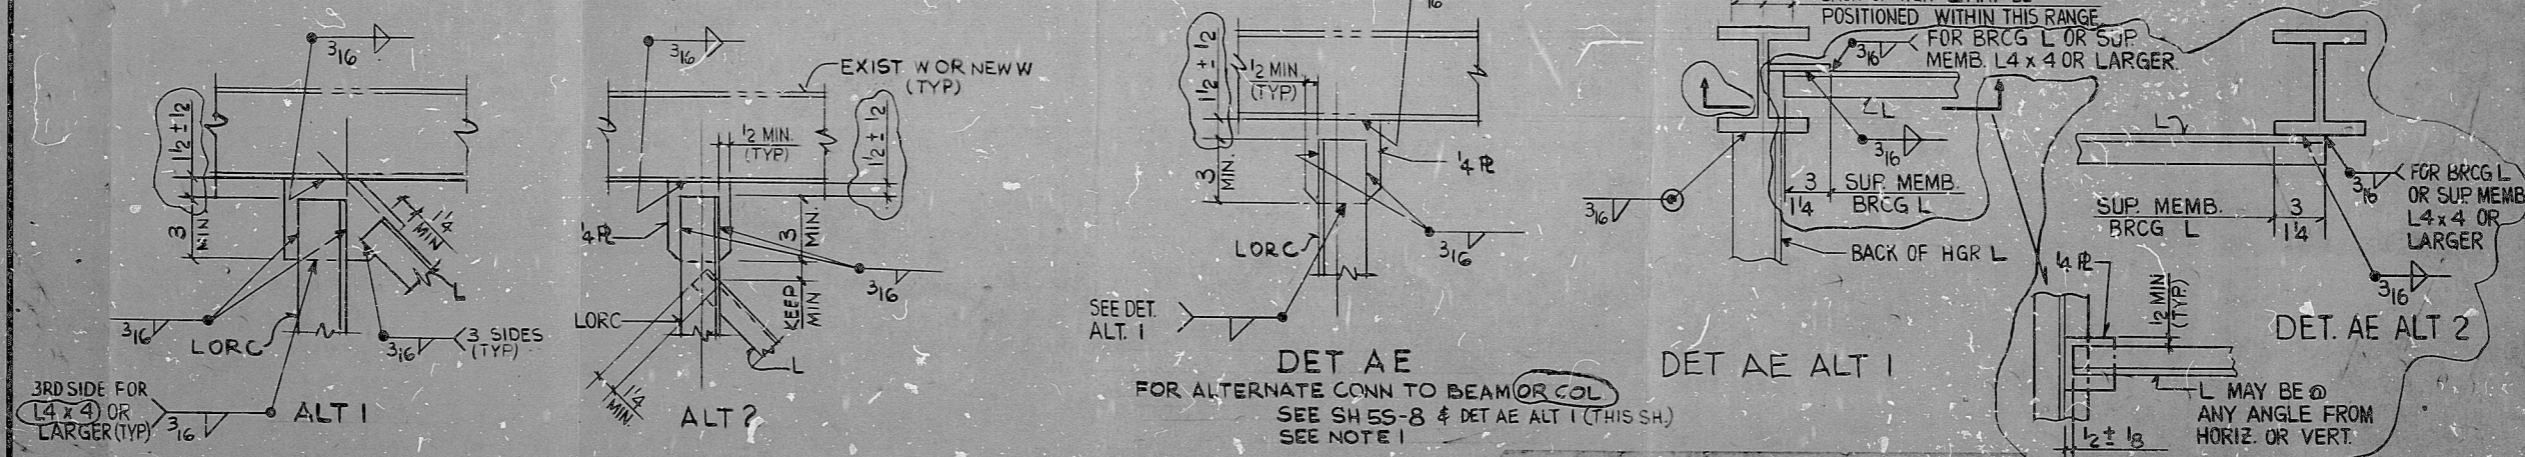

DET AD FOR ALTERNATE CONN TO BEAM OR COL. SEE SH 55-8 SEE NOTE 1

DET AE FOR ALTERNATE CONN TO BEAM OR COL. SEE SH 55-8 & DET AE ALT 1 (THIS SH.) SEE NOTE 1

DET AE ALT 1

DET. AE ALT 2

THIS SHEET IS FOR SEISMIC APPLICATIONS FOR ALL BUILDINGS.

EBASCO SERVICES INCORPORATED				WASHINGTON PUBLIC POWER SUPPLY SYSTEM		WPPSS QUALITY CLASS I, II & G	
DIV. ELEC. DR. FDB				NUCLEAR PROJECTS NO. 3 & 5		WPPSS-3240	
CH. F.D. BEANE				GENERAL NOTES, SYMBOLS AND REFERENCE DRAWINGS		D-5023	
DATE APR 10 1979						SHEET 95-4	
REV.	DATE	BY	APPROVED				
5							
4							
3	7-21-81	SP					
2	2-17-81	RL					
1	8-22-80	S.P.					

RIDS

8303210296

