


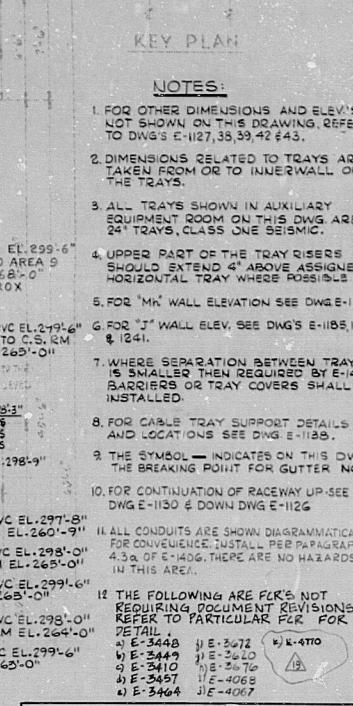

FOR CONSTRUCTION USE				
RACEWAYS				
ADDED	2nd RACE	REVISED	2nd RACE	DELETED
1DH035	E-5	C1306	D-6	1IH009
1DH035		C1307	D-6	1IH011
		C1389	F-6	
		C1491	F-5	
		C1492	F-5	
		C1494	D-6	
		C1495	D-6	
		C1494	D-6	
		C1490	D-6	
		C1025	D-5	
		C1352	D-6	
		1IH001	D-6	
		21H002	"	
		21H005	"	
		1A1490	E-6	
		10G-040	D-6	
		10G-041	D-6	

REFERENCE DRAWINGS:

- C-280 STEEL STRUCT. PARTIAL FRAMING PLAN EL. 290'-0"
- M-101 SHIPING
- E-1406 CONDUIT AND CABLE TRAY SYMBOLS, NOTES AND DETAILS
- E-1410 TERMINAL AND PULL BOX NOTES, DETAILS AND SCHEDULES
- C-473 CONTROL ROOM AREA & STRUCTURAL STEEL
- E-1141 J-WALL ELEVATION-UNIT 1
- E-1500 RACEWAY SCHEDULE 1 & 2 UNITS AND COMMON SERIES
- E-1261 J-WALL ELEVATION-UNIT 2
- C-441 CONT'D. ROOM AREA, FLOOR PLAN
- C-457 CONTROL ROOM AREA EXTERIOR WALL
- E-1174 TRAY LAYOUT AREA & EL. 289'-0"
- M-1085 J WALL ELEVATION 1 & 2 UNITS.
- E-1102 H.V. & AIR CONDITIONING
- M-1035 AIR EQUIPMENT INST. ARRANGEMENT
- M-944 INSTRUMENT LOCATION
- E-1147 DETAILS & DETAILS OF "MH" WALL
- E-1148 "MH" WALL LAYOUT DIFFERENT ELEVATIONS.
- E-1244 ELEVATION 19.4 & 26.G WALL COL. J TO
- E-1144 "MH" WALL ELEVATION LOOKING NORTH
- E-1233 RACEWAY LAYOUT "MH" WALL ELEVATION

[illegible]

R105

8110140262

