


- NOTES:**
1. ALL EMBEDDED CONDUITS TO BE 5" PVC UNLESS NOTED OTHERWISE.
 2. WHERE CONDUITS ARE RUN EXPOSED CHANGE PVC CONDUITS TO RIGID STEEL CONDUITS OF SAME SIZE, OR AS INDICATED.
 3. EMBEDDED CONDUITS TO BE RUN AS PER SPEC. 8031-036.

REFERENCE DRAWING

E-1300 RACEWAY SCHEDULE SERIES 1 UNIT & COMMON.

E-1410 TERMINAL JUNCTION BOX NOTES, DETAILS & SCHEDULES.

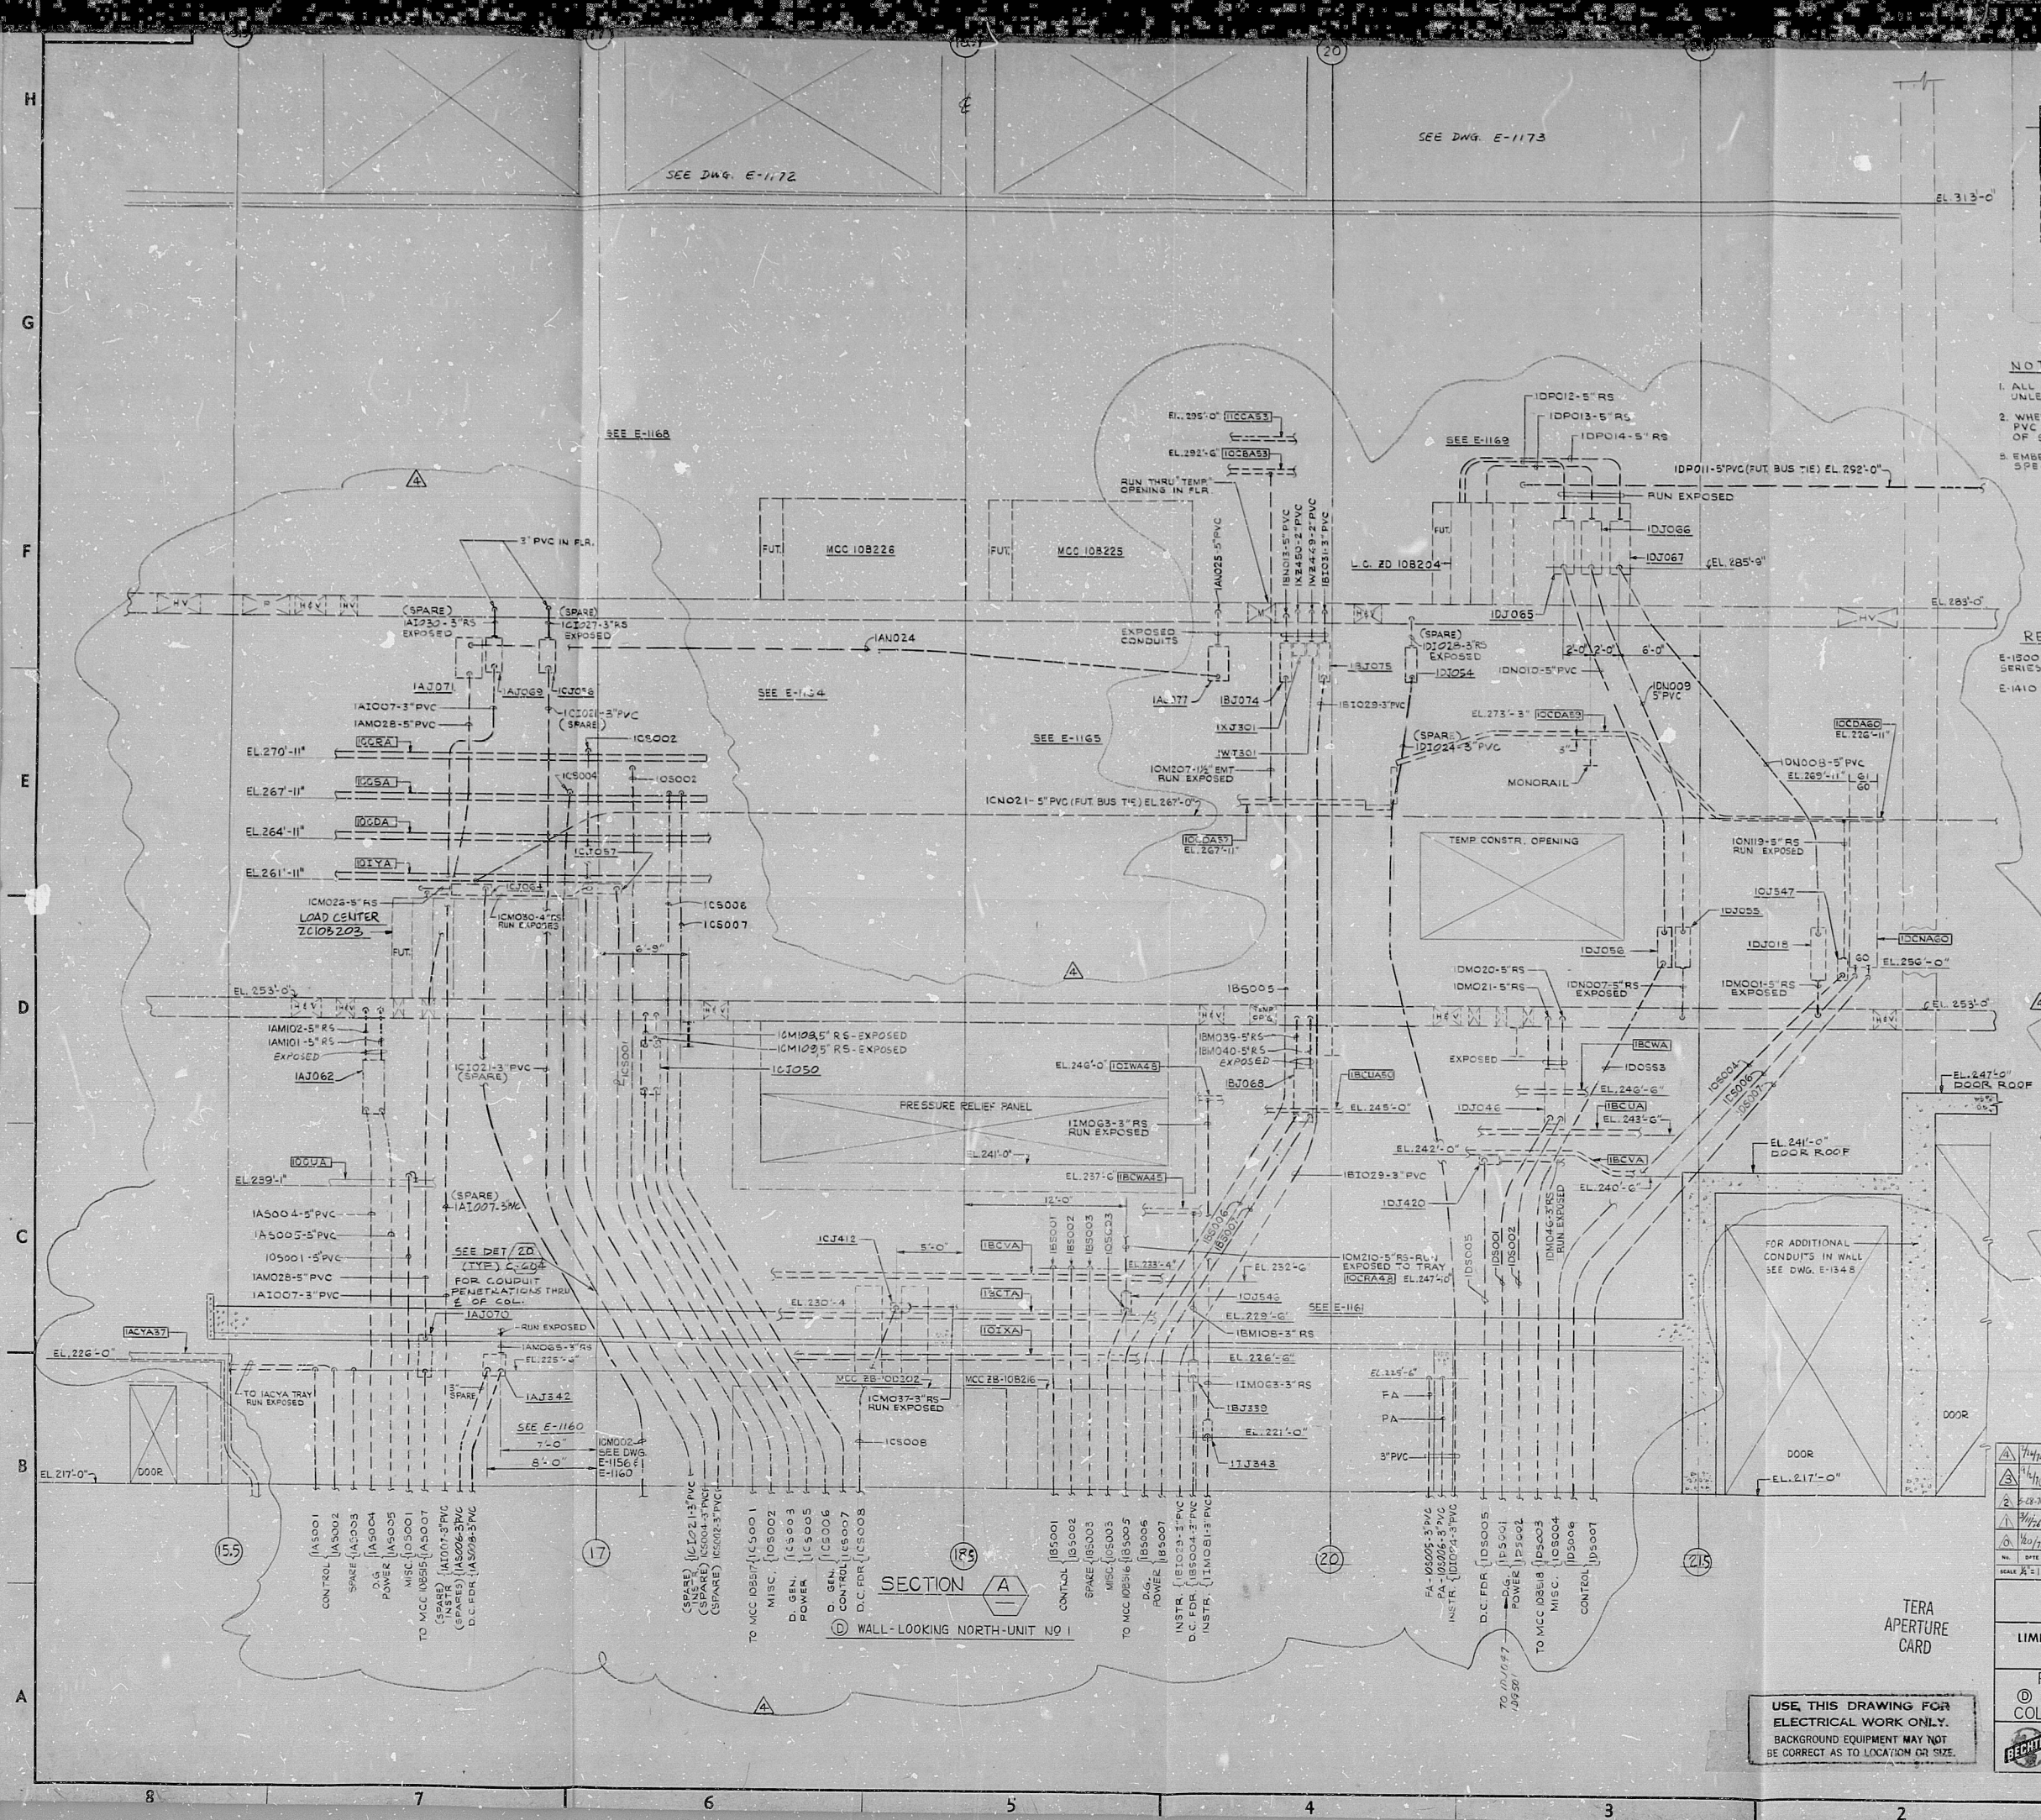

NO.	DATE	REVISIONS	BY	CHECKED	APPROVED
1	10/1/77	ISSUED FOR CONSTRUCTION	W. J. WILSON	G. H. HIA	

BECHTEL
SAN FRANCISCO

LIMERICK GENERATING STATION UNITS 1 & 2
PHILADELPHIA ELECTRIC COMPANY

RACEWAY LAYOUT - 1 UNIT
① WALL ELEV. - LOOKING NORTH
COLS. 15.5-21.5, ELEV. 217'-0" - 313'-0"

JOB No.	DRAWING No.	REV.
8031	E-1184	4

USE THIS DRAWING FOR ELECTRICAL WORK ONLY. BACKGROUND EQUIPMENT MAY NOT BE CORRECT AS TO LOCATION OR SIZE.

TERA APERTURE CARD

SECTION A
WALL-LOOKING NORTH-UNIT NO 1

RIDS

8110140265

