


WPPS-3240-G-5424

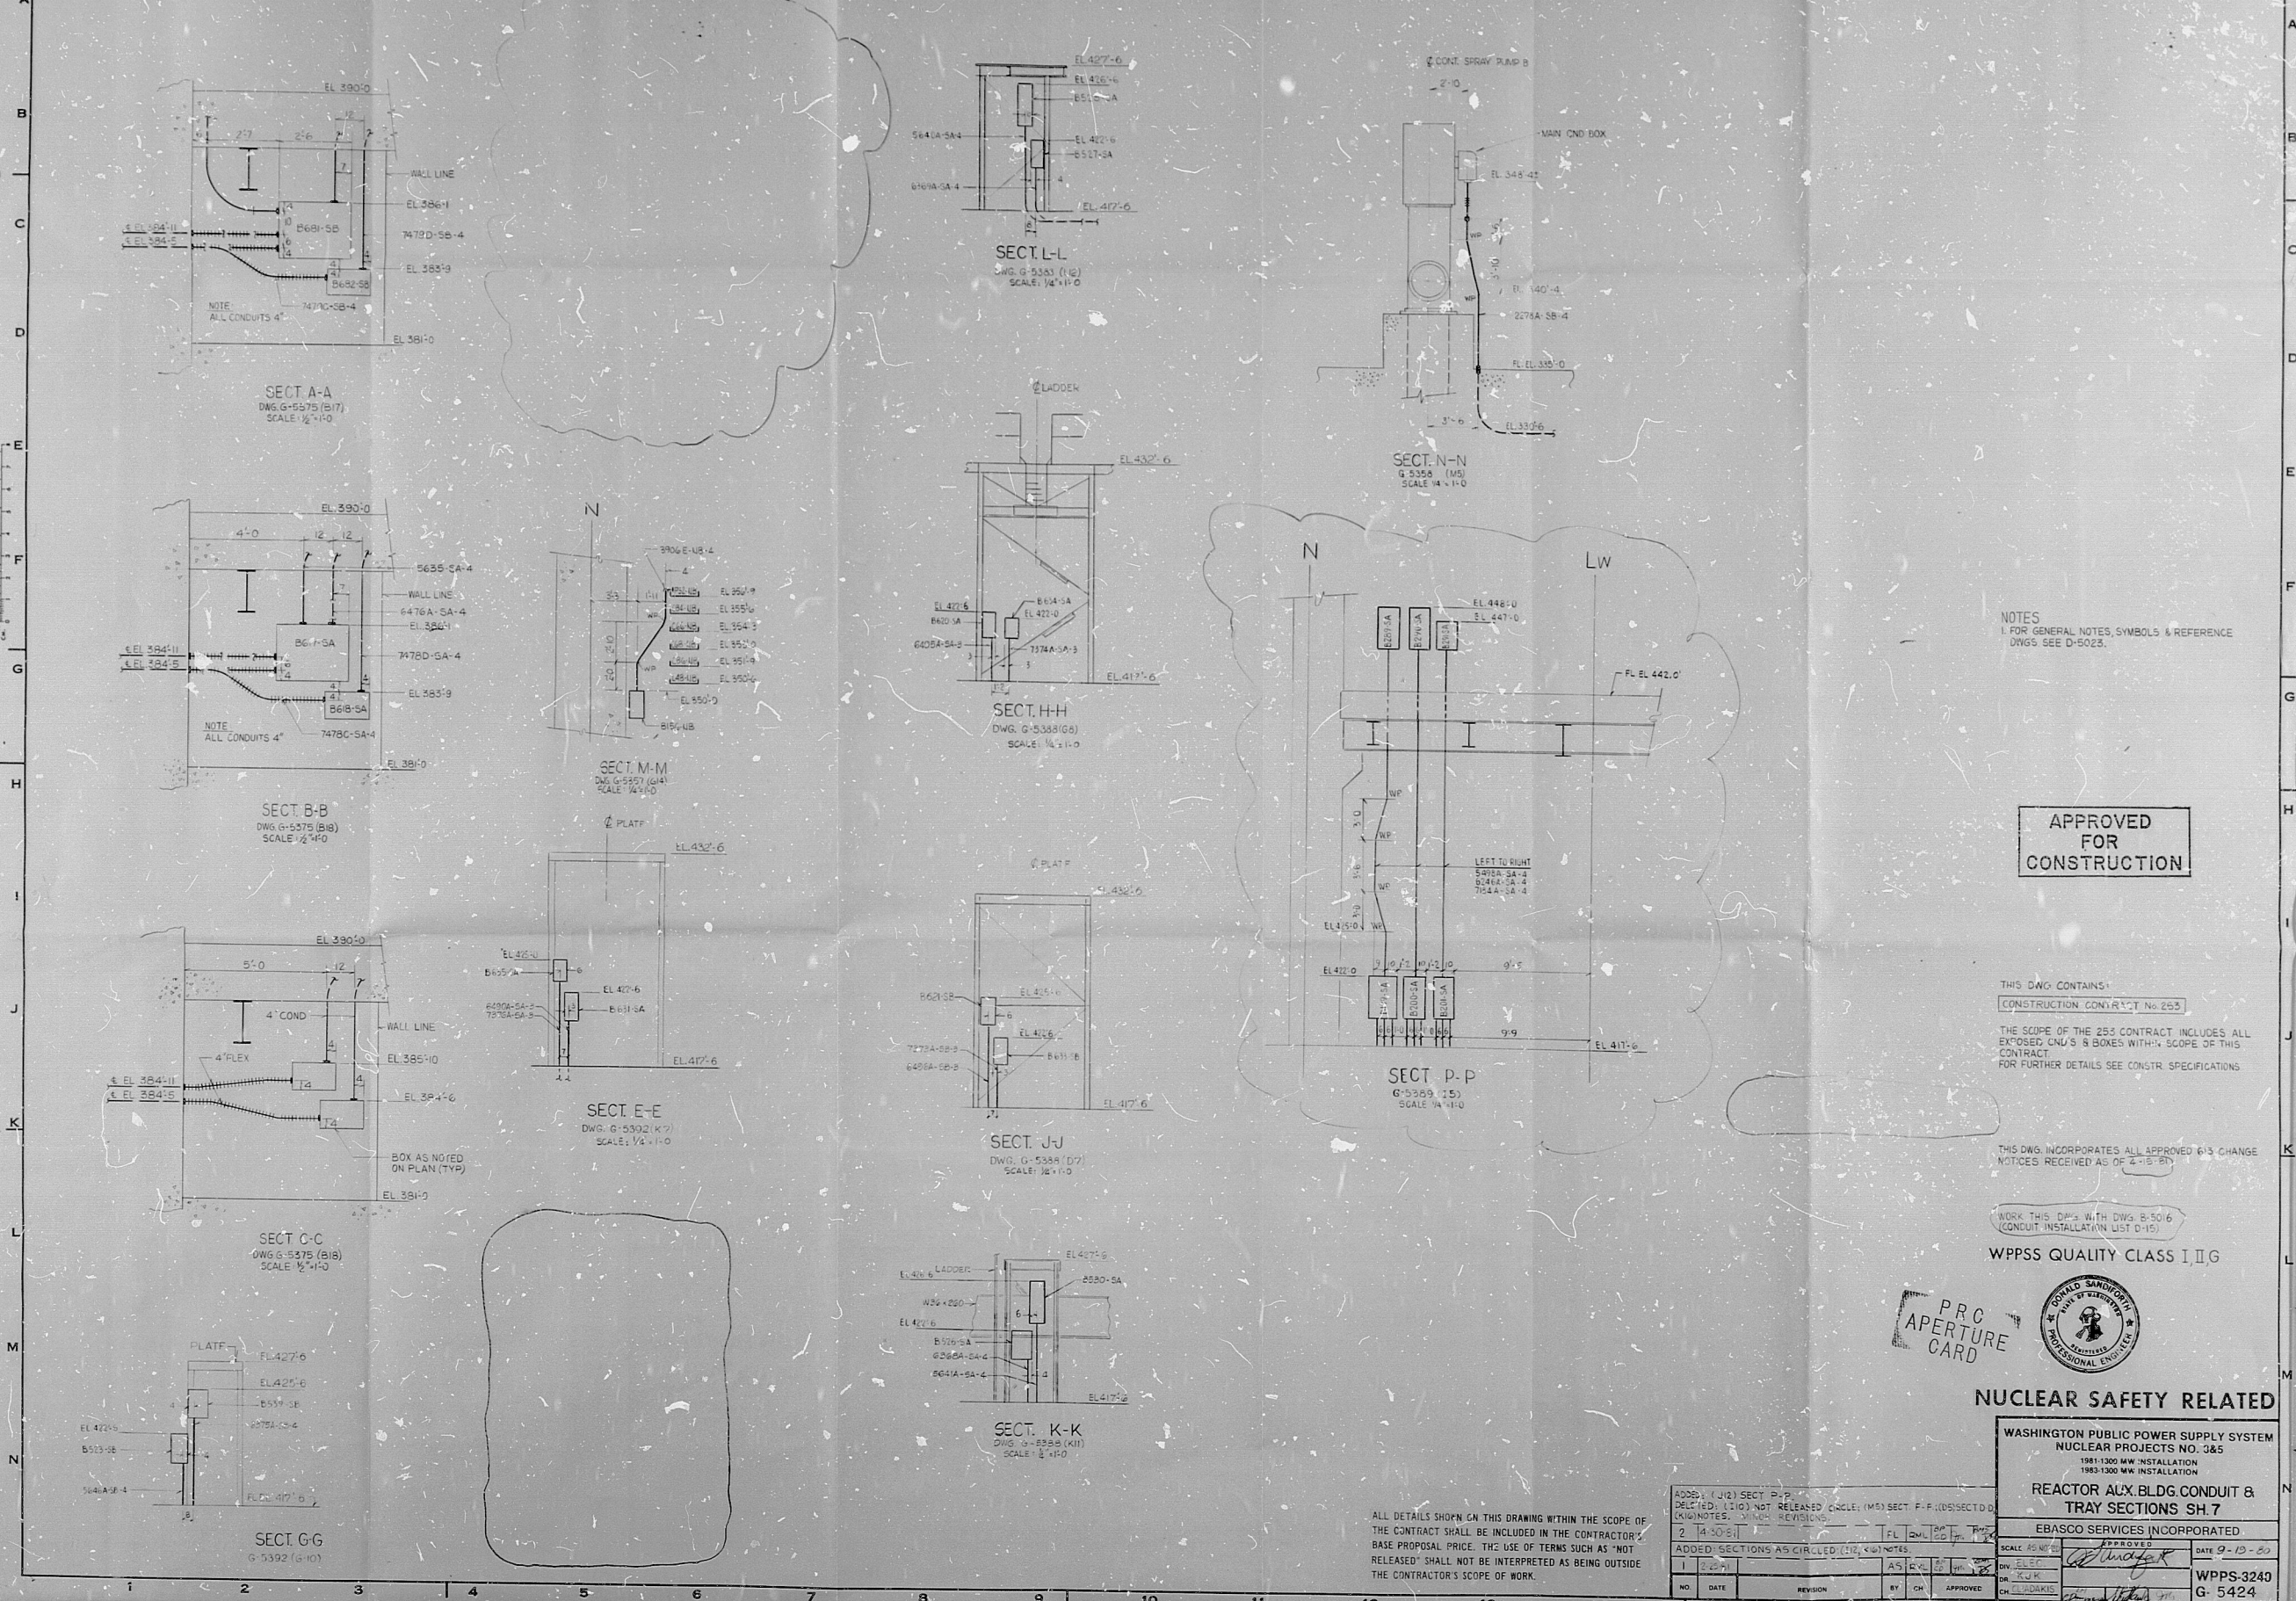

NOTES
 1. FOR GENERAL NOTES, SYMBOLS & REFERENCE DWGS SEE D-5023.

APPROVED FOR CONSTRUCTION

THIS DWG CONTAINS:
 THE SCOPE OF THE 253 CONTRACT INCLUDES ALL EXPOSED, CMU'S & BOXES WITHIN SCOPE OF THIS CONTRACT. FOR FURTHER DETAILS SEE CONSTR. SPECIFICATIONS.


WORK THIS DWG WITH DWG B-5016 (CONDUIT INSTALLATION LIST D-15)

WPPSS QUALITY CLASS II G

PRC APERTURE CARD



NUCLEAR SAFETY RELATED

WASHINGTON PUBLIC POWER SUPPLY SYSTEM
 REACTOR AUX. BLDG. CONDUIT & TRAY SECTIONS SH 7

EBASCO SERVICES INCORPORATED
 SCALE: AS SHOWN
 DRAWN BY: [Signature]
 CHECKED BY: [Signature]
 WPPS-3240 G-5424

ALL DETAILS SHOWN ON THIS DRAWING WITHIN THE SCOPE OF THE CONTRACT SHALL BE INCLUDED IN THE CONTRACTOR'S BASE PROPOSAL PRICE. THE USE OF TERMS SUCH AS "NOT RELEASED" SHALL NOT BE INTERPRETED AS BEING OUTSIDE THE CONTRACTOR'S SCOPE OF WORK.

NO.	DATE	REVISION	BY	CHK	APPROVED
1					

RIDS

8303240243

