WPPS 3240-G-5452

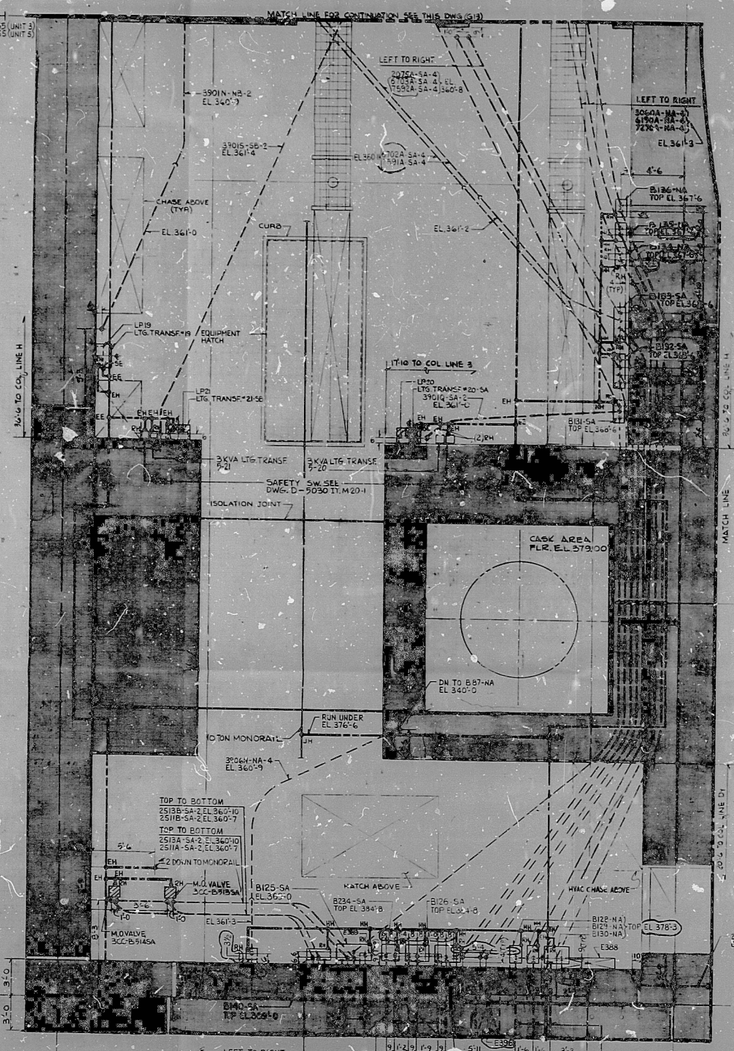

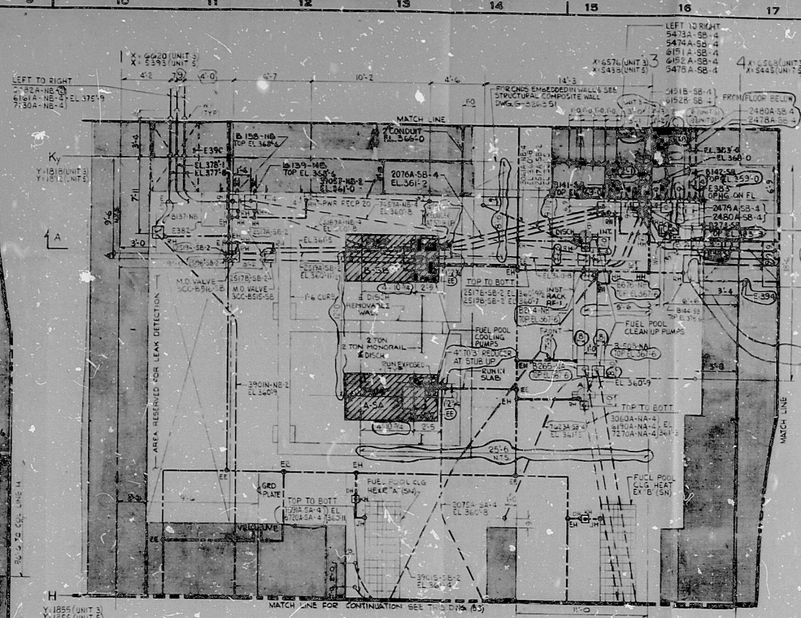

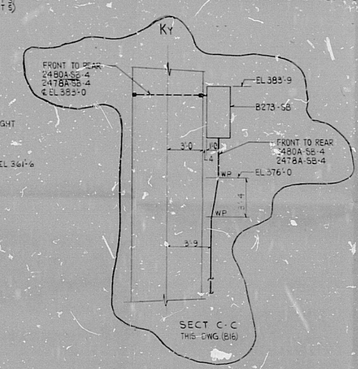

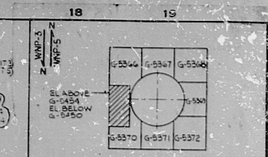

REACTOR, REACTOR AUX & FUEL HDLG BLDGS
KEY PLAN EL. 362.50'

THIS DRAWING CONTAINS
CONSTRUCTION CONTRACT Nº 225
CONSTRUCTION CONTRACT Nº 243
CONSTRUCTION CONTRACT Nº 253

THE SCOPE OF THE 225 CONTRACT INCLUDES INSTALLATION OF ELECTRICAL EQUIPMENT & EXPOSED EQUIPMENT GROUNDING TERMINATIONS WITHIN SCOPE OF CONTRACT.
THE SCOPE OF THE 243 CONTRACT INCLUDES ALL EMBEDDED ELECTRICAL WORK IN WA 15 AND FLOORS ABOVE EL. 335.00' UP TO EL. 394.00'.
THE SCOPE OF THE 253 CONTRACT INCLUDES ALL EXPOSED GROUND TERMINATIONS NOT COVERED BY THE 225 CONTRACT AND ALL EXPOSED CADD BOXES WITHIN SCOPE OF THIS CONTRACT.
FOR FURTHER DETAILS SEE CONSTRUCTION SPECIFICATIONS.

NOTES
1. FOR GENERAL NOTES, SYMBOLS & REFERENCE DWGS SEE DWG D-501.

APPROVED FOR CONSTRUCTION

WPPSS QUALITY CLASS IIIG
THIS DRAWING INCORPORATES ALL APPROVED G18 CHANGE NOTICES RECEIVED AS OF (7-5-81)

"ALL DETAILS SHOWN ON THIS DRAWING WITHIN THE SCOPE OF THE CONTRACT SHALL BE INCLUDED IN THE CONTRACTOR'S BASE PROPOSAL PRICE. THE USE OF TERMS SUCH AS "NOT RELEASED" SHALL NOT BE INTERPRETED AS BEING OUTSIDE THE CONTRACTOR'S SCOPE OF WORK.

PRC APERTURE CARD

WORK THIS DWG WITH DWG B-501G (CONDUIT INSTALLATION LIST D-15)

NO.	DATE	REVISION	BY	CHK	APPROVED
3	6-15-80		SP		
2	7-7-78	REPOSITIONS TO J4 MS CNDS; ADDED (G4,C15,D13,D23) MOV & MOV CNDS; ADD QUALITY TO MS & EMS CNDS & LT CONDUIT CNDS; (L4,D5,L5,L6,L7,L8,D8,D9,D10,D11) DIMENSIONS; DELETED (C12,D6,D8,D9,D11) DIMENSIONS; (D5,D6,D7,D8,D3842,D

RIDS

8303240267

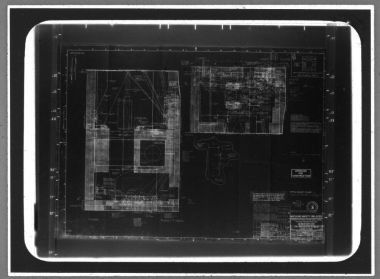

MMM 5824 — FILMSORT® Brand Aperture & Camera Cards and DUPLICARD® Brand Copy Cards — Product of 3M Company, St. Paul, Minn.