

34

34

22

22

17

17

11

11

8.5

8.5

8.5

8.5

11


11

17

17

22

22

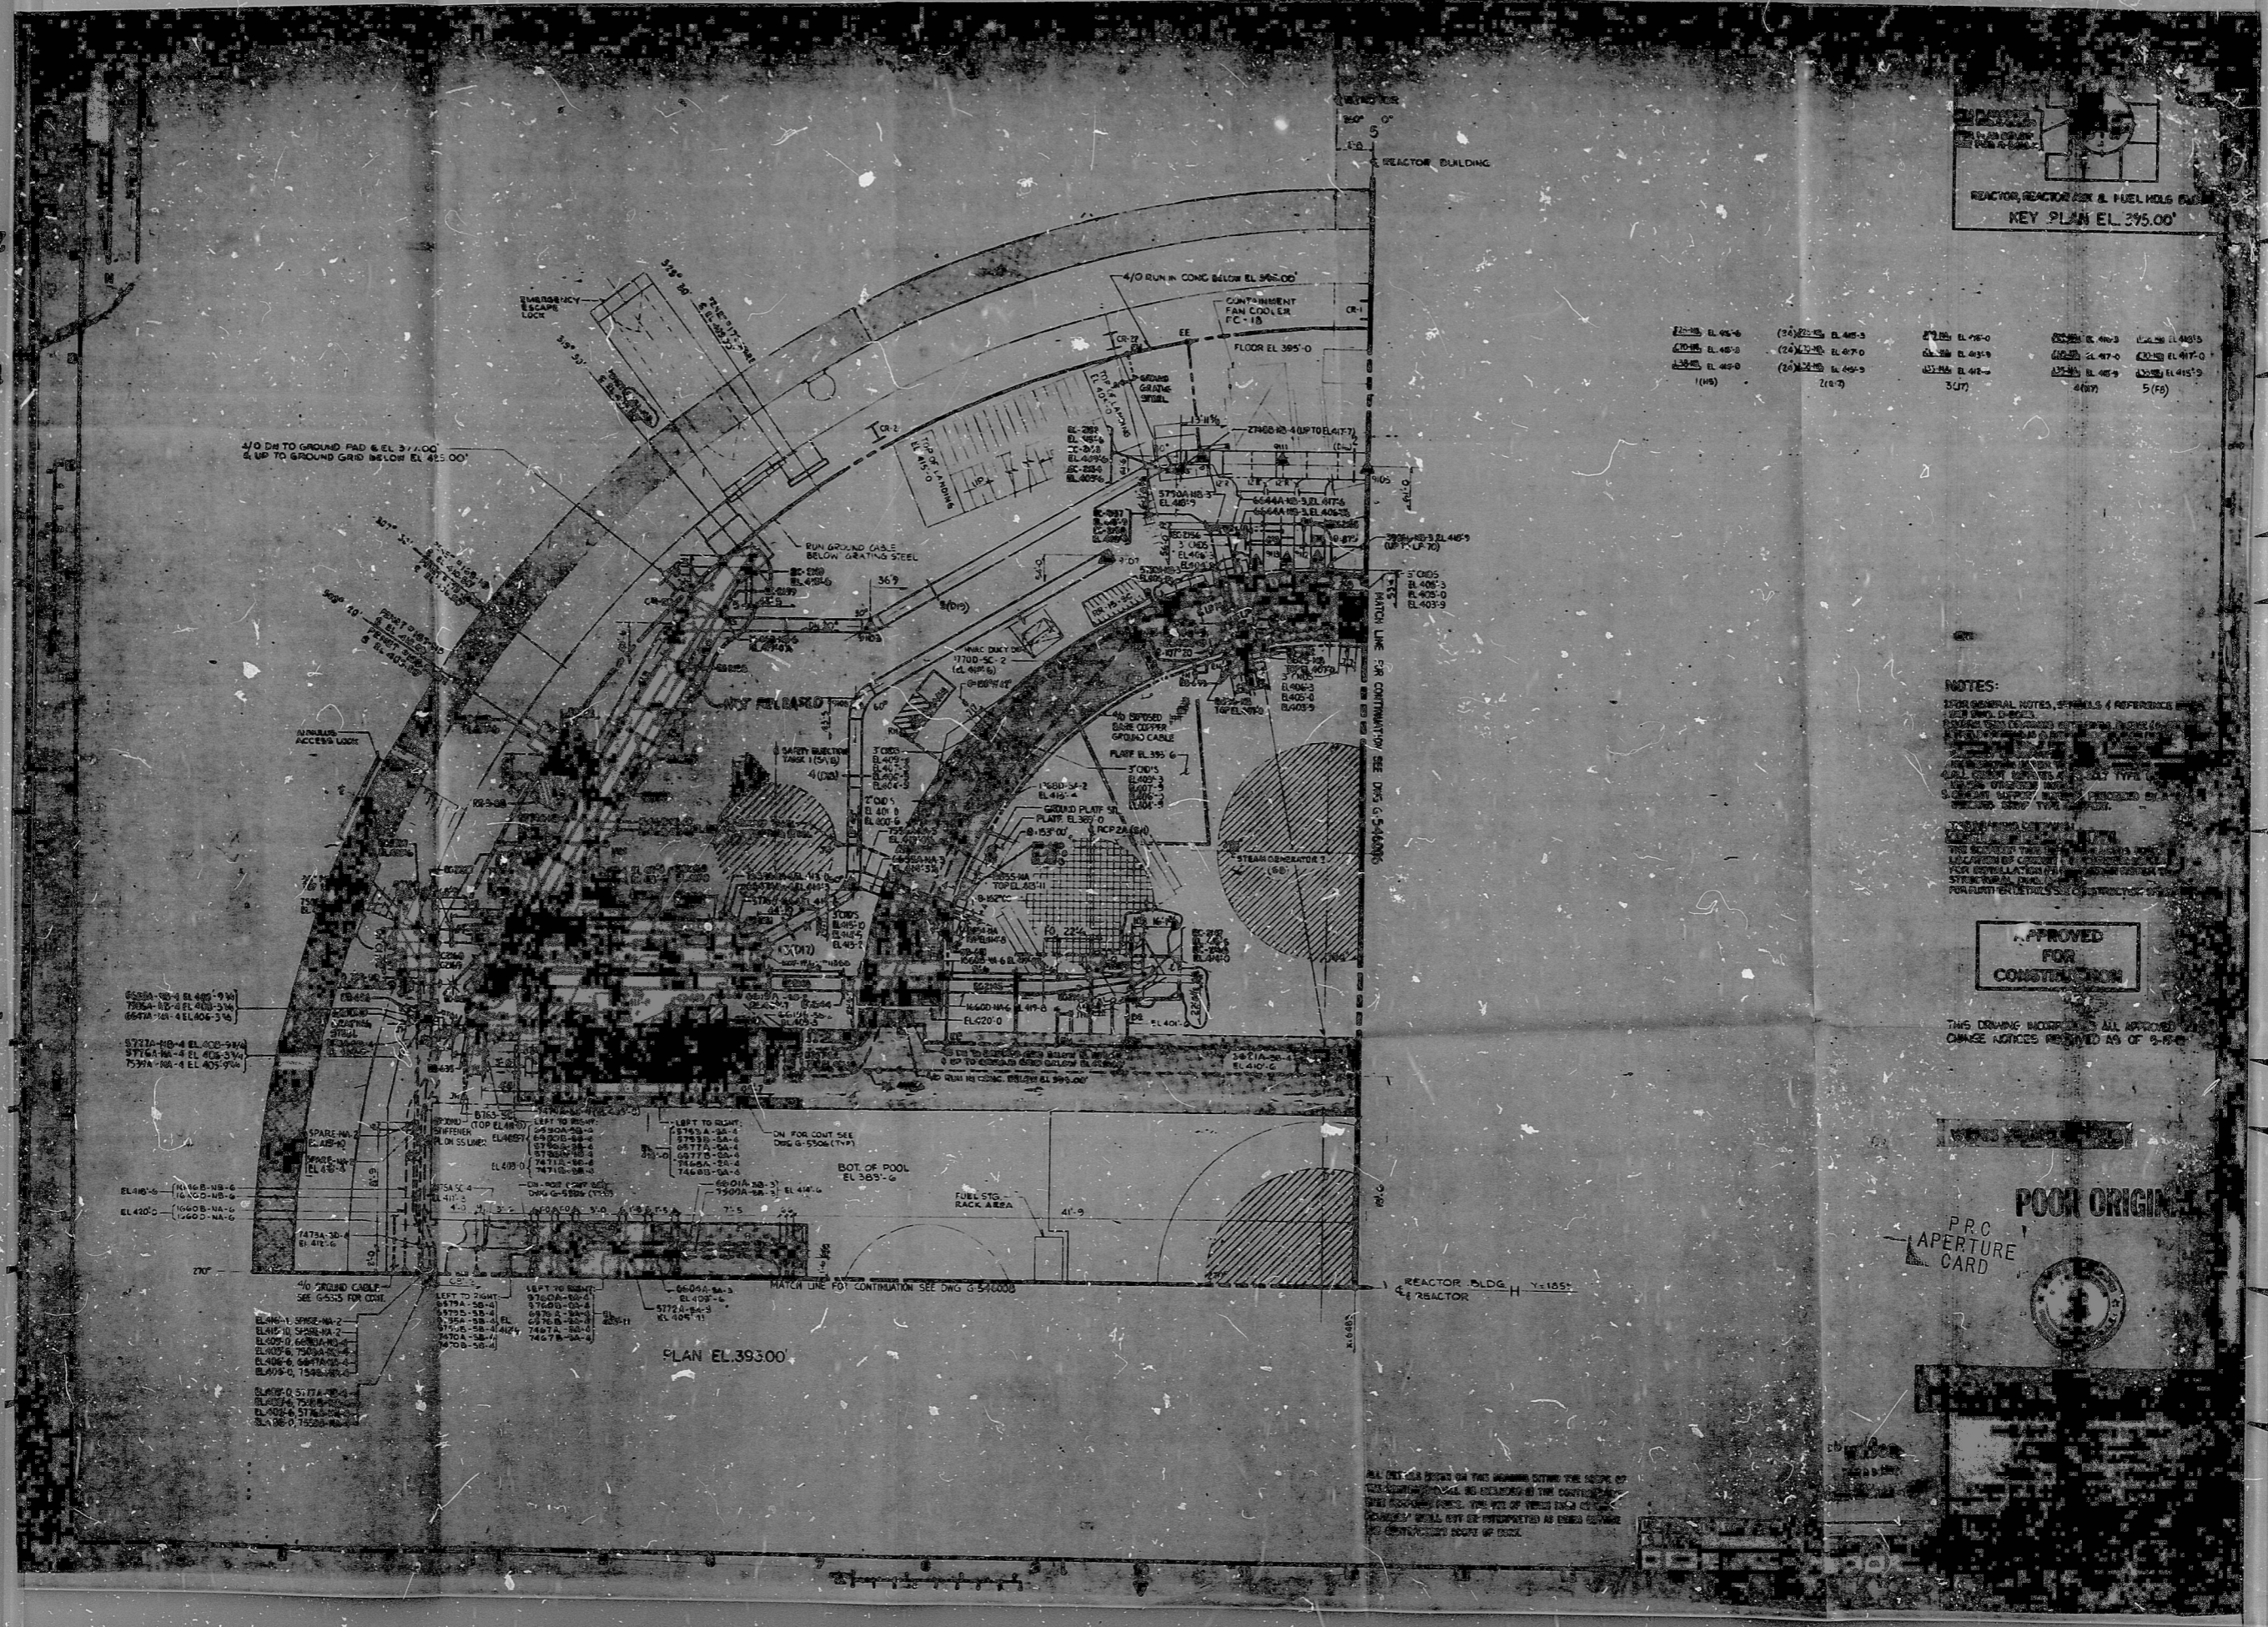

REACTOR, REACTOR BLDG & FUEL HOLES BLDG  
KEY PLAN EL. 395.00'

(18)	(7)	(17)	(17)	(17)	(17)

NOTES:

1. REFER TO GENERAL NOTES, SPECIFICATIONS & REFERENCES FOR THIS DRAWING.  
2. ALL DIMENSIONS UNLESS OTHERWISE SPECIFIED ARE IN FEET & INCHES.  
3. ALL DIMENSIONS SHALL BE TO FACE UNLESS OTHERWISE SPECIFIED.  
4. ALL DIMENSIONS SHALL BE TO CENTER UNLESS OTHERWISE SPECIFIED.  
5. ALL DIMENSIONS SHALL BE TO SURFACE UNLESS OTHERWISE SPECIFIED.  
6. ALL DIMENSIONS SHALL BE TO CENTERLINE UNLESS OTHERWISE SPECIFIED.  

APPROVED FOR CONSTRUCTION

THIS DRAWING INCORPORATES ALL APPROVED CHANGE NOTICES REVISED AS OF 9-15-61

POOL ORIGINAL

P.R.C. APERTURE CARD



PLAN EL. 393.00




**RIDS**

8303240302

