



WPPSS-3240-G-546009

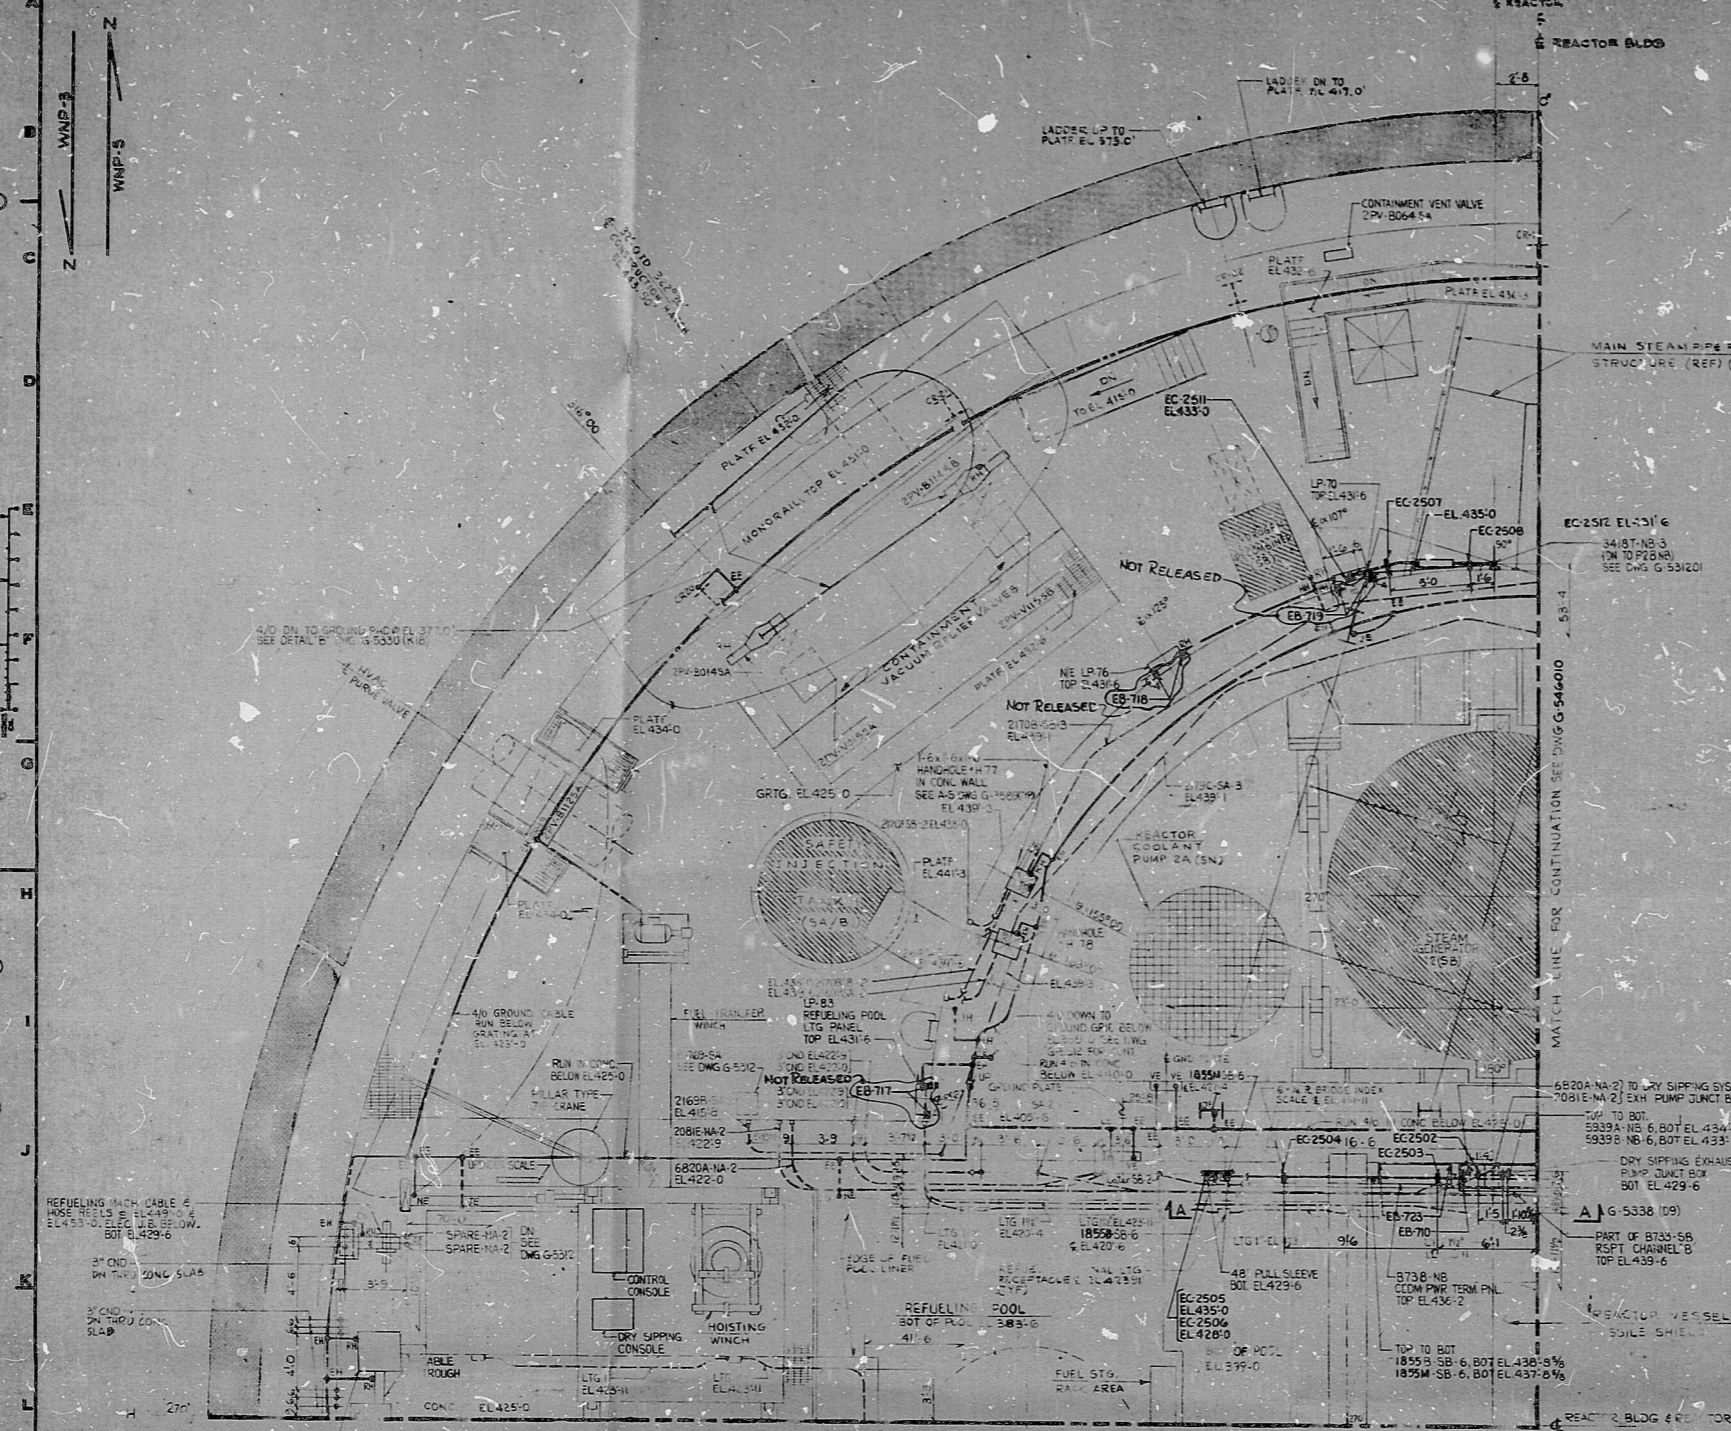

PLAN EL. 425.00

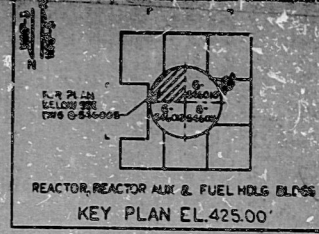

NOTES:

1. FOR GENERAL NOTES, SYMBOLS & REFERENCE DWGS. SEE DWG. D-5023.
2. WORK THIS DWG. WITH DWGS. G-5310 (G-531801) AND G-5311 ONLY FOR CONDUIT & BOX SUPPORT INFORMATION. FOR ALL OTHER ELECTRICAL INFORMATION REFER TO DWGS. G-5310 (G-531801).
3. ALL CONDUIT SUPPORTS ARE LUG-BOLT TYPE SUPPORTS UNLESS OTHERWISE NOTED.
4. CONDUIT SUPPORT NOS. PRECEDED BY A "S" INDICATES PIPE TYPE STRAPS.

THIS DRAWING CONTAINS:
 CONSTRUCTION CONTRACT NO. 259
 THE SCOPE OF THE 259 CONTRACT IS FOR LOCATION OF CONDUIT & BOX SEISMIC SUPPORTS, FOR INSTALLATION AND FABRICATION DETAILS REFER TO STRUCTURAL DWG. G-3474. FOR FURTHER DETAILS SEE CONSTRUCTION SPECIFICATION.

APPROVED FOR CONSTRUCTION

ALL DETAILS SHOWN ON THIS DRAWING WITHIN THE SCOPE OF THE CONTRACT SHALL BE INCLUDED IN THE CONTRACTOR'S SHOP PROPOSAL. THE USE OF TERMS SUCH AS "NOT RELEASED" SHALL NOT BE INTERPRETED AS BEING OUTSIDE THE CONTRACTOR'S SCOPE OF WORK.

THIS DWG. INCORPORATES ALL APPROVED 413 CHANGE NOTICES RECEIVED AS OF 7-15-61.

WPPSS QUALITY CLASS I, II, G

SEP 04 1961
 CONSTRUCTION - SITE

POOR ORIGINAL

PRO APERTURE CARD

NUCLEAR SAFETY RELATED

WASHINGTON PUBLIC POWER SUPPLY SYSTEM
 NUCLEAR PRODUCTS DIVISION
 REACTOR BUILDING EL. 425.00
 COMPANY & CONTRACTOR SUPPORTS

RIDS

8303240312

