

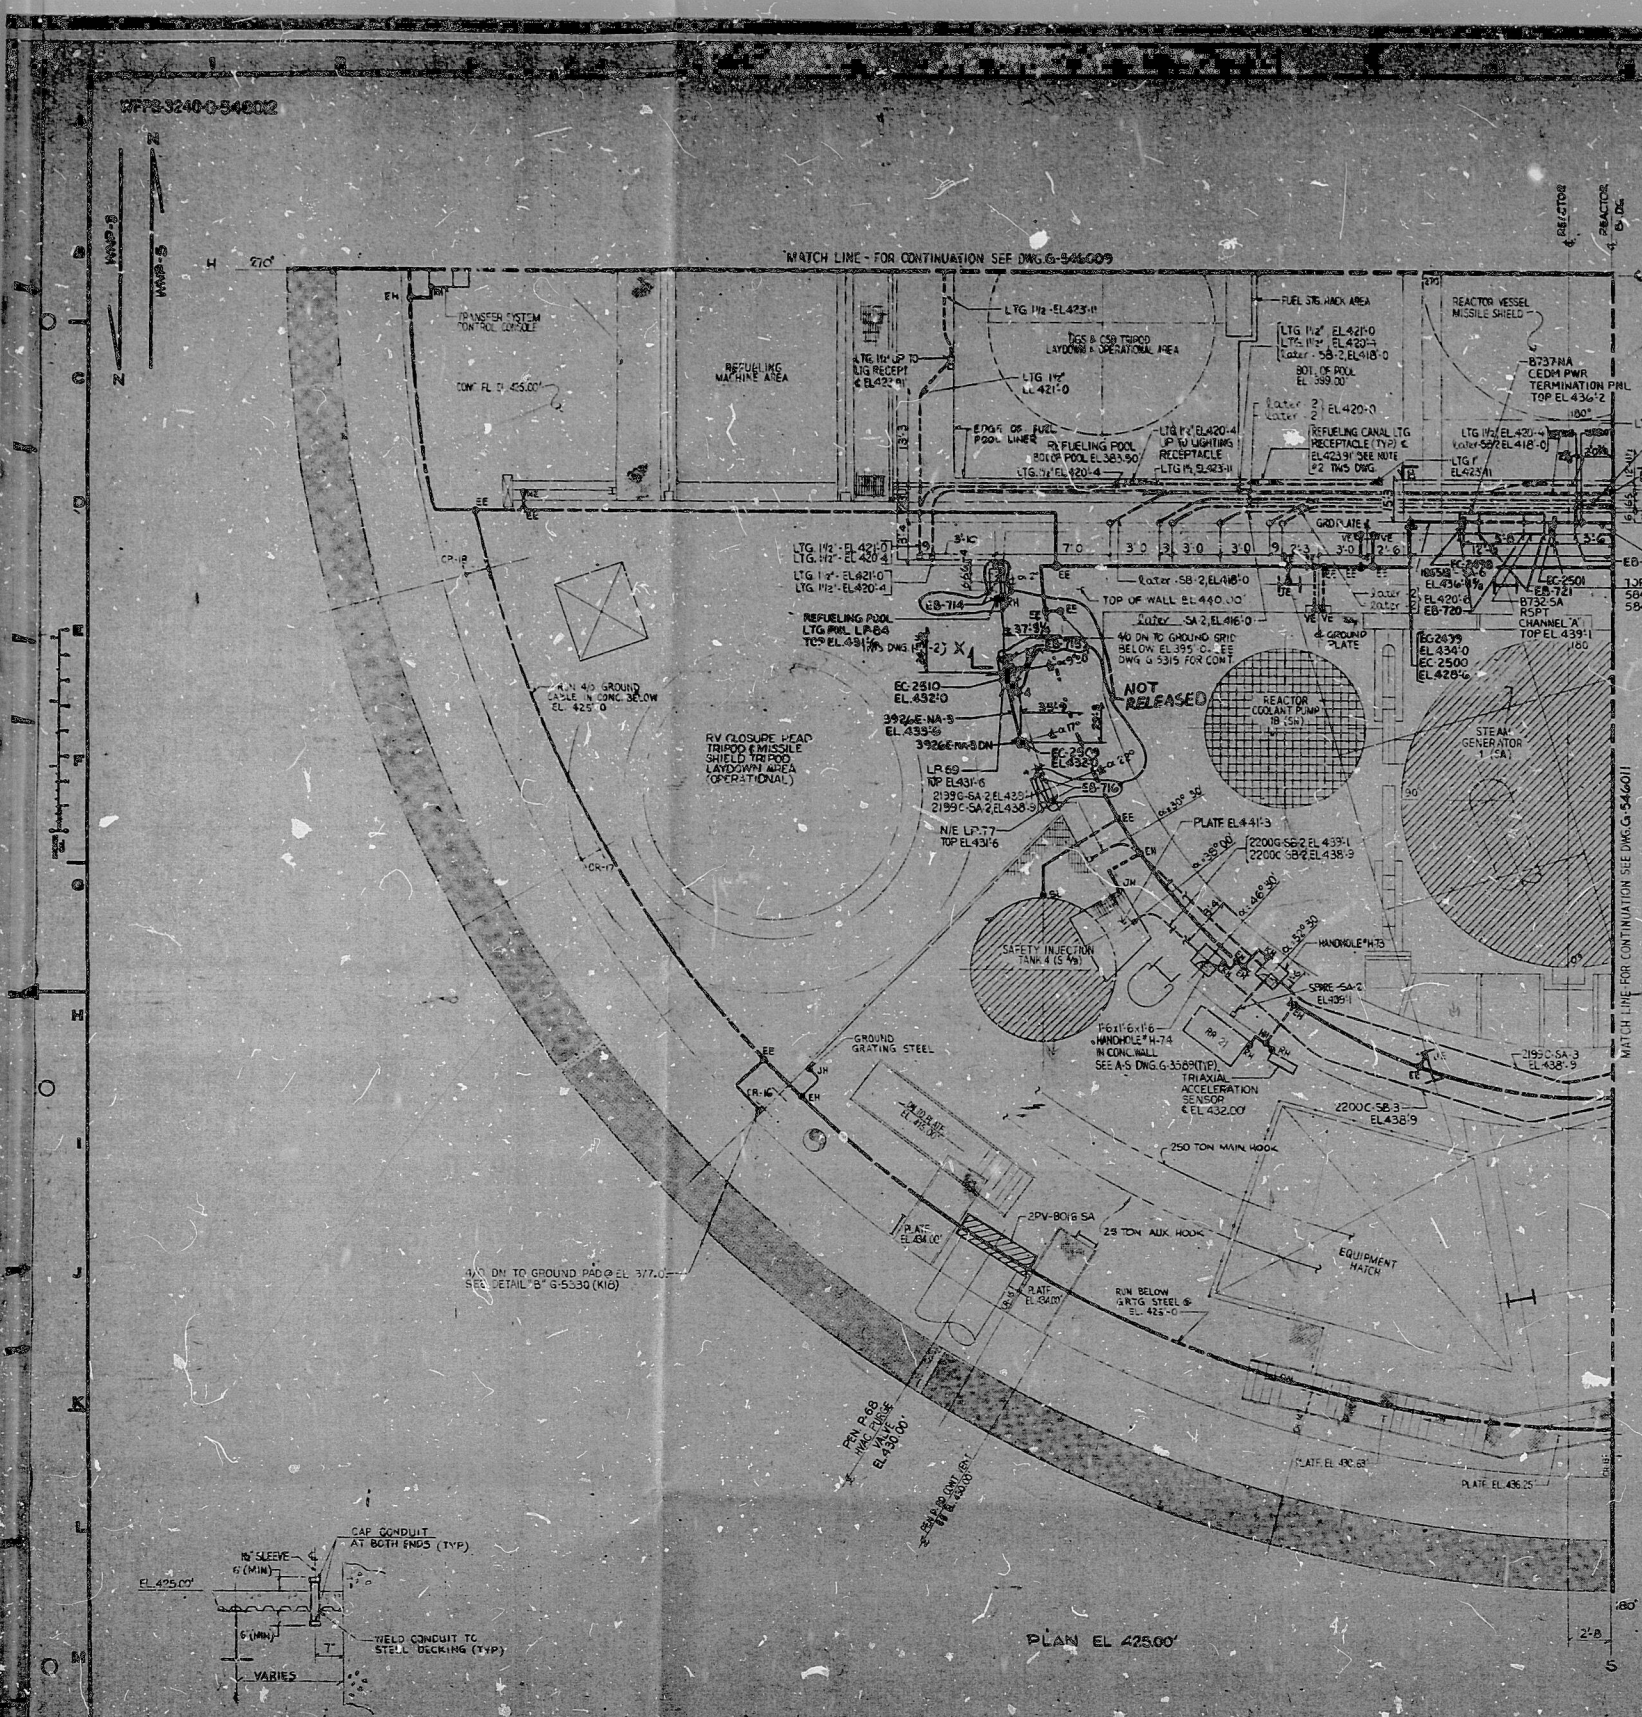


DWG NO. 3440-546012

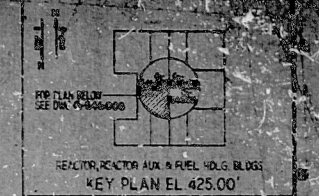

PLAN EL 425.00'

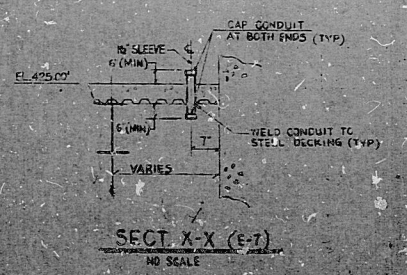

NOTES

- 1. FOR GENERAL NOTES, SYMBOLS & REFERENCE DWGS. SEE DWG. 0-5023.
- 2. WORK THIS DWG. WITH DWGS. 0-3521 (0-5321).
- 3. THIS DWG. IS A REPRODUCTION OF DWG. 0-5321 (0-5321) AND IS VALID ONLY FOR CONDUIT & BOX SUPPORT INFORMATION. FOR ALL OTHER ELECTRICAL INFORMATION REFER TO DWG. 0-5321 (0-5321).
- 4. ALL CONDUIT SUPPORTS ARE U-BOLT TYPE SUPPORTS UNLESS OTHERWISE NOTED.
- 5. CONDUIT SUPPORT NOS. PRECEDED BY A "S" INDICATES PIPE TYPE STRAPS.

THIS DRAWING CONTAINS:
 CONSTRUCTION CONTRACT NO. 233
 THE SCOPE OF THE 299 CONTRACT IS FOR LOCATION OF CONDUIT & BOX SEISMIC SUPPORTS. FOR INSTALLATION & FABRICATION DETAILS REFER TO STRUCTURAL DWGS. 0-5495. FOR FURTHER DETAILS SEE CONSTRUCTION SPECIFICATION.

APPROVED FOR CONSTRUCTION


THIS DWG. INCORPORATES ALL APPROVED G15 CHANGE NOTICES RECEIVED AS OF 7-15-61.

WPPSS QUALITY CLASS I, II, G

EBASCO
 SEP 04 1961
 CONSTRUCTION SITE



PRC
 APERTURE
 CARD

RIDS

8303240321

