
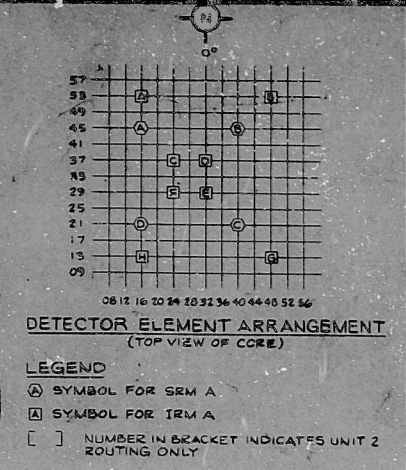


[illegible]

RIDS

8110190276

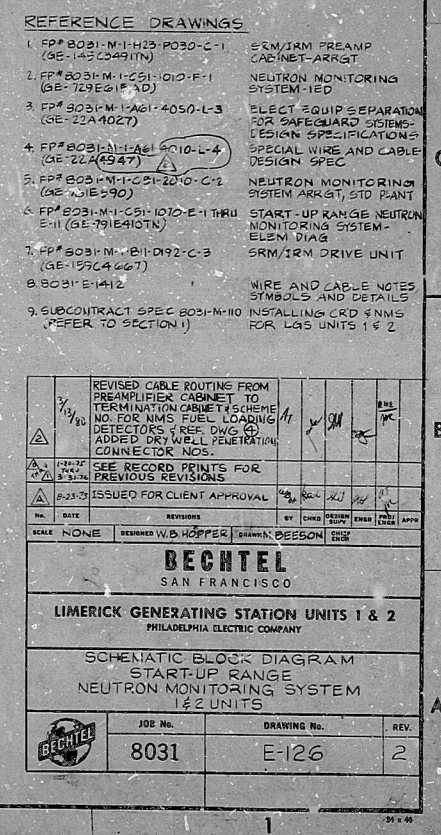