

34

36

22

22

17

17

14

14

9

9

8.5"

8.5"

11"


11"

17"

17"

22"

22"

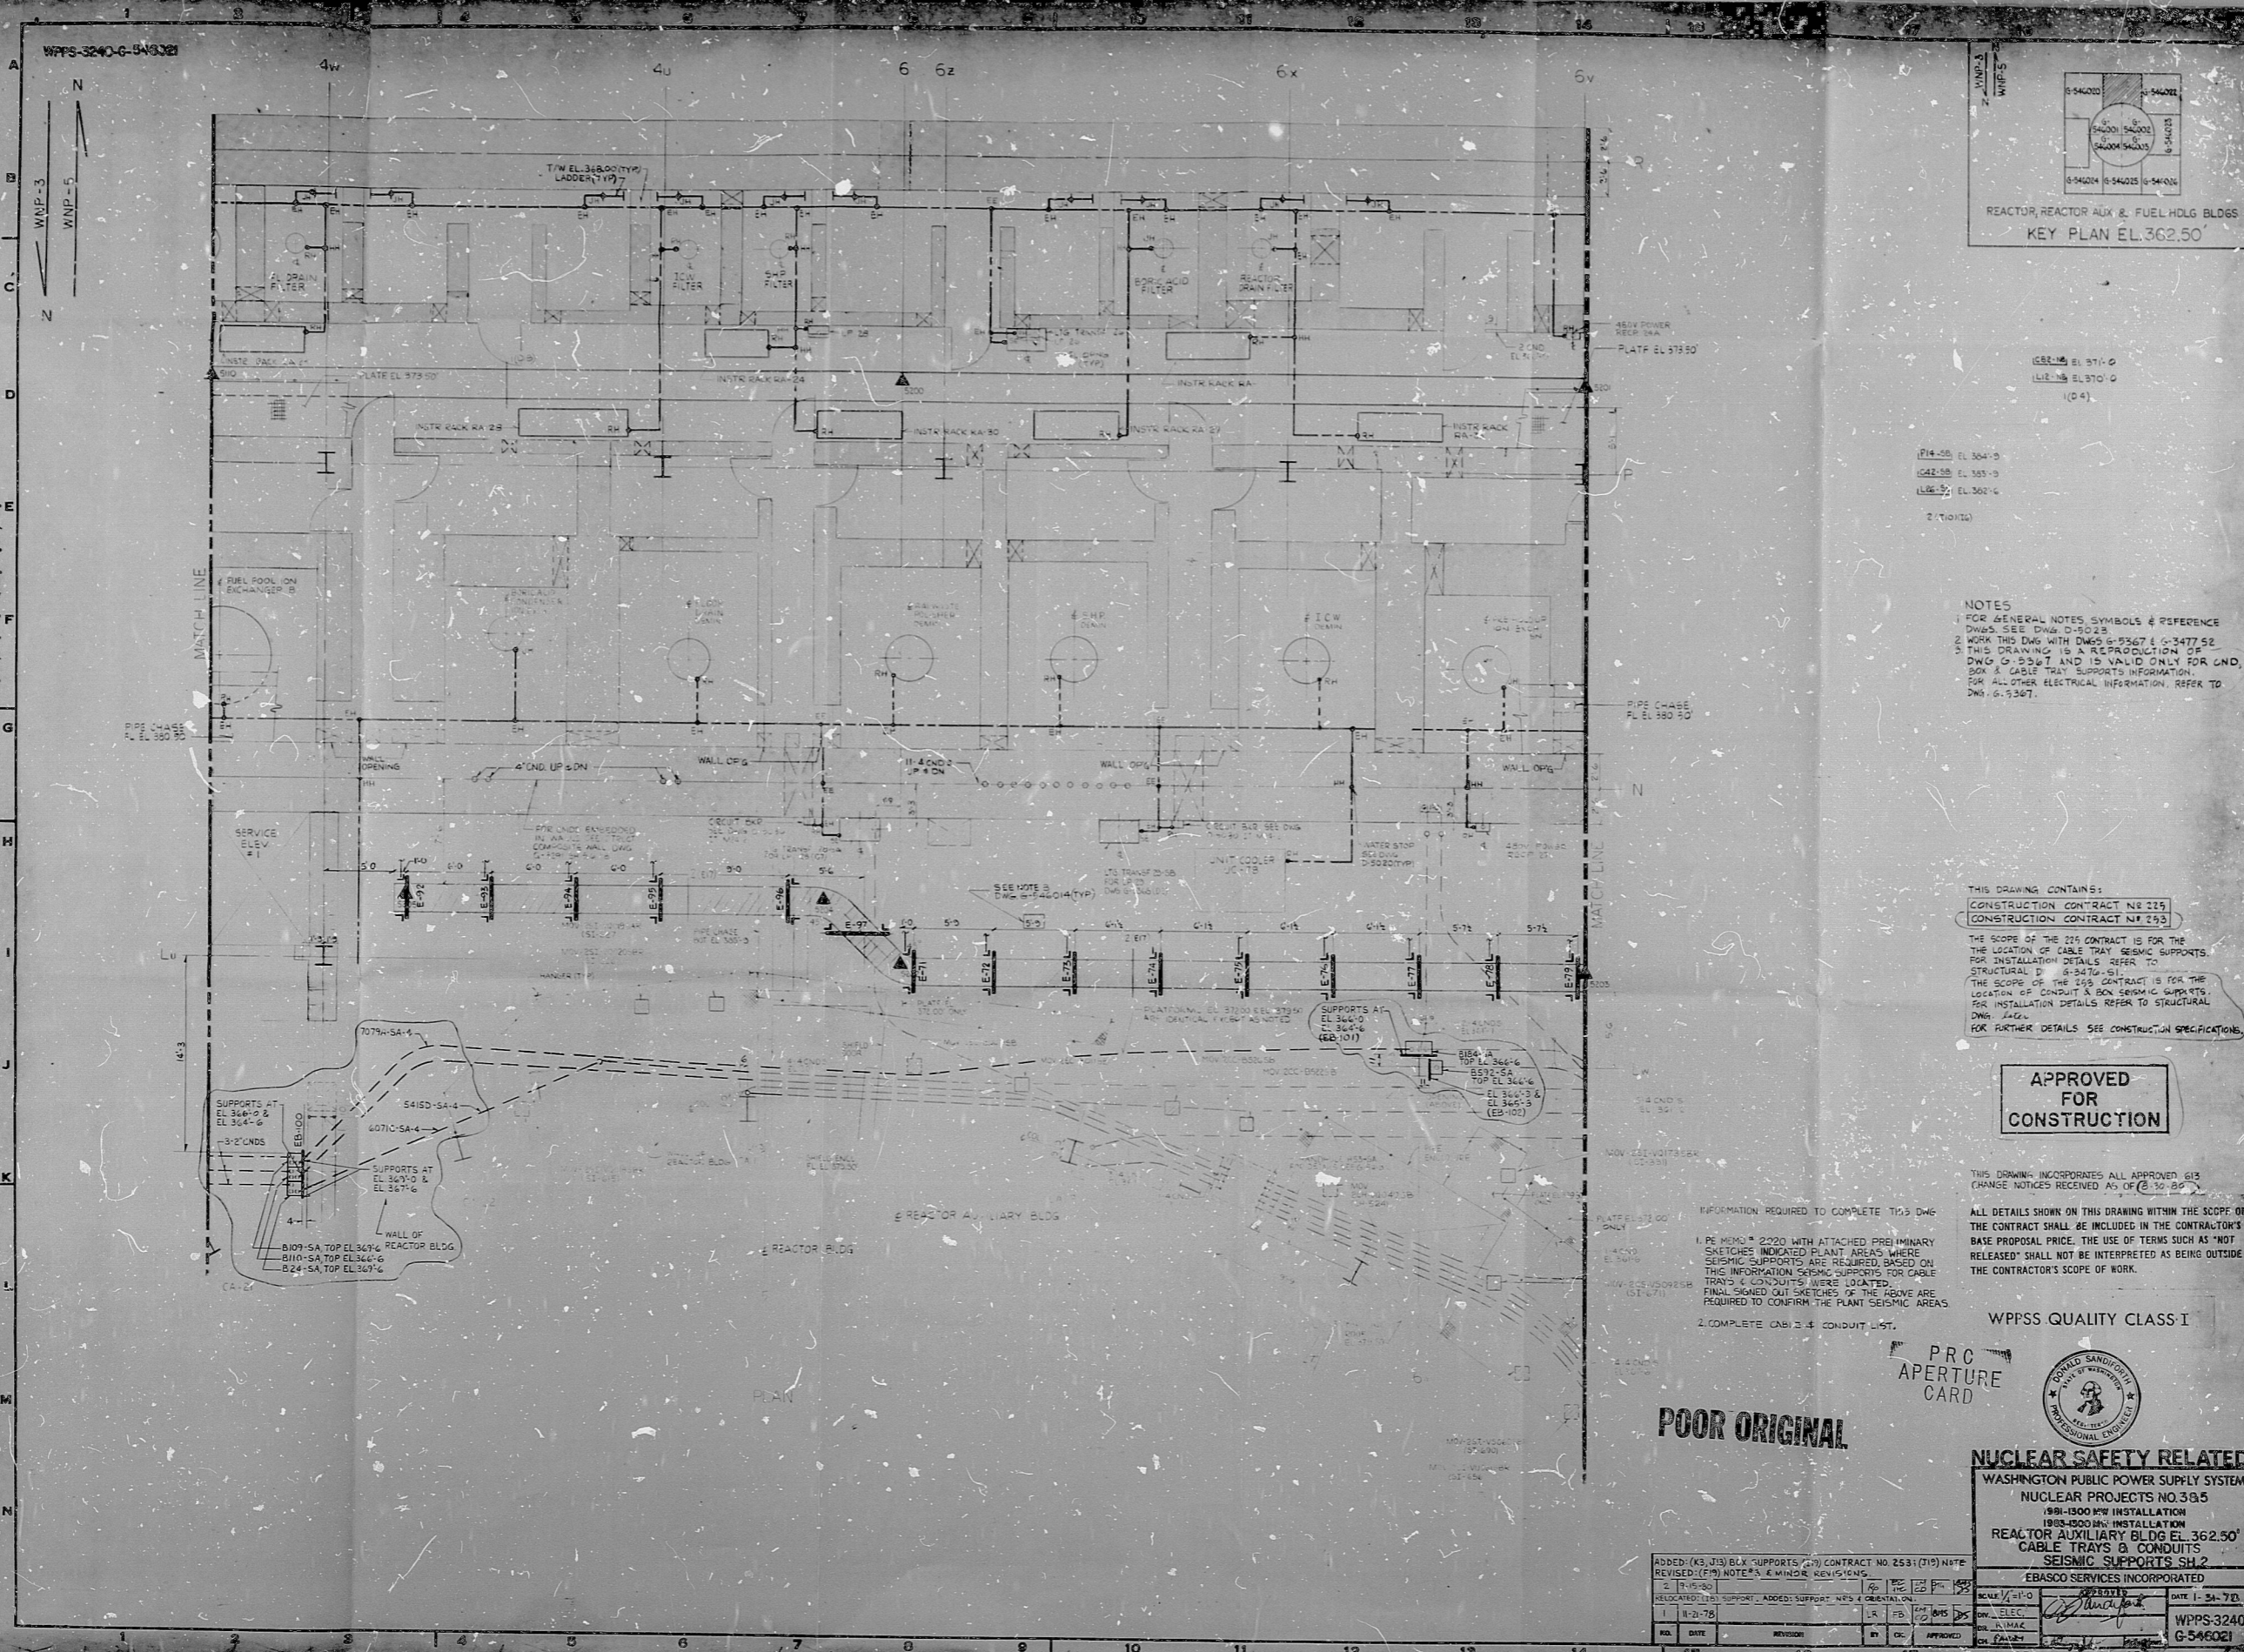

RIDS

8303240340

