
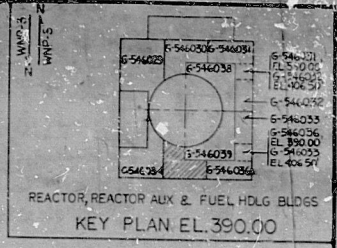


34
22
17
11
8.5
11
17
22
34

22
17
11
8.5
11
17
22

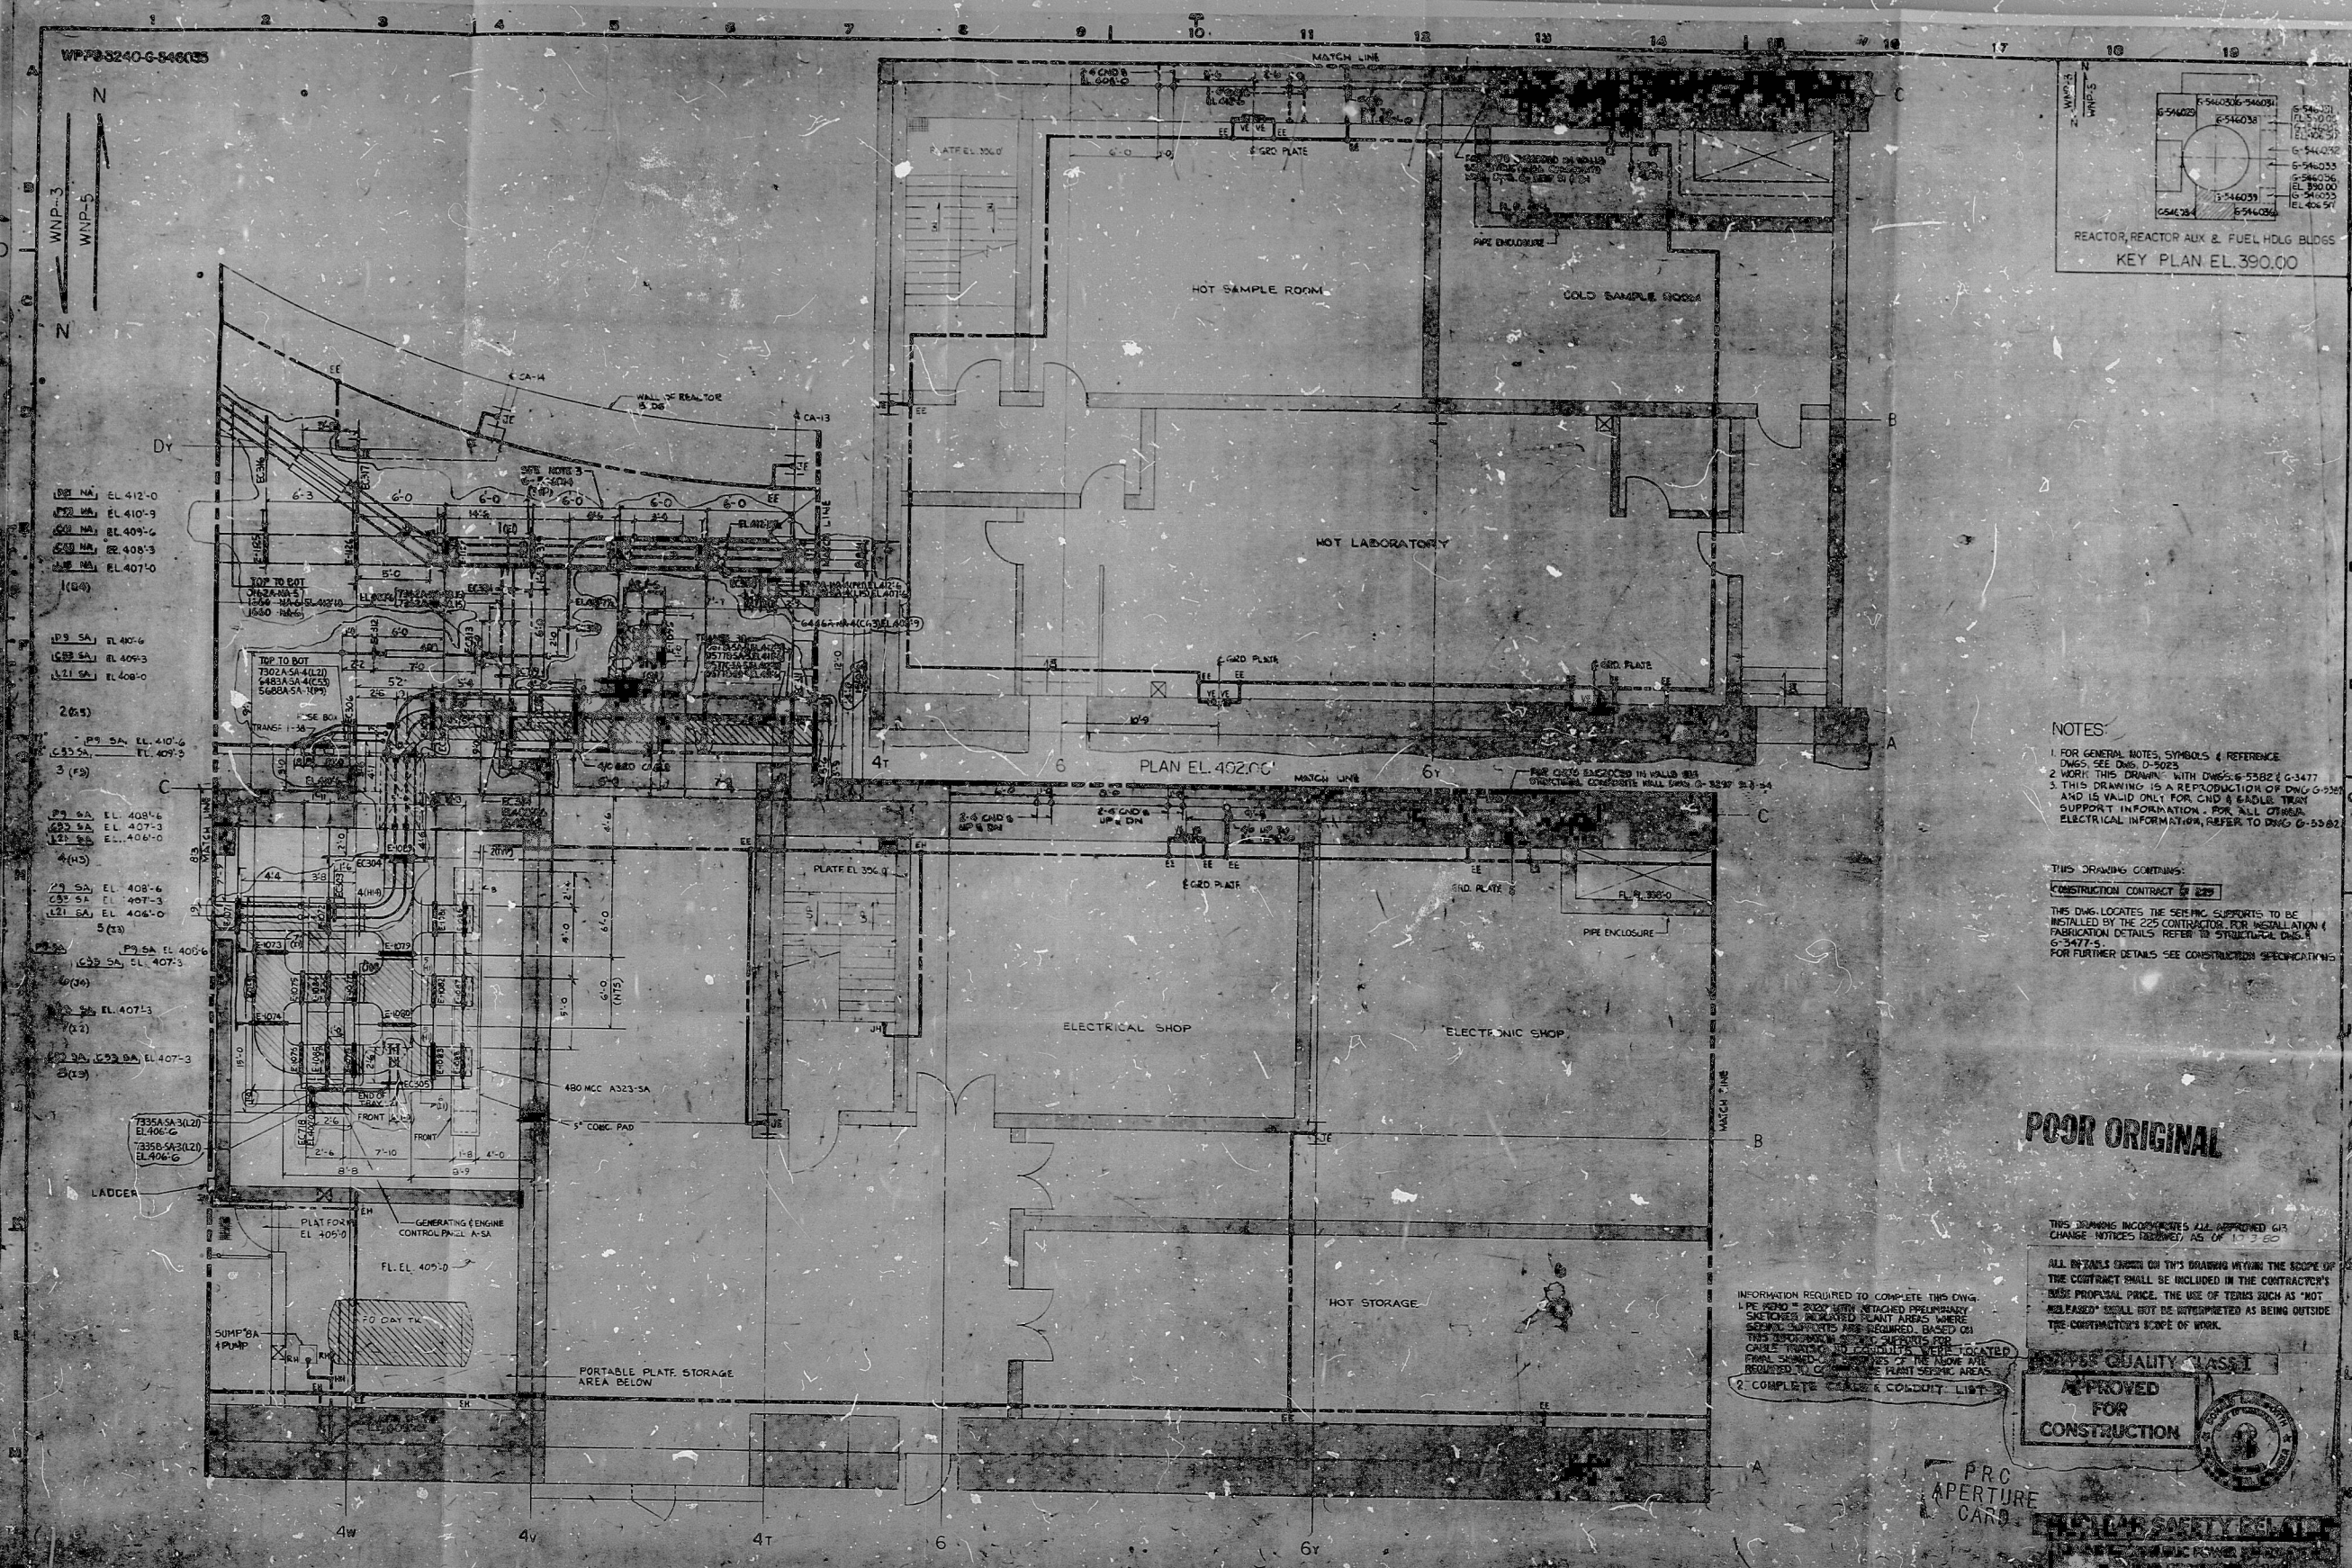


NOTES:

1. FOR GENERAL NOTES, SYMBOLS & REFERENCE DWGS: SEE DWG. D-5025
2. WORK THIS DRAWING WITH DWGS. G-5382 & G-3477
3. THIS DRAWING IS A REPRODUCTION OF DWG. G-5381 AND IS VALID ONLY FOR CHD & BLDG. TEAM SUPPORT INFORMATION. FOR ALL OTHER ELECTRICAL INFORMATION, REFER TO DWG. G-5382

THIS DRAWING CONTAINS:
CONSTRUCTION CONTRACT NO. 222

THIS DWG. LOCATES THE SEWING SUPPORTS TO BE INSTALLED BY THE 225 CONTRACTOR. FOR INSTALLATION & FABRICATION DETAILS, REFER TO STRUCTURAL DWG. G-3477-S.
FOR FURTHER DETAILS SEE CONSTRUCTION SPECIFICATIONS

POOR ORIGINAL

THIS DRAWING INCORPORATES ALL APPROVED CHG. CHANGE NOTICES RECEIVED AS OF 11-3-60

ALL DETAILS SHOWN ON THIS DRAWING WITHIN THE SCOPE OF THE CONTRACT SHALL BE INCLUDED IN THE CONTRACTOR'S BASE PROPOSAL PRICE. THE USE OF TERMS SUCH AS "NOT RELEASED" SHALL NOT BE INTERPRETED AS BEING OUTSIDE THE CONTRACTOR'S SCOPE OF WORK.

INFORMATION REQUIRED TO COMPLETE THIS DWG.:

2. COMPLETE WALK & CORDON LIST.

QUALITY CLASS 1

APPROVED FOR CONSTRUCTION

PRC APERTURE CARD

RIDS

8303290025

