


98WS 6-3

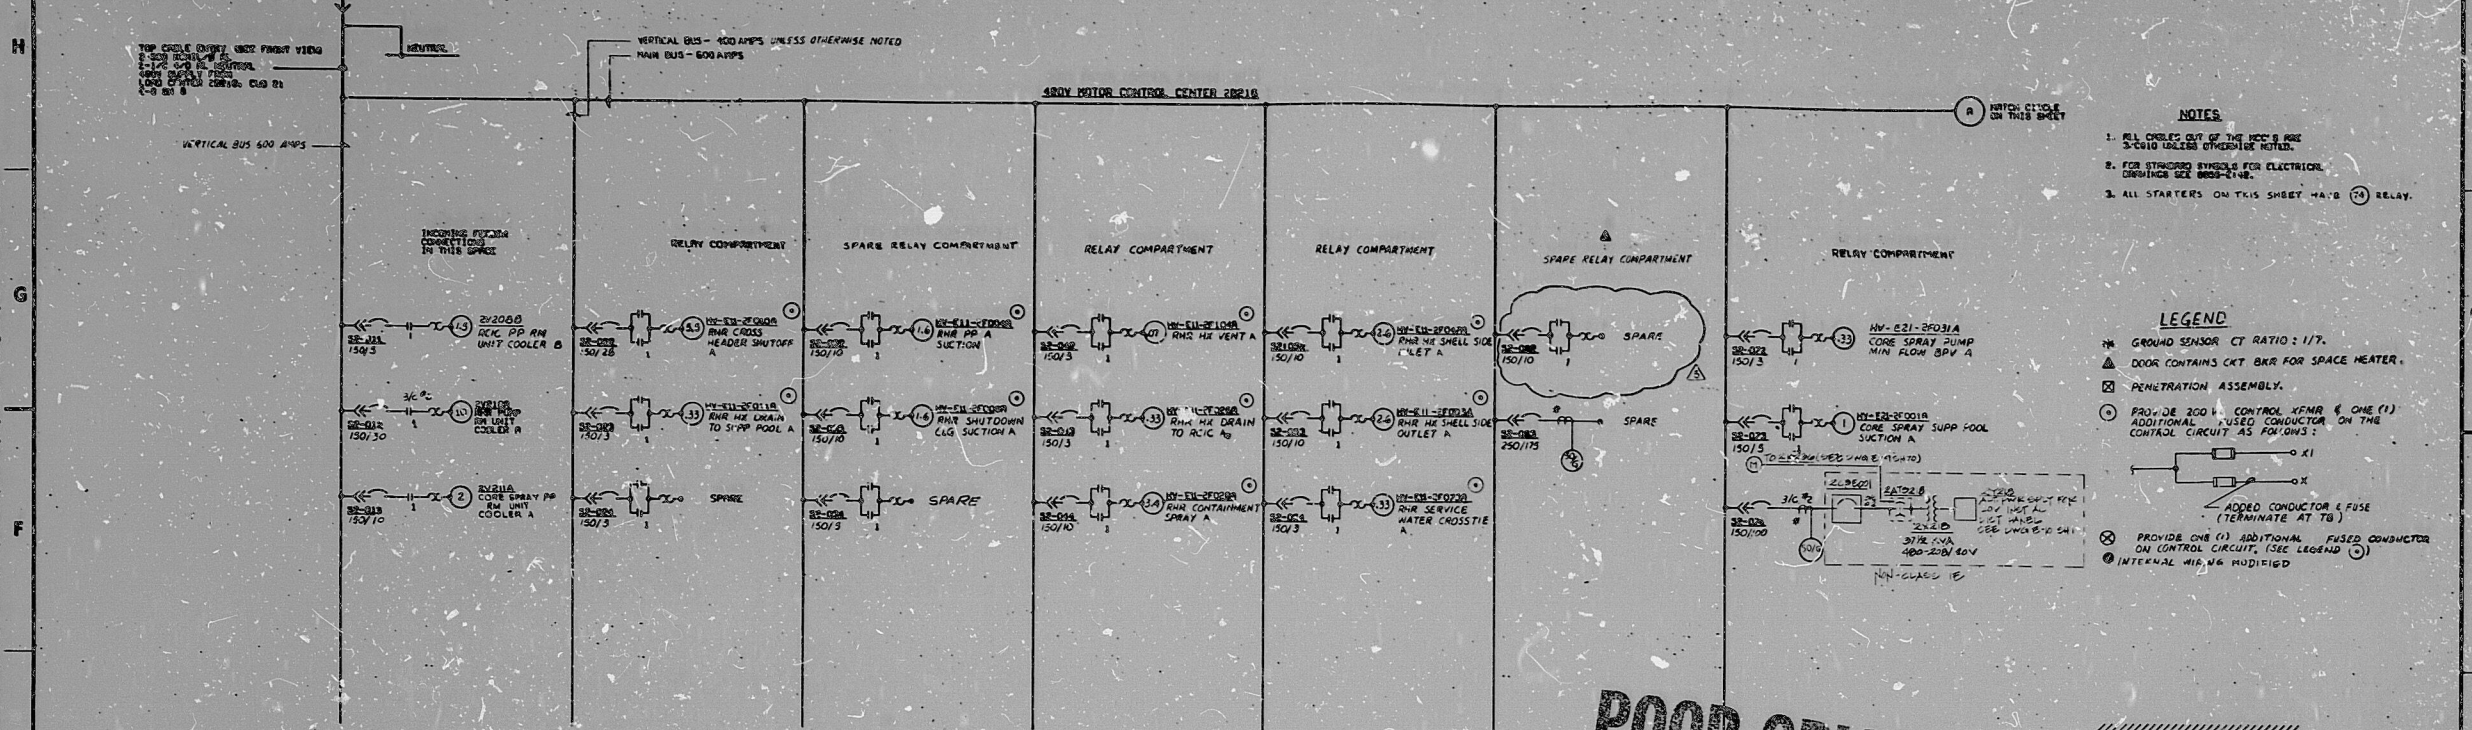

- NOTES

- LEGEND
- GROUND SENSOR CT RATIO: 1/7.
 - DOOR CONTAINS CAT BAR FOR SPACE HEATER.
 - PENETRATION ASSEMBLY.
 - PROVIDE ONE (1) ADDITIONAL CONTROL WIRE & ONE (1) ADDITIONAL FUSED CONDUCTOR ON THE CONTROL CIRCUIT AS FOLLOWS:
 - ADD CONDUCTOR & FUSE (TERMINATE AT TB)
 - PROVIDE ONE (1) ADDITIONAL FUSED CONDUCTOR ON CONTROL CIRCUIT (SEE LEGEND)
 - INTERNAL WIRING MODIFIED

POOR ORIGINAL

PRO APERTURE CARD


UNCONTROLLED DOCUMENT FOR REFERENCE ONLY

TOP CABLE ENTRY									


BECHTEL - SAN FRANCISCO

SINGLE LINE METER & RELAY DIAGRAM

480V MOTOR CONTROL CENTER

2216-001

UNIT 3

8036 E-9, SH66 5

E-107153 SH66 0

8303290373

KWS

