


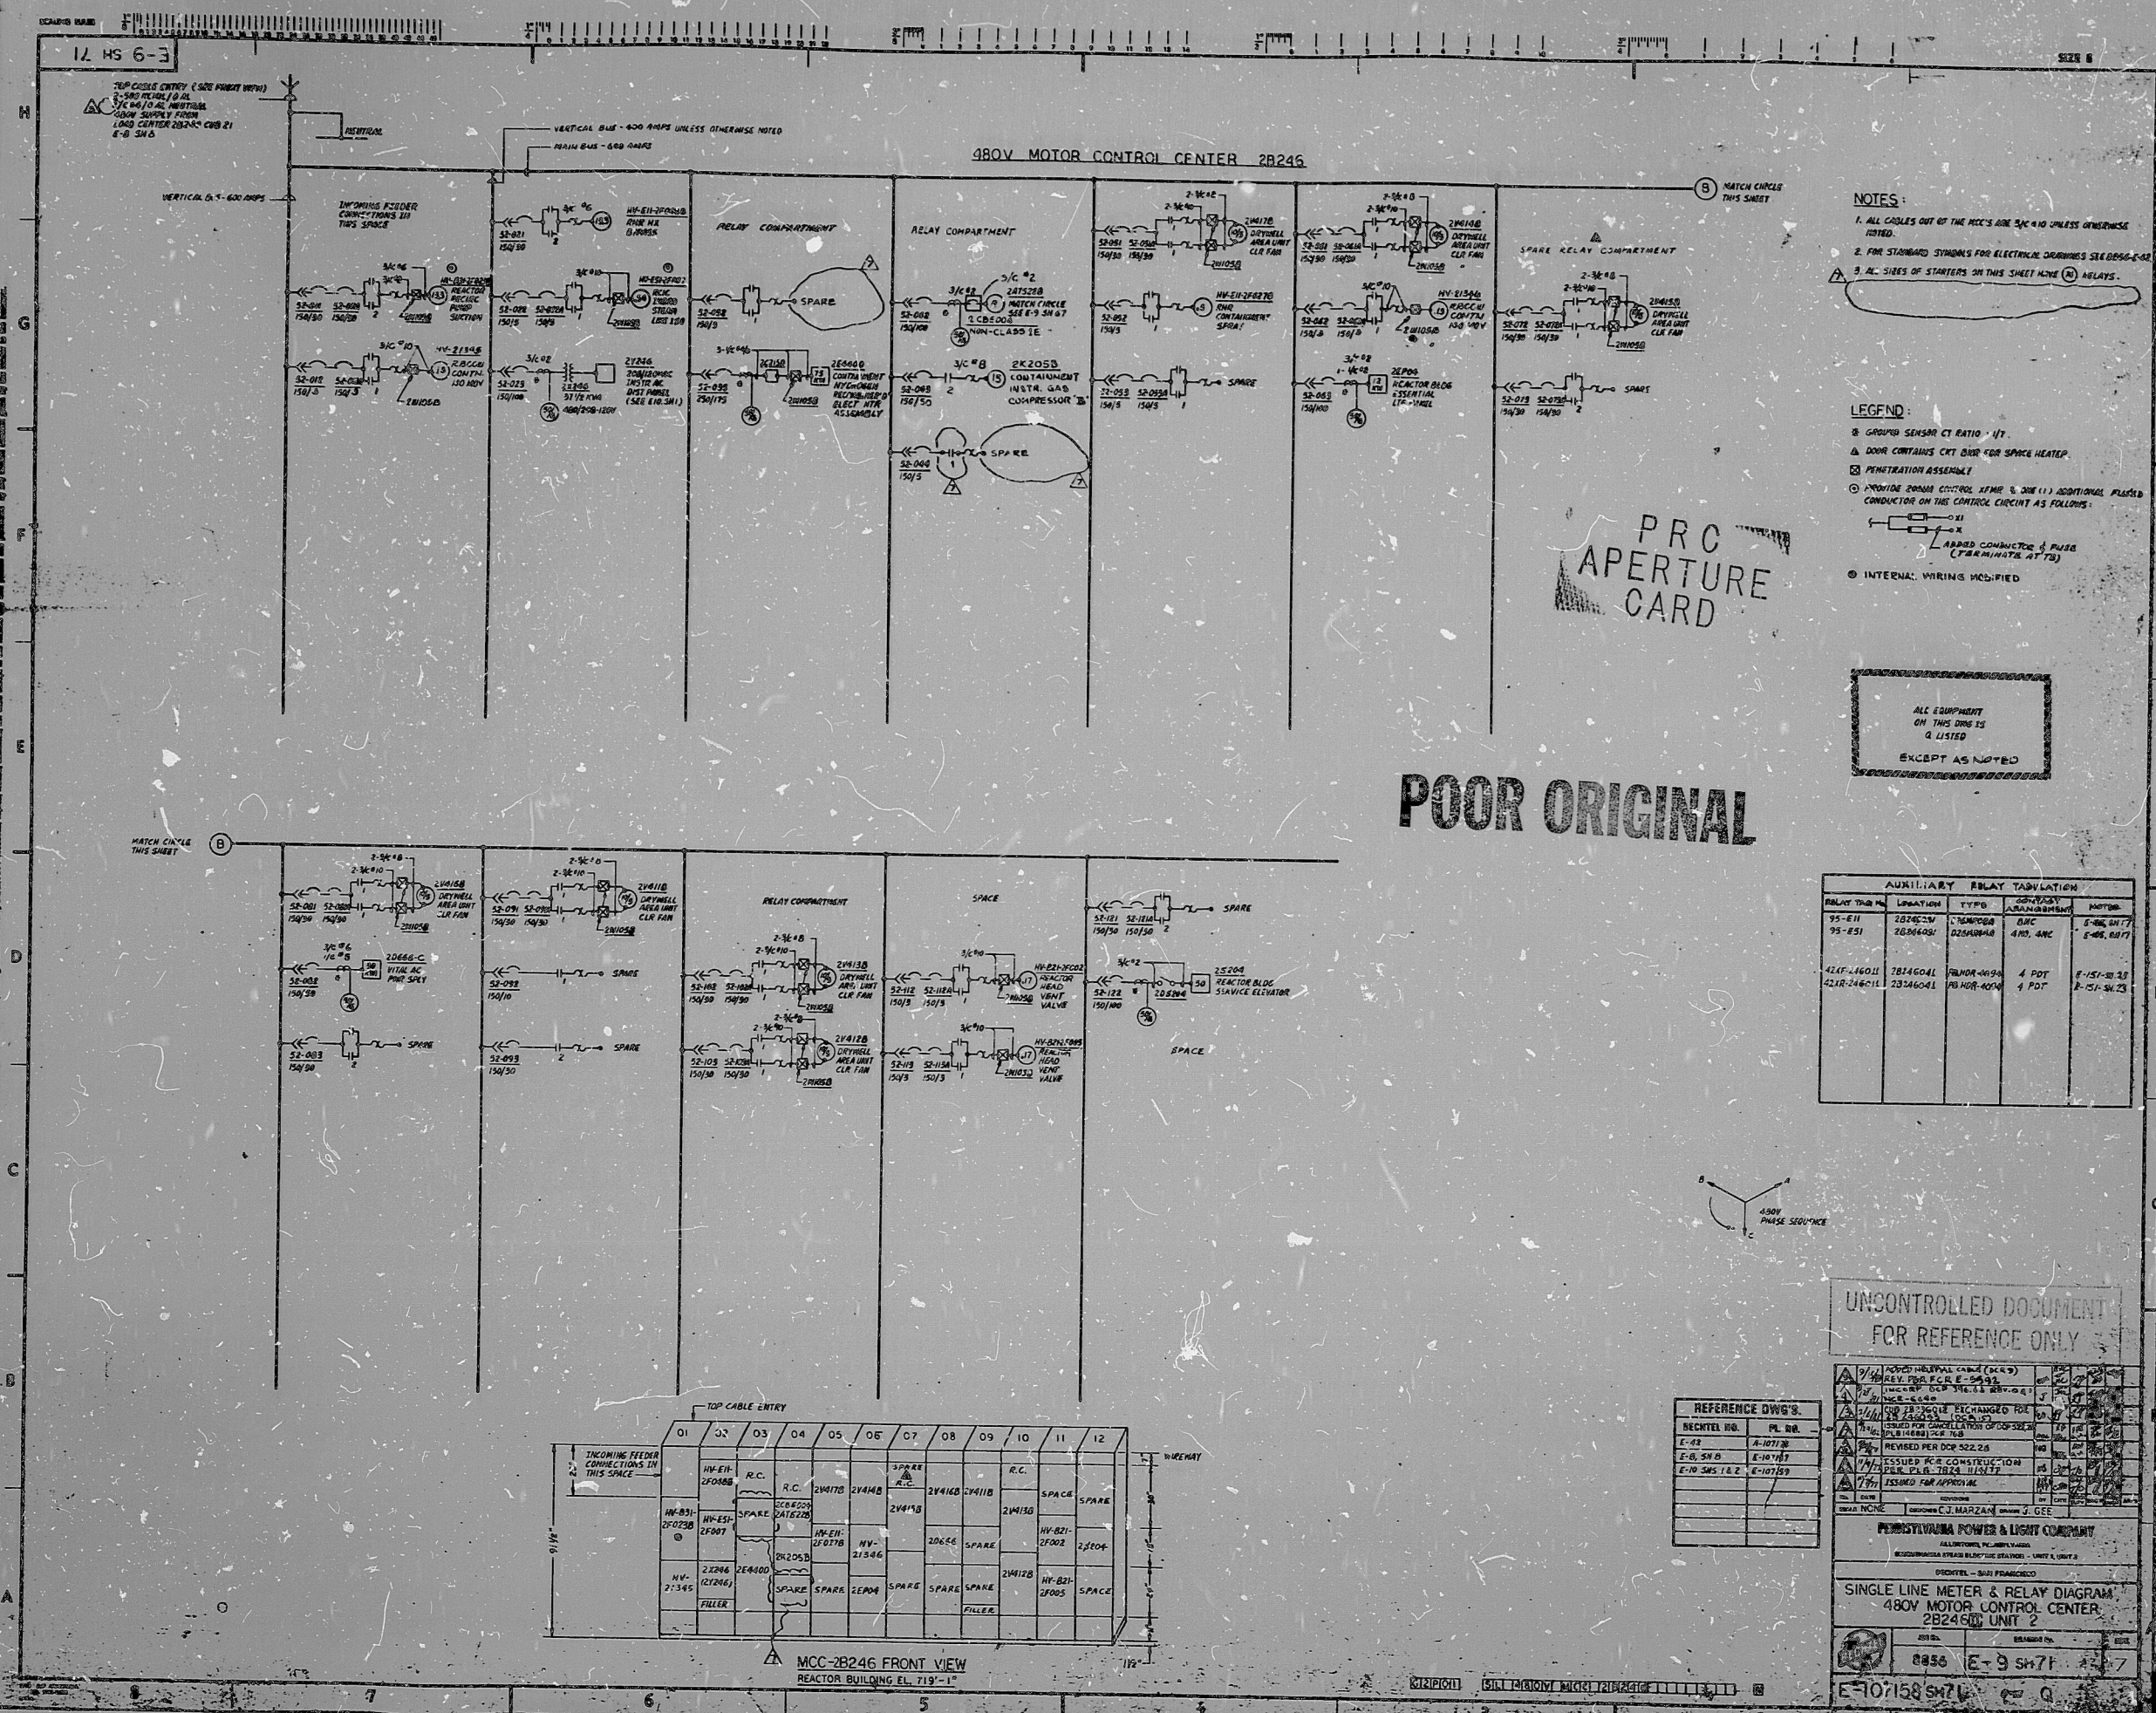

- NOTES:
1. ALL CABLES OUT OF THE MCC'S ARE 3/4" 10 UNLESS OTHERWISE NOTED.
 2. FOR STANDARD SYMBOLS FOR ELECTRICAL DRAWINGS SEE D550-0-01.
 3. ALL SIZES OF STARTERS ON THIS SHEET HAVE (N) RELAYS.

- LEGEND:
- 8. GROUPED SENSORS CT RATIO - 1/1.
 - 9. DOOR CONTAINS CXT DWR FOR SPACE HEATER.
 - 10. PENETRATION ASSEMBLY.
 - 11. PROVIDE ZONAL CONTROL ATME 5.00E (1) ADDITIONAL PLESED CONDUCTOR ON THE CONTROL CIRCUIT AS FOLLOWS:
 - 12. LEADED CONDUCTOR 4.00E (1) PLESED (FURNISH AT 75).
 - 13. INTERNAL WIRING MODIFIED.

ALL EQUIPMENT ON THIS DRAWING IS LISTED EXCEPT AS NOTED

AUXILIARY RELAY TABULATION				
RELAY TYPE	LOCATION	TYPE	DESCRIPTION	NOTES

UNCONTROLLED DOCUMENT FOR REFERENCE ONLY

REFERENCE DWS'S	
REVISION NO.	PL. NO.
E-02	A-10710
E-03	A-10710

REACTOR BUILDING EL. 719-11

PROJECT - 2B246

SINGLE LINE METER & RELAY DIAGRAM

480V MOTOR CONTROL CENTER

2B246 UNIT 2


BY: 107158 SH71

Q

8303290392

RIDS

