


WPPS-3240-G-546041

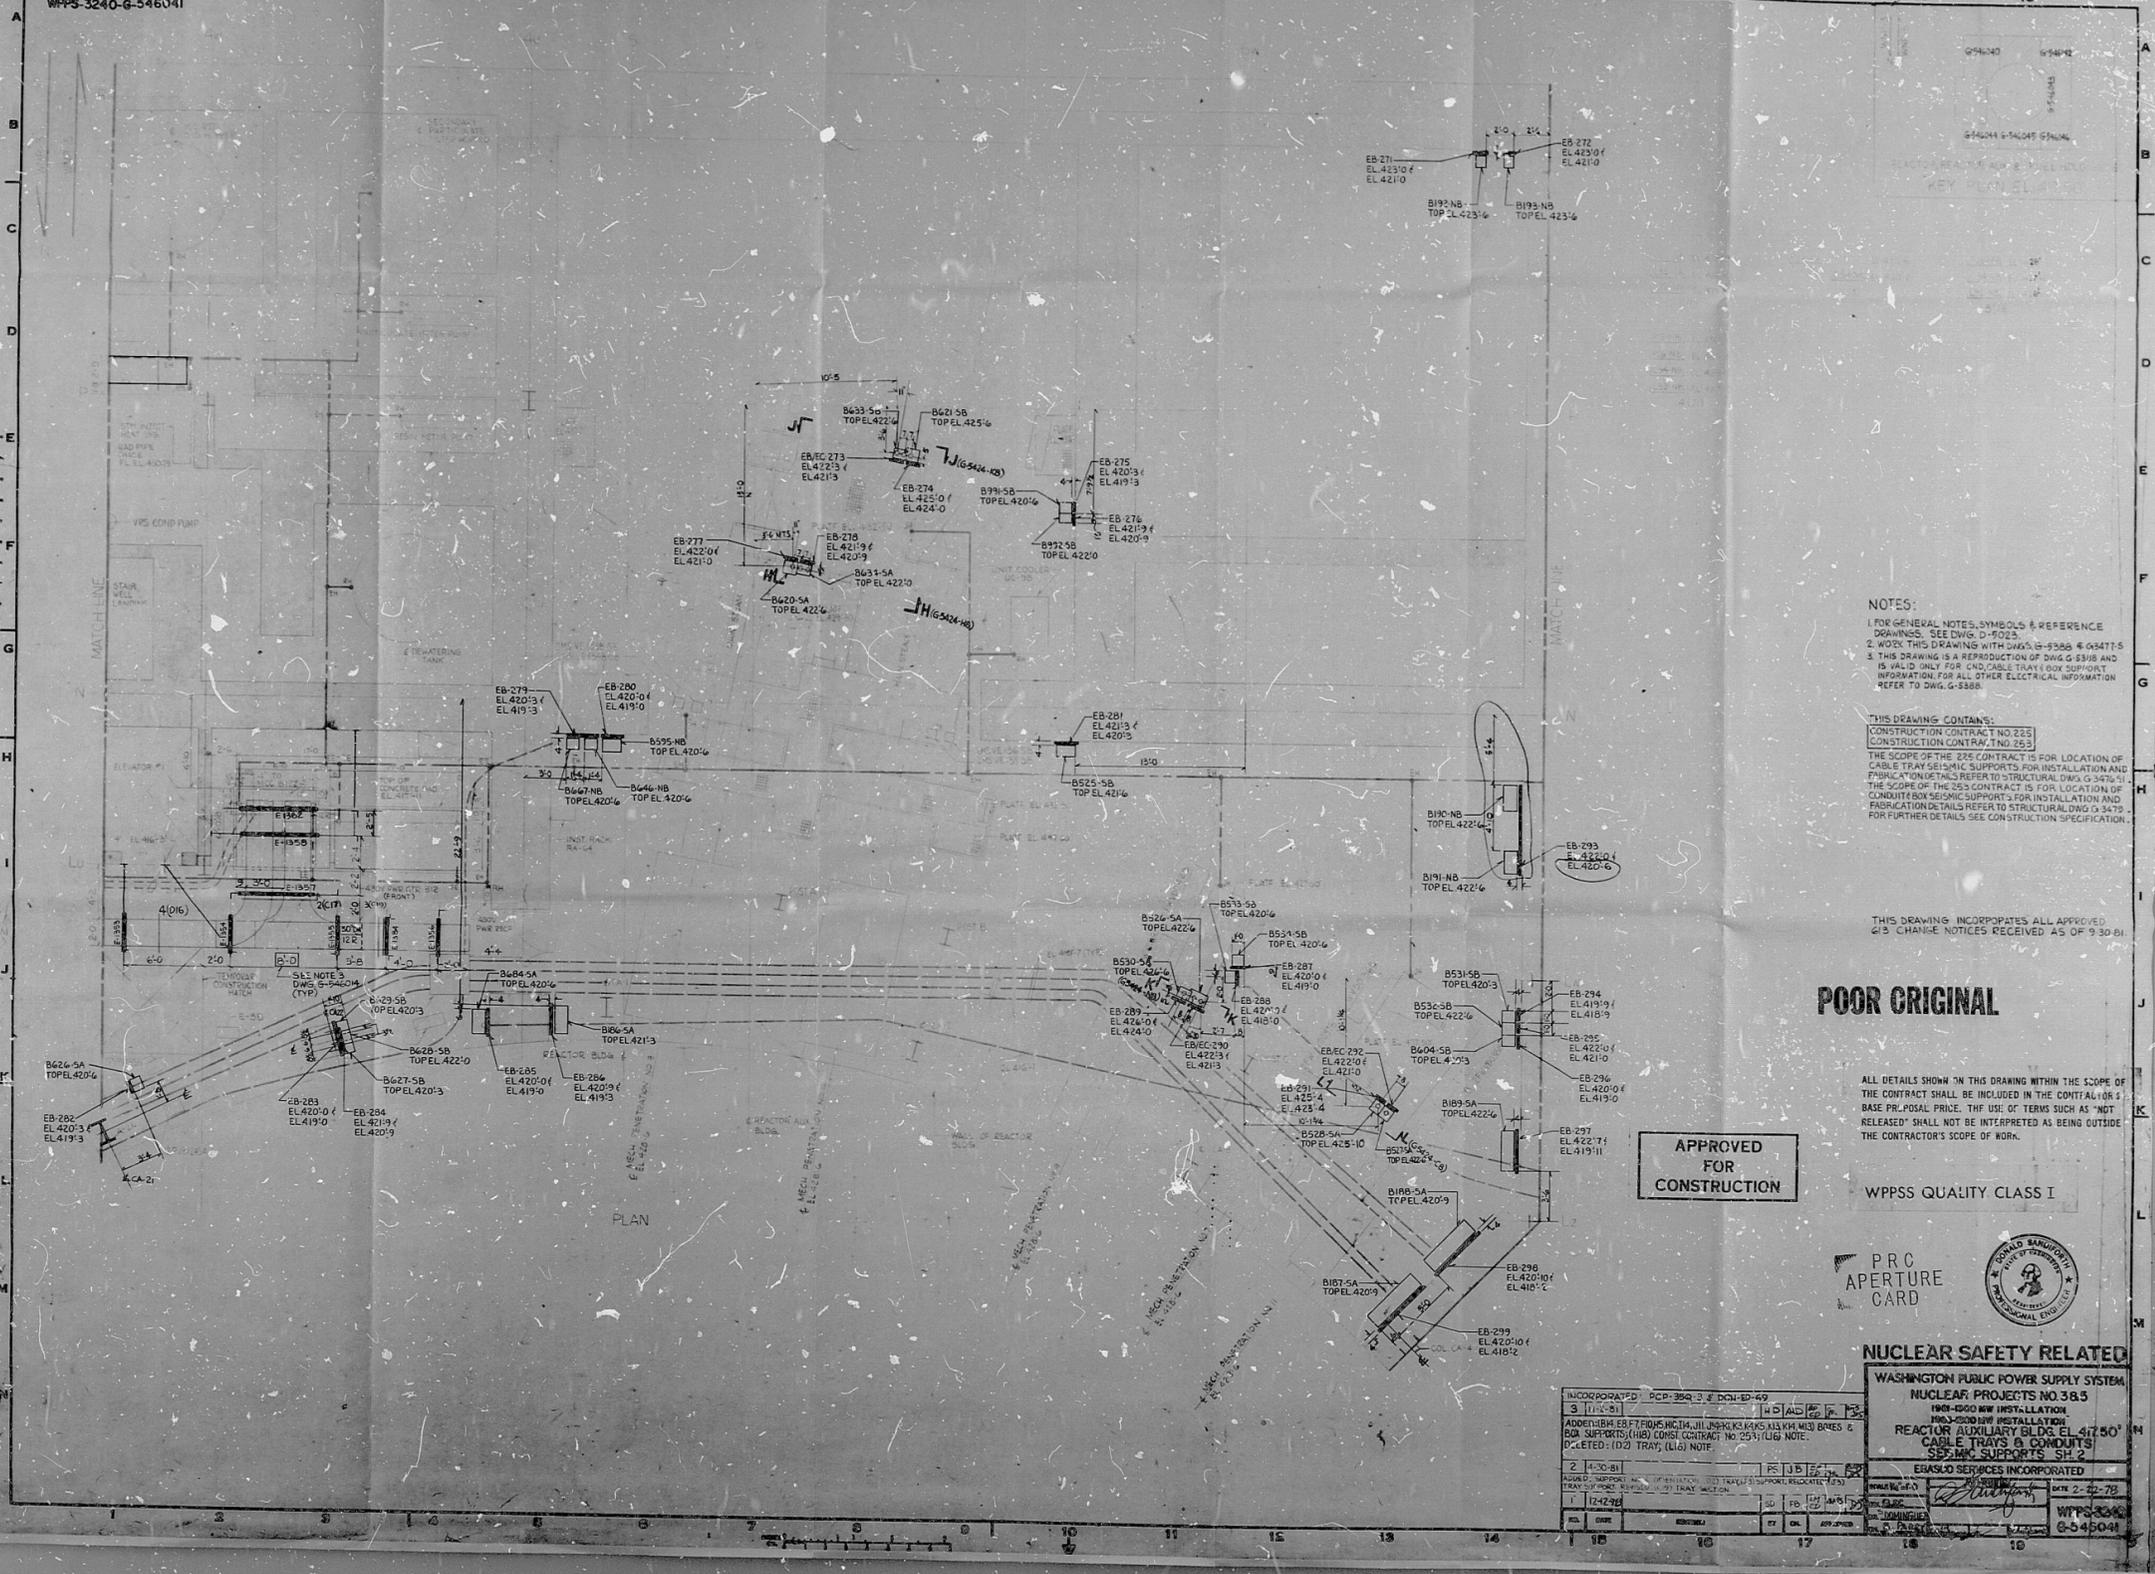

NOTES:
 1. FOR GENERAL NOTES, SYMBOLS & REFERENCE DRAWINGS, SEE DWG. D-7025.
 2. WORK THIS DRAWING WITH DWG. B-9388 & G-4347T-5.
 3. THIS DRAWING IS A REPRODUCTION OF DWG. G-5318 AND IS VALID ONLY FOR CND CABLE TRAY BOX SUPPORT INFORMATION. FOR ALL OTHER ELECTRICAL INFORMATION REFER TO DWG. G-5388.

THIS DRAWING CONTAINS:
 CONSTRUCTION CONTRACT NO. 225
 CONSTRUCTION CONTRACT NO. 253
 THE SCOPE OF THE 225 CONTRACT IS FOR LOCATION OF CABLE TRAY SEISMIC SUPPORTS FOR INSTALLATION AND FABRICATION DETAILS REFER TO STRUCTURAL DWG. G-5476. THE SCOPE OF THE 253 CONTRACT IS FOR LOCATION OF CONDUITE BOX SEISMIC SUPPORTS FOR INSTALLATION AND FABRICATION DETAILS REFER TO STRUCTURAL DWG. G-5475. FOR FURTHER DETAILS SEE CONSTRUCTION SPECIFICATION.

THIS DRAWING INCORPORATES ALL APPROVED G/S CHANGE NOTICES RECEIVED AS OF 9/30/81.

POOR ORIGINAL

ALL DETAILS SHOWN IN THIS DRAWING WITHIN THE SCOPE OF THE CONTRACT SHALL BE INCLUDED IN THE CONTRACTOR'S BASE PRICED PRICE. THE USE OF TERMS SUCH AS "NOT RELEASED" SHALL NOT BE INTERPRETED AS BEING OUTSIDE THE CONTRACTOR'S SCOPE OF WORK.

WPPS QUALITY CLASS I



NUCLEAR SAFETY RELATED

WASHINGTON PUBLIC POWER SUPPLY SYSTEM
 NUCLEAR PROJECTS NO. 38.5


REACTOR AUXILIARY BLDG. EL. 417.50'
 CABLE TRAYS & CONDUITS
 SEISMIC SUPPORTS SH. 2

EGASLO SERVICES INCORPORATED

DATE: 2-22-78

WPPS-3240-G-546041

APPROVED FOR CONSTRUCTION

INCORPORATED:	PCP-389-3 & D-ED-49
3 (REV. 81)	10/15/81

DATE: 2-22-78	
WPPS-3240-G-546041	

RIDS

8303290614

