

34

34

22

22

17

17

11

11

8.5

8.5

8.5

8.5

11


11

17

17

22

22

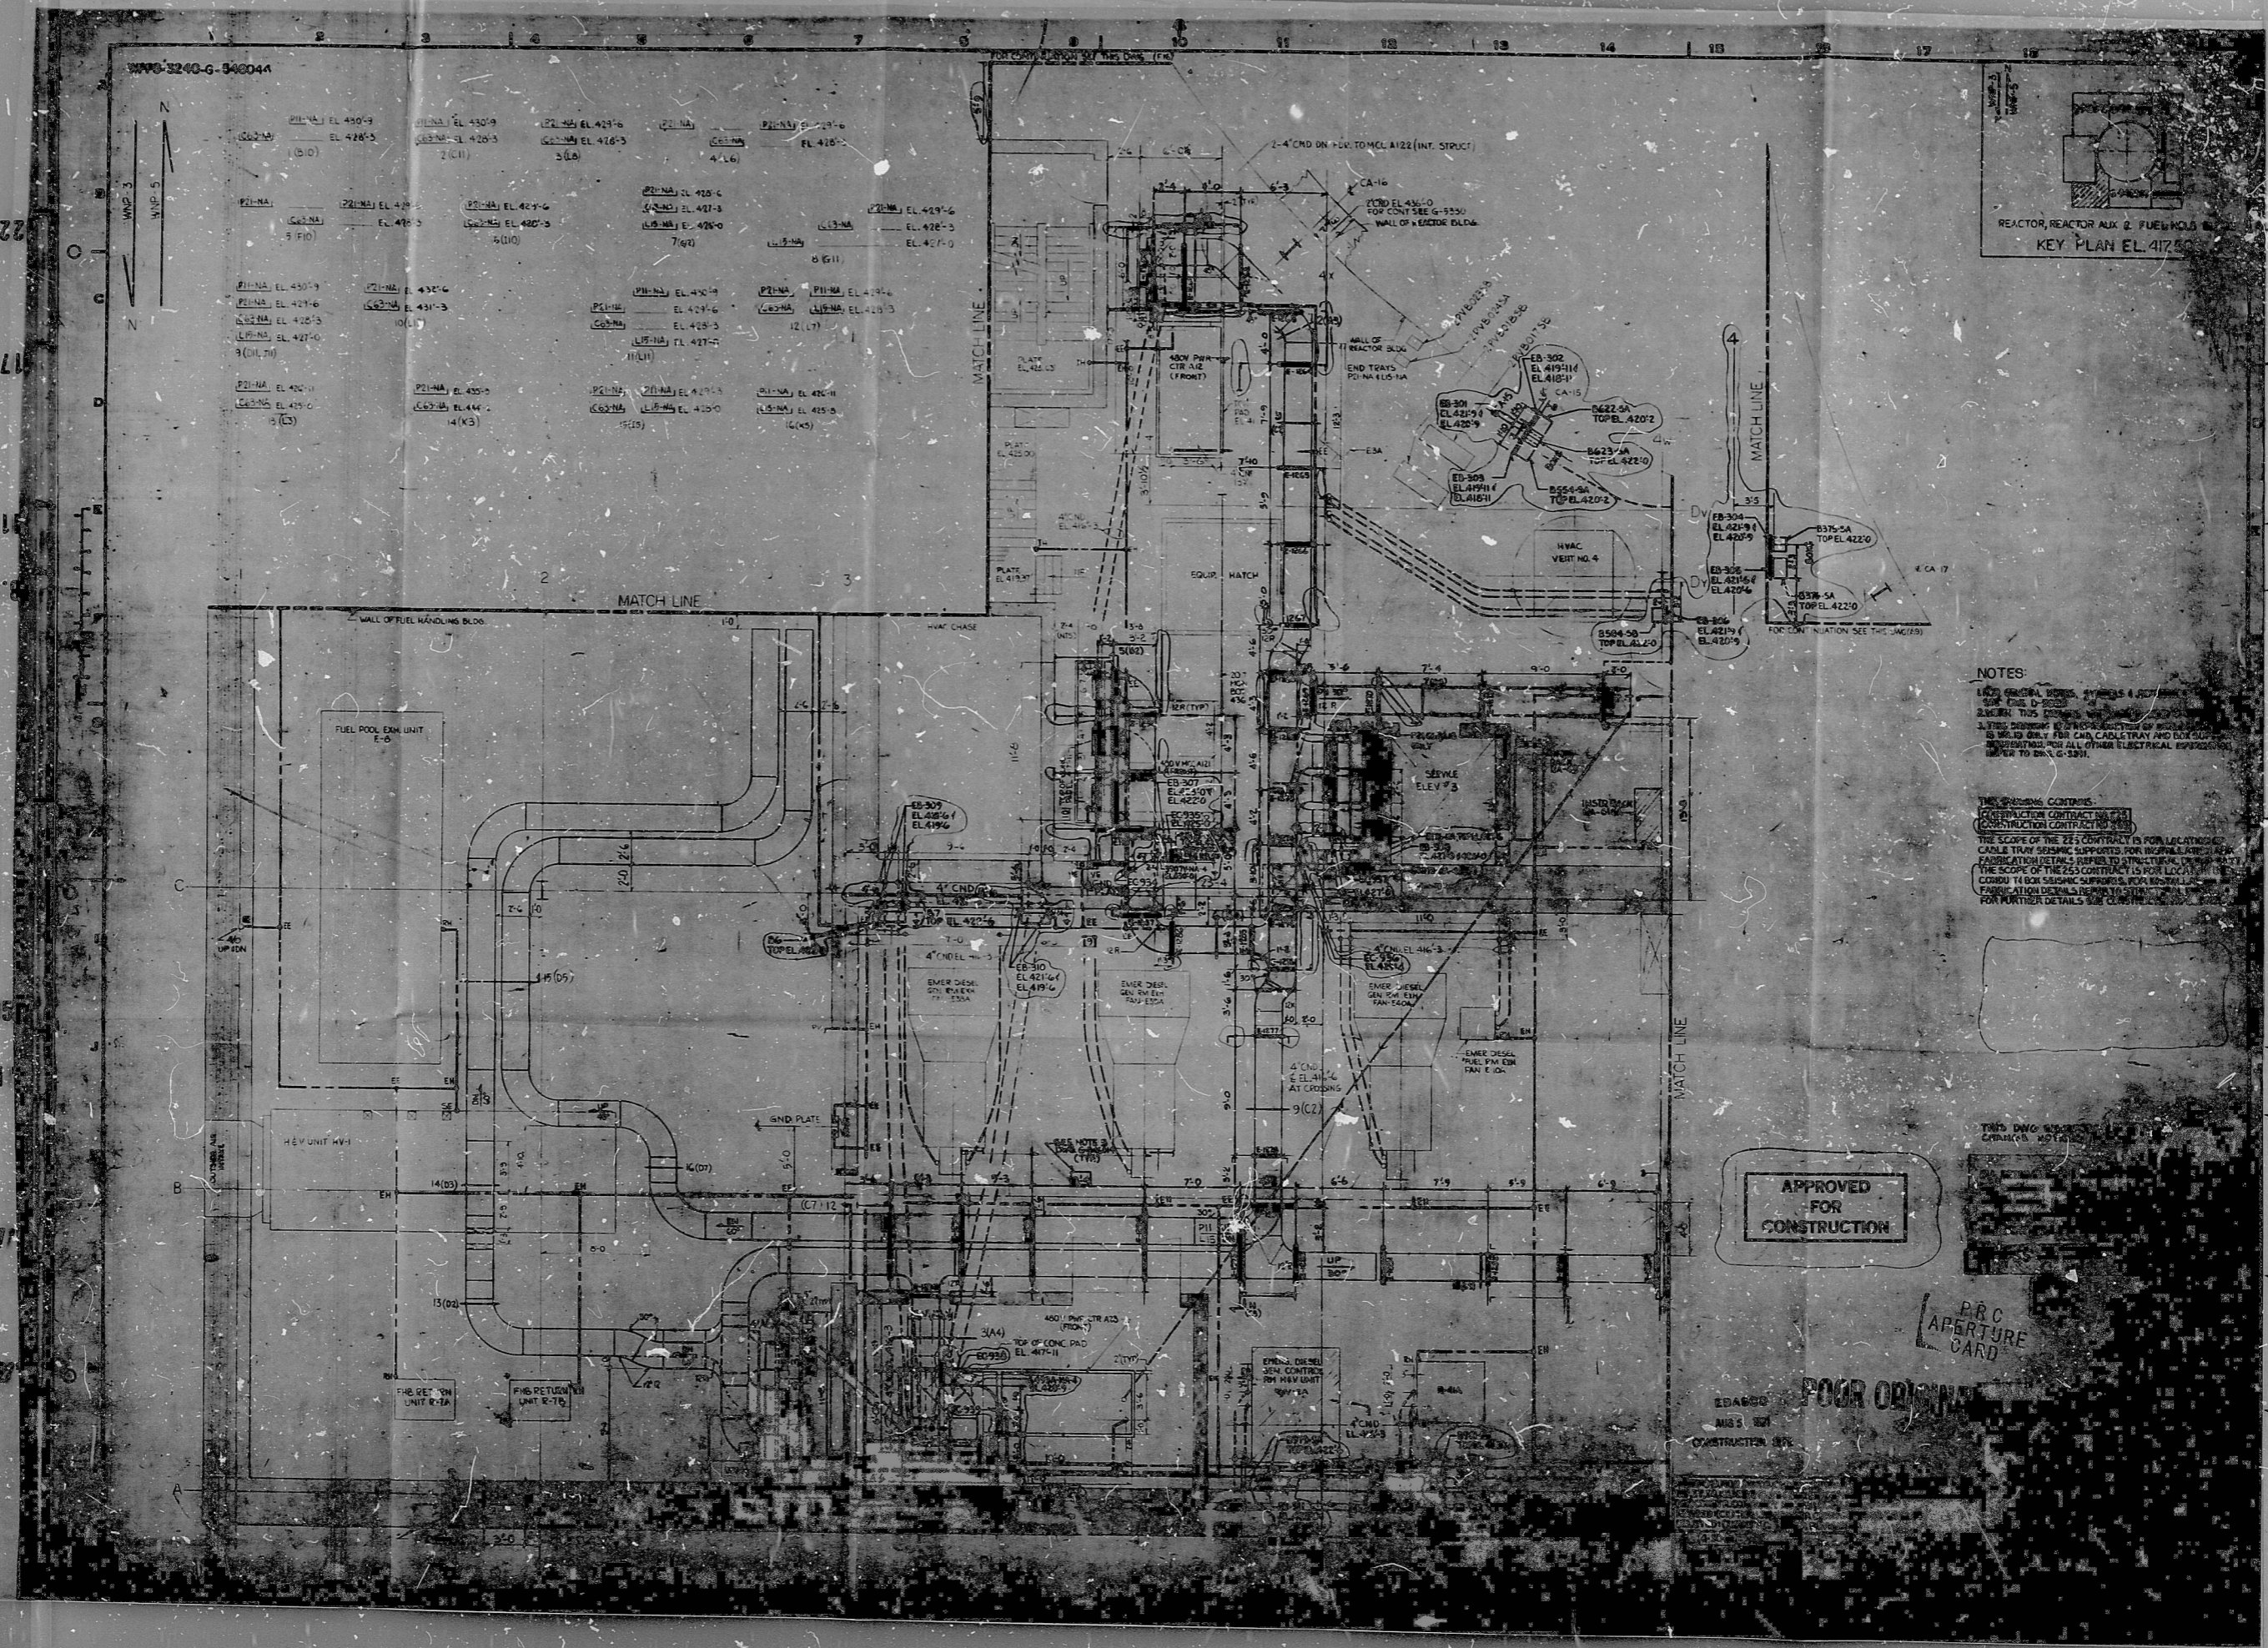

WWW-3240-G-540044




PI-NA EL. 430-9 (6)(D)	PI-NA EL. 430-9 (6)(D)	PI-NA EL. 423-6 (2)(H)	PI-NA EL. 423-6 (3)(A)	PI-NA EL. 423-6 (4)(L)	PI-NA EL. 423-6 (4)(L)

NOTES

1. SEE GENERAL NOTES, SHEETS 4 AND 5 OF THIS DRAWING FOR CONSTRUCTION CONTRACT NO. 225.

APPROVED FOR CONSTRUCTION

P.R.C. APERTURE CARD


ED:AGG
MSS:SP
CONSTRUCTION

RIDS

8303290619

