
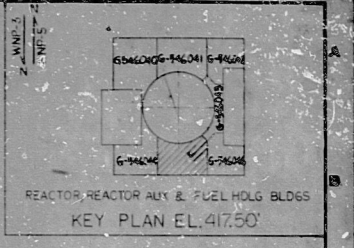



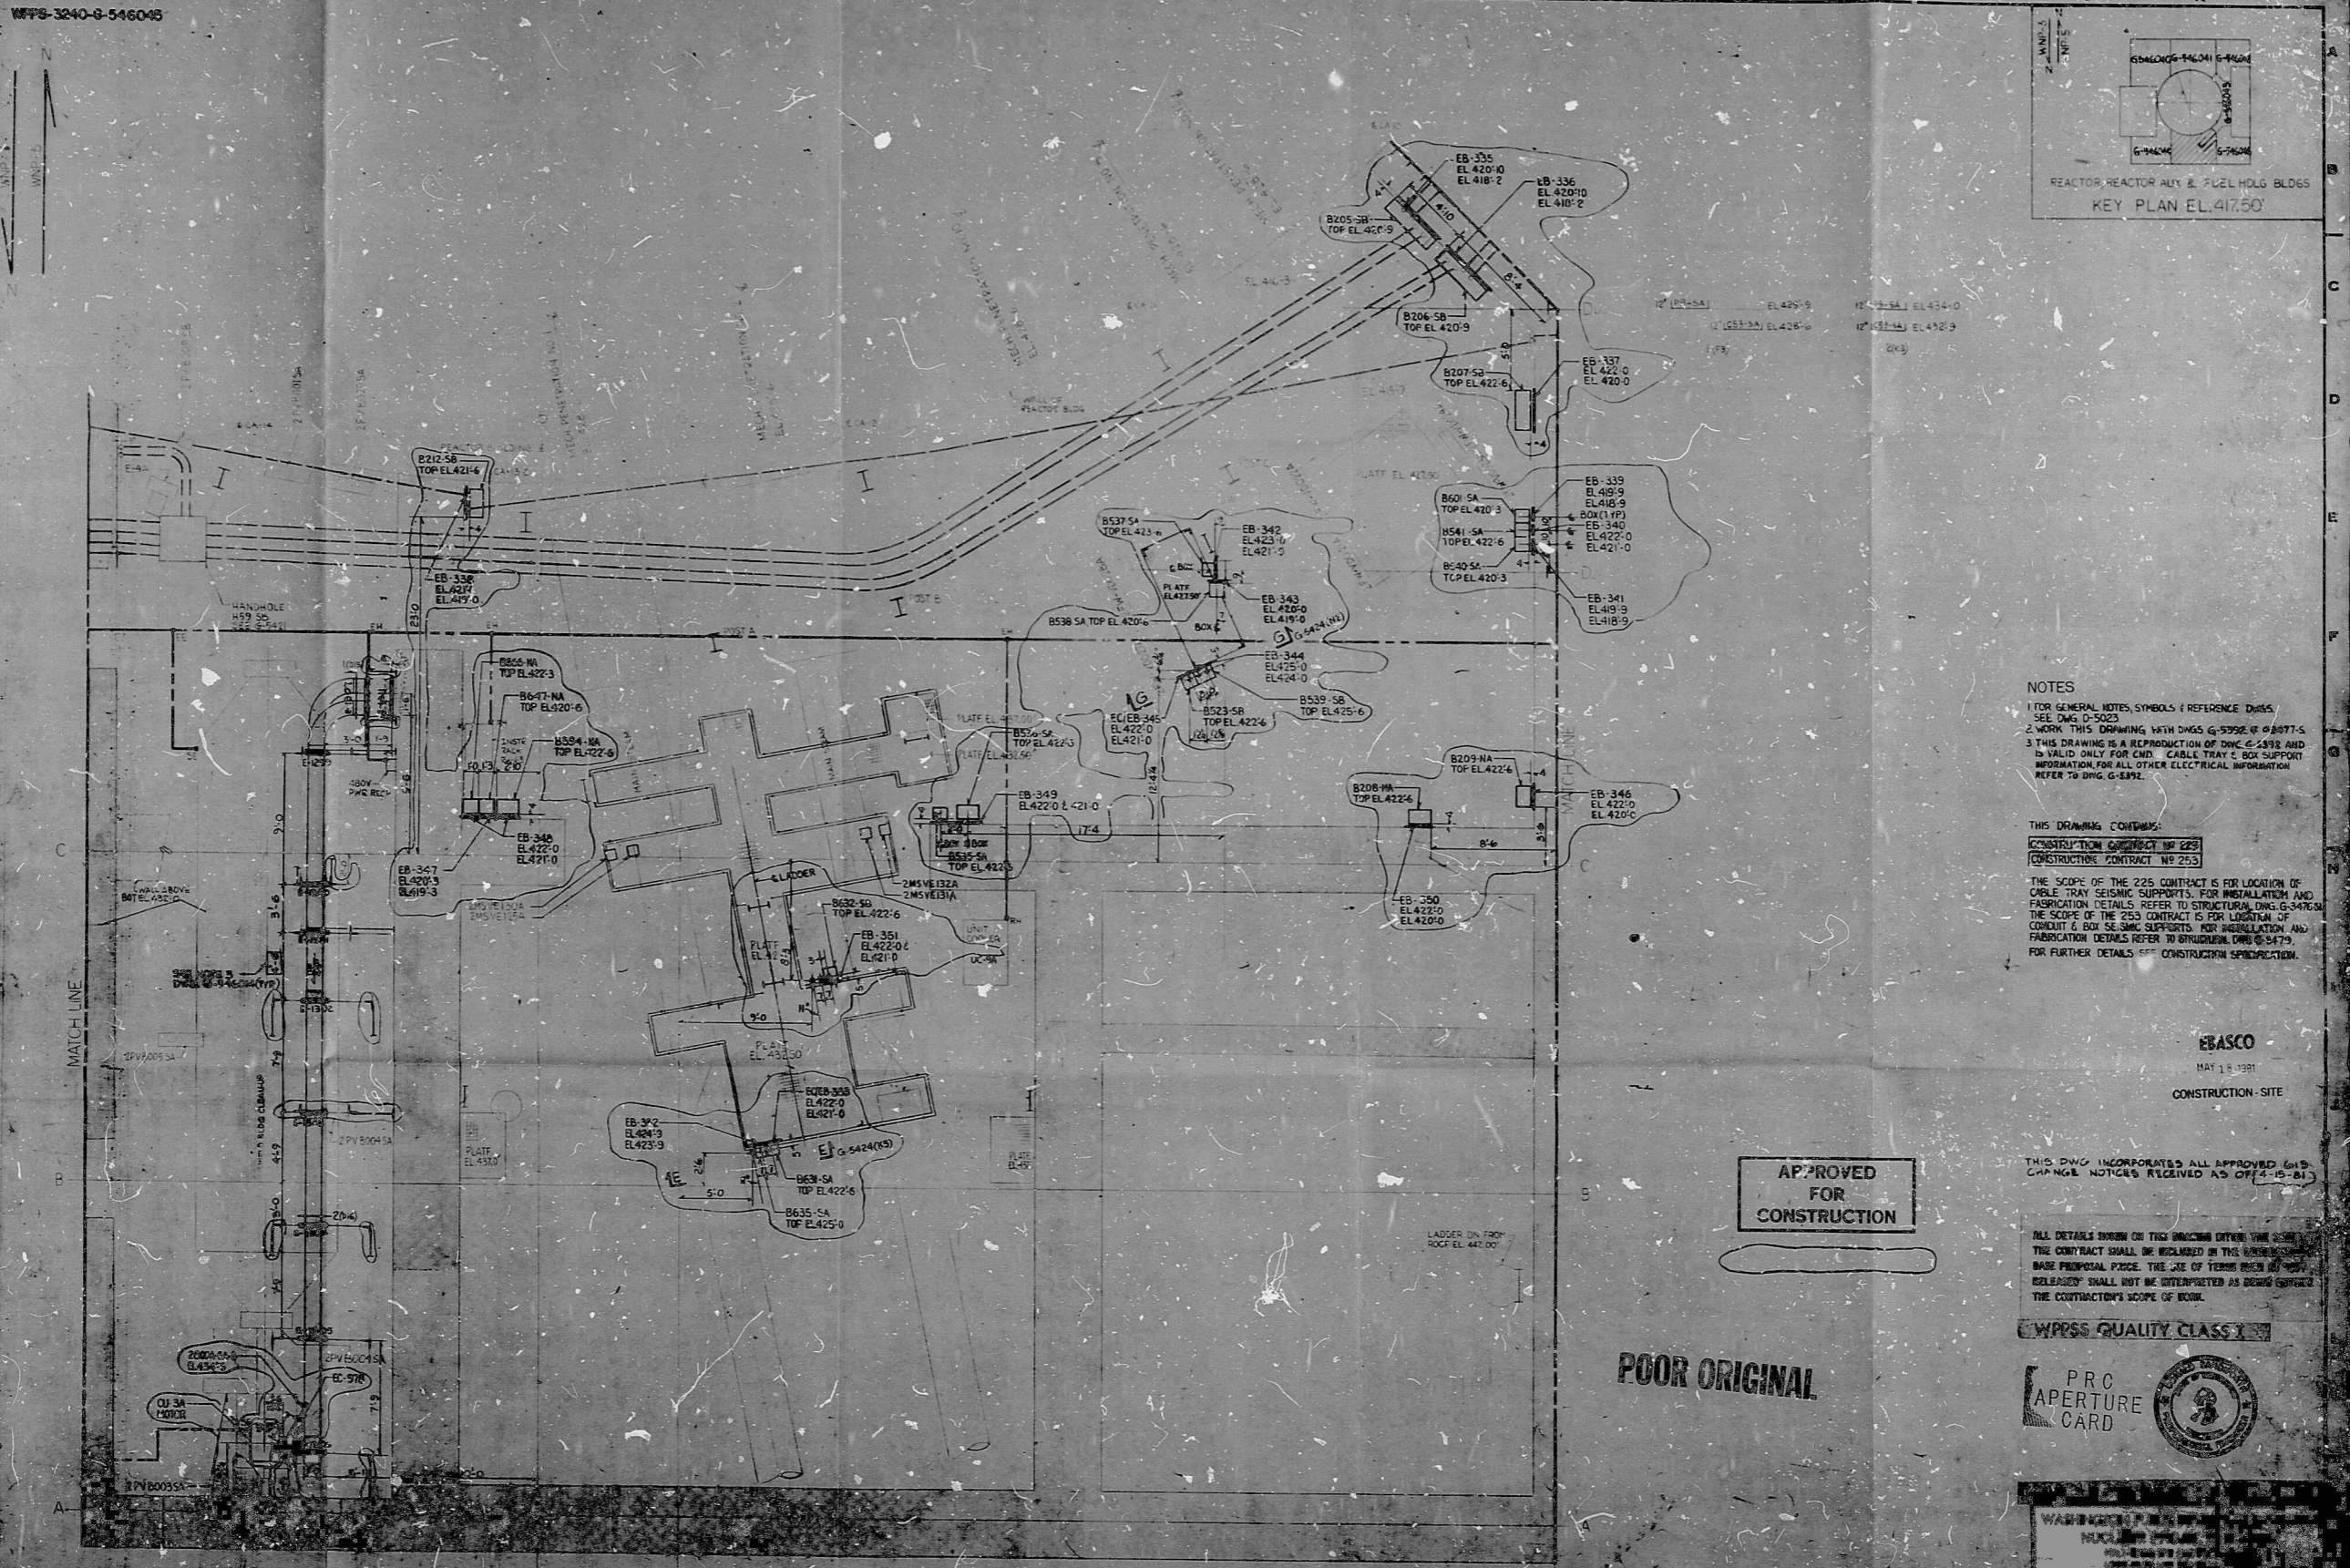

- NOTES
1. FOR GENERAL NOTES, SYMBOLS & REFERENCE DIMS. SEE DWG. G-5023.

THIS DRAWING CONTAINS:
 CONSTRUCTION CONTRACT NO. 225
 CONSTRUCTION CONTRACT NO. 253

THE SCOPE OF THE 225 CONTRACT IS FOR LOCATION OF CABLE TRAY SEISMIC SUPPORTS FOR INSTALLATION AND FABRICATION DETAILS REFER TO STRUCTURAL DWG. G-3476. THE SCOPE OF THE 253 CONTRACT IS FOR LOCATION OF CONDUIT & BOX SEISMIC SUPPORTS FOR INSTALLATION AND FABRICATION DETAILS REFER TO STRUCTURAL DWG. G-3479. FOR FURTHER DETAILS SEE CONSTRUCTION SPECIFICATION.

EBASCO
 MAY 1 8 1981
 CONSTRUCTION-SITE

APPROVED FOR CONSTRUCTION

POOR ORIGINAL

THIS DWG INCORPORATES ALL APPROVED CHG. CHANGE NOTICES RECEIVED AS OF 4-15-81



WPPSS QUALITY CLASS 1





RIDS

8303290621

